PARENT PARCEL: 01-00-056-000-035, -091

CHILD PARCEL: 01-00-056-000-092 THRU -094

STARTING POINT: INTERSECTION OF C/L OF MIDDLE RIDGE RD. AND WEST LINE OF O.L. 56

19-04075

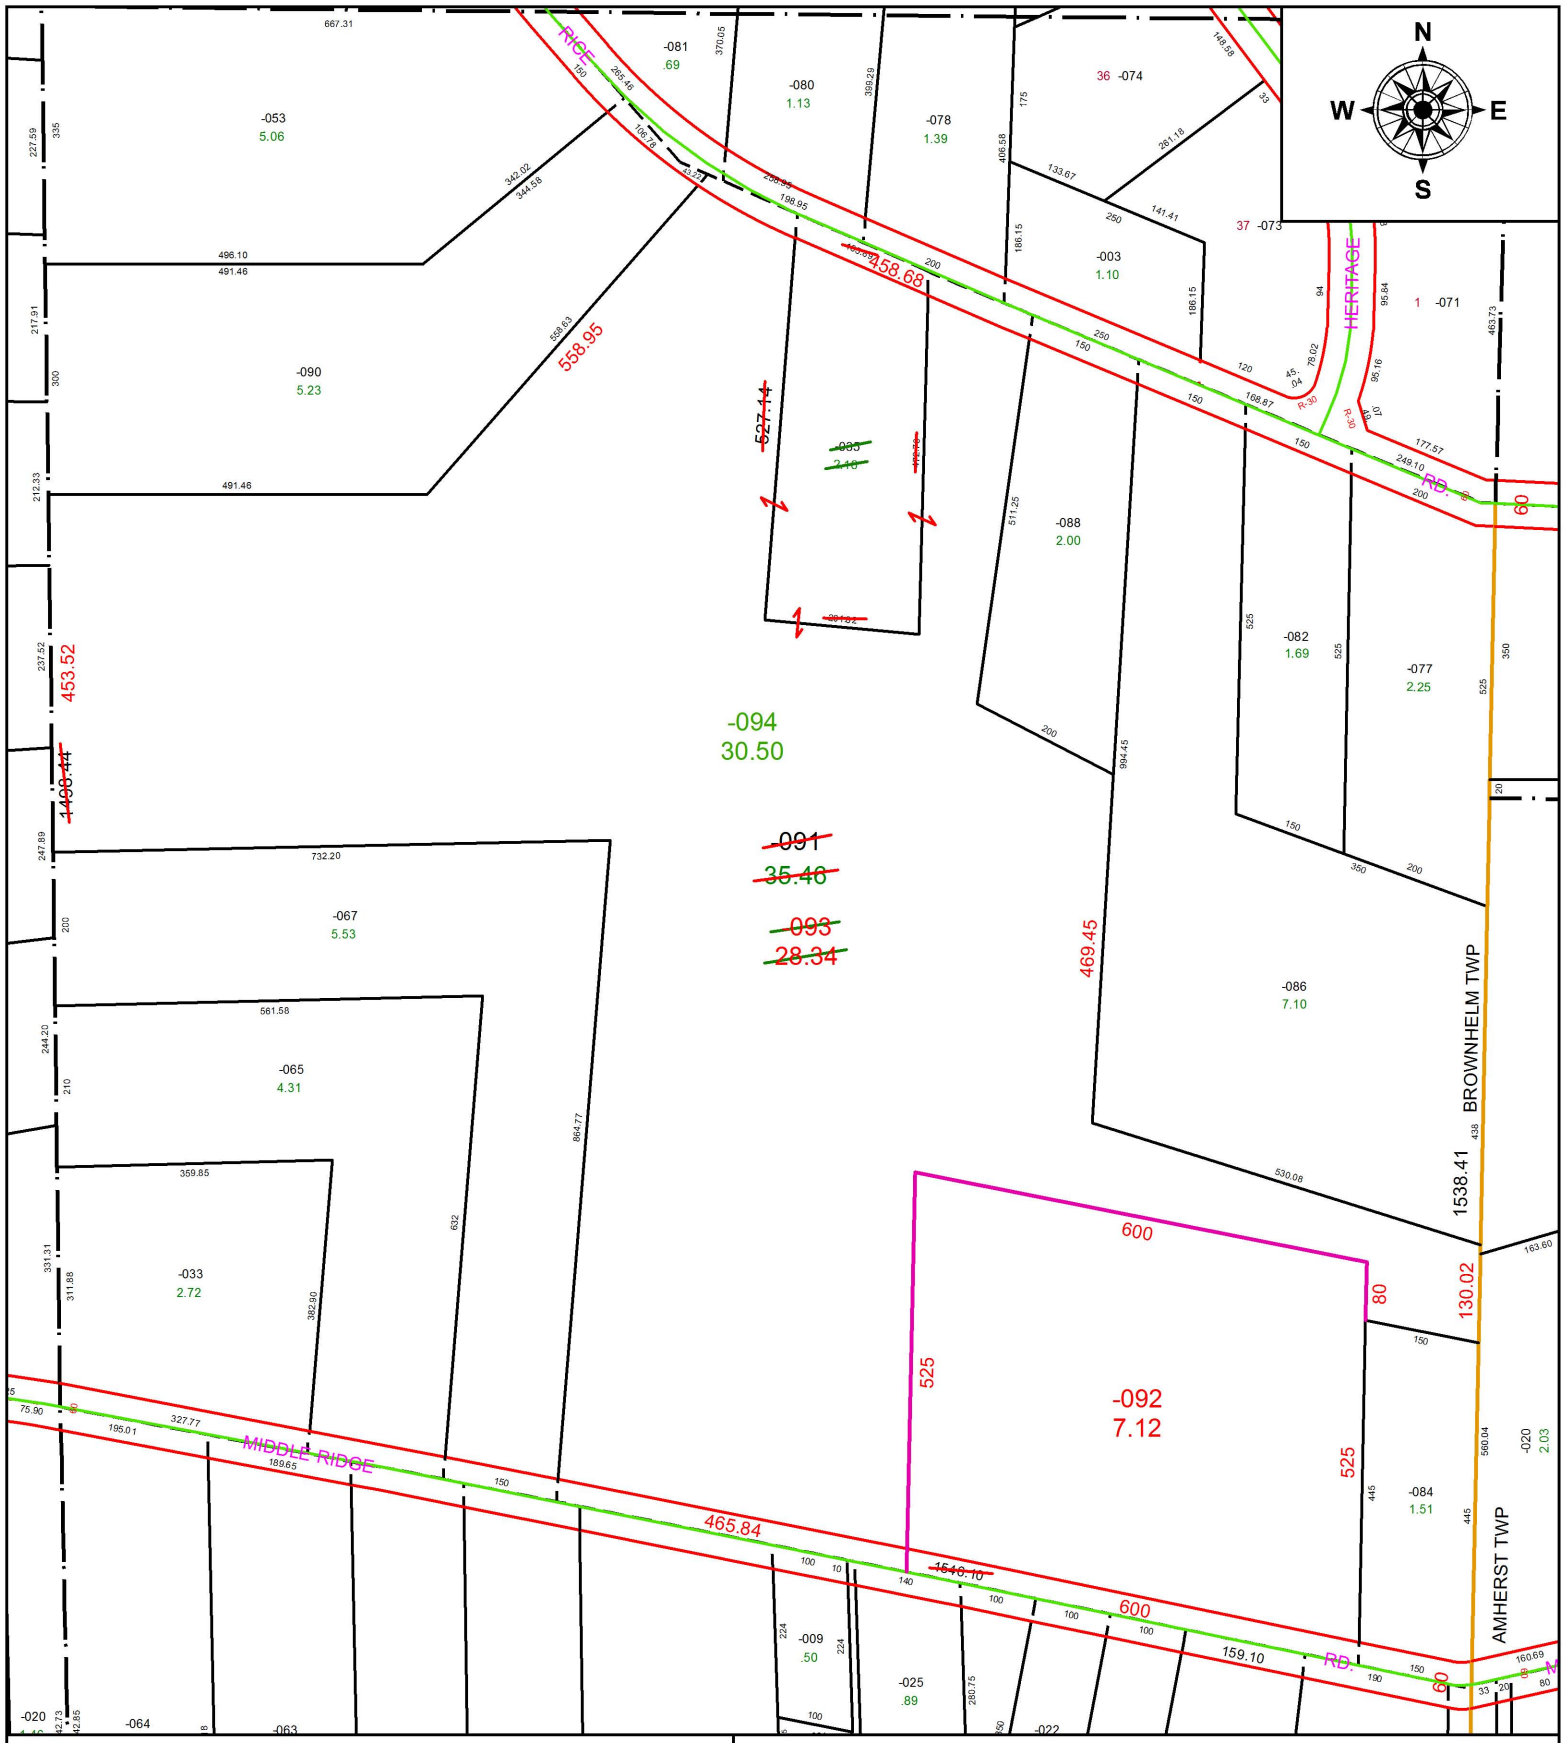

SPLITS/DEEDS PROCESSED

LORAIN COUNTY TAX MAP DEPARTMENT
226 MIDDLE AVE. ELYRIA, OH

SURVEYED BY: THOMAS A. SIMON
CLOSURE: 1:884,632
MAP PAGE(S): 1-00-056
APPOVED BY: RRM **DATE:** 1-2-20
SCALE: 1" = 250 **PRIOR INSTRUMENT:** 20110371456