PARENT PARCEL: 10-00-006-126-004

CHILD PARCEL:

STARTING POINT: STATION 4+69.43 ON ROBSON RD. DED. PLAT

19-04076-C

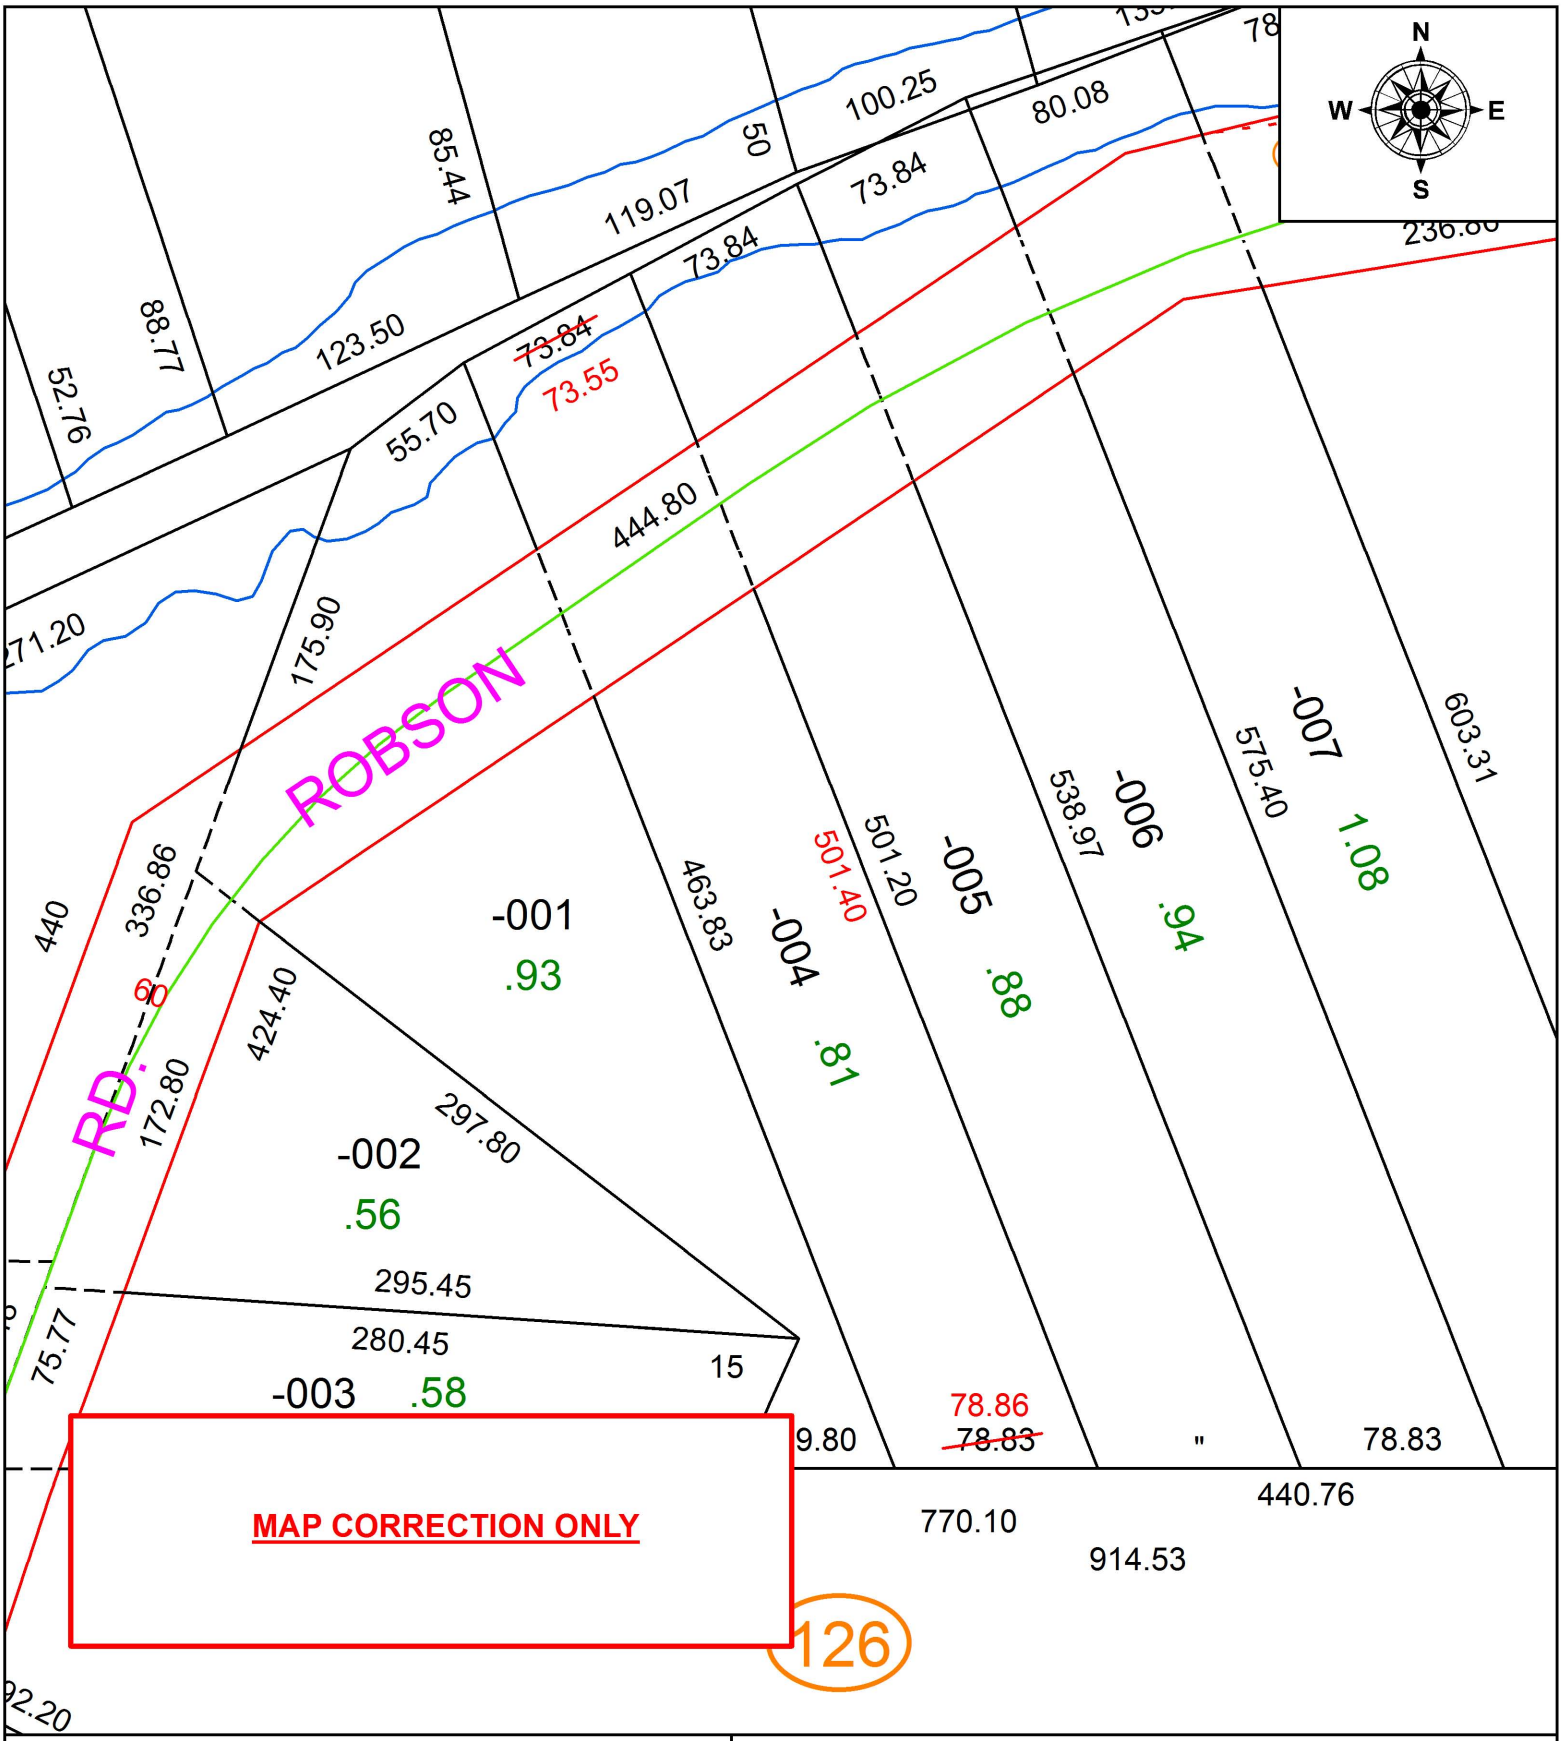

SPLITS/DEEDS PROCESSED

LORAIN COUNTY TAX MAP DEPARTMENT
226 MIDDLE AVE. ELYRIA, OH

SURVEYED BY: THOMAS A. SIMON
CLOSURE: 1: 468,838
MAP PAGE(S): 10-00-006
APPOVED BY: RRM **DATE:** 4-25-19
SCALE: 1" = 75 **PRIOR INSTRUMENT:** 20170654691