PARENT PARCEL: 01-00-056-000-092

CHILD PARCEL: 01-00-056-000-095 THRU -098

STARTING POINT: INTERSECTION OF C/L OF MIDDLE RIDGE RD. AND WEST LINE OF O.L.56

20-04080

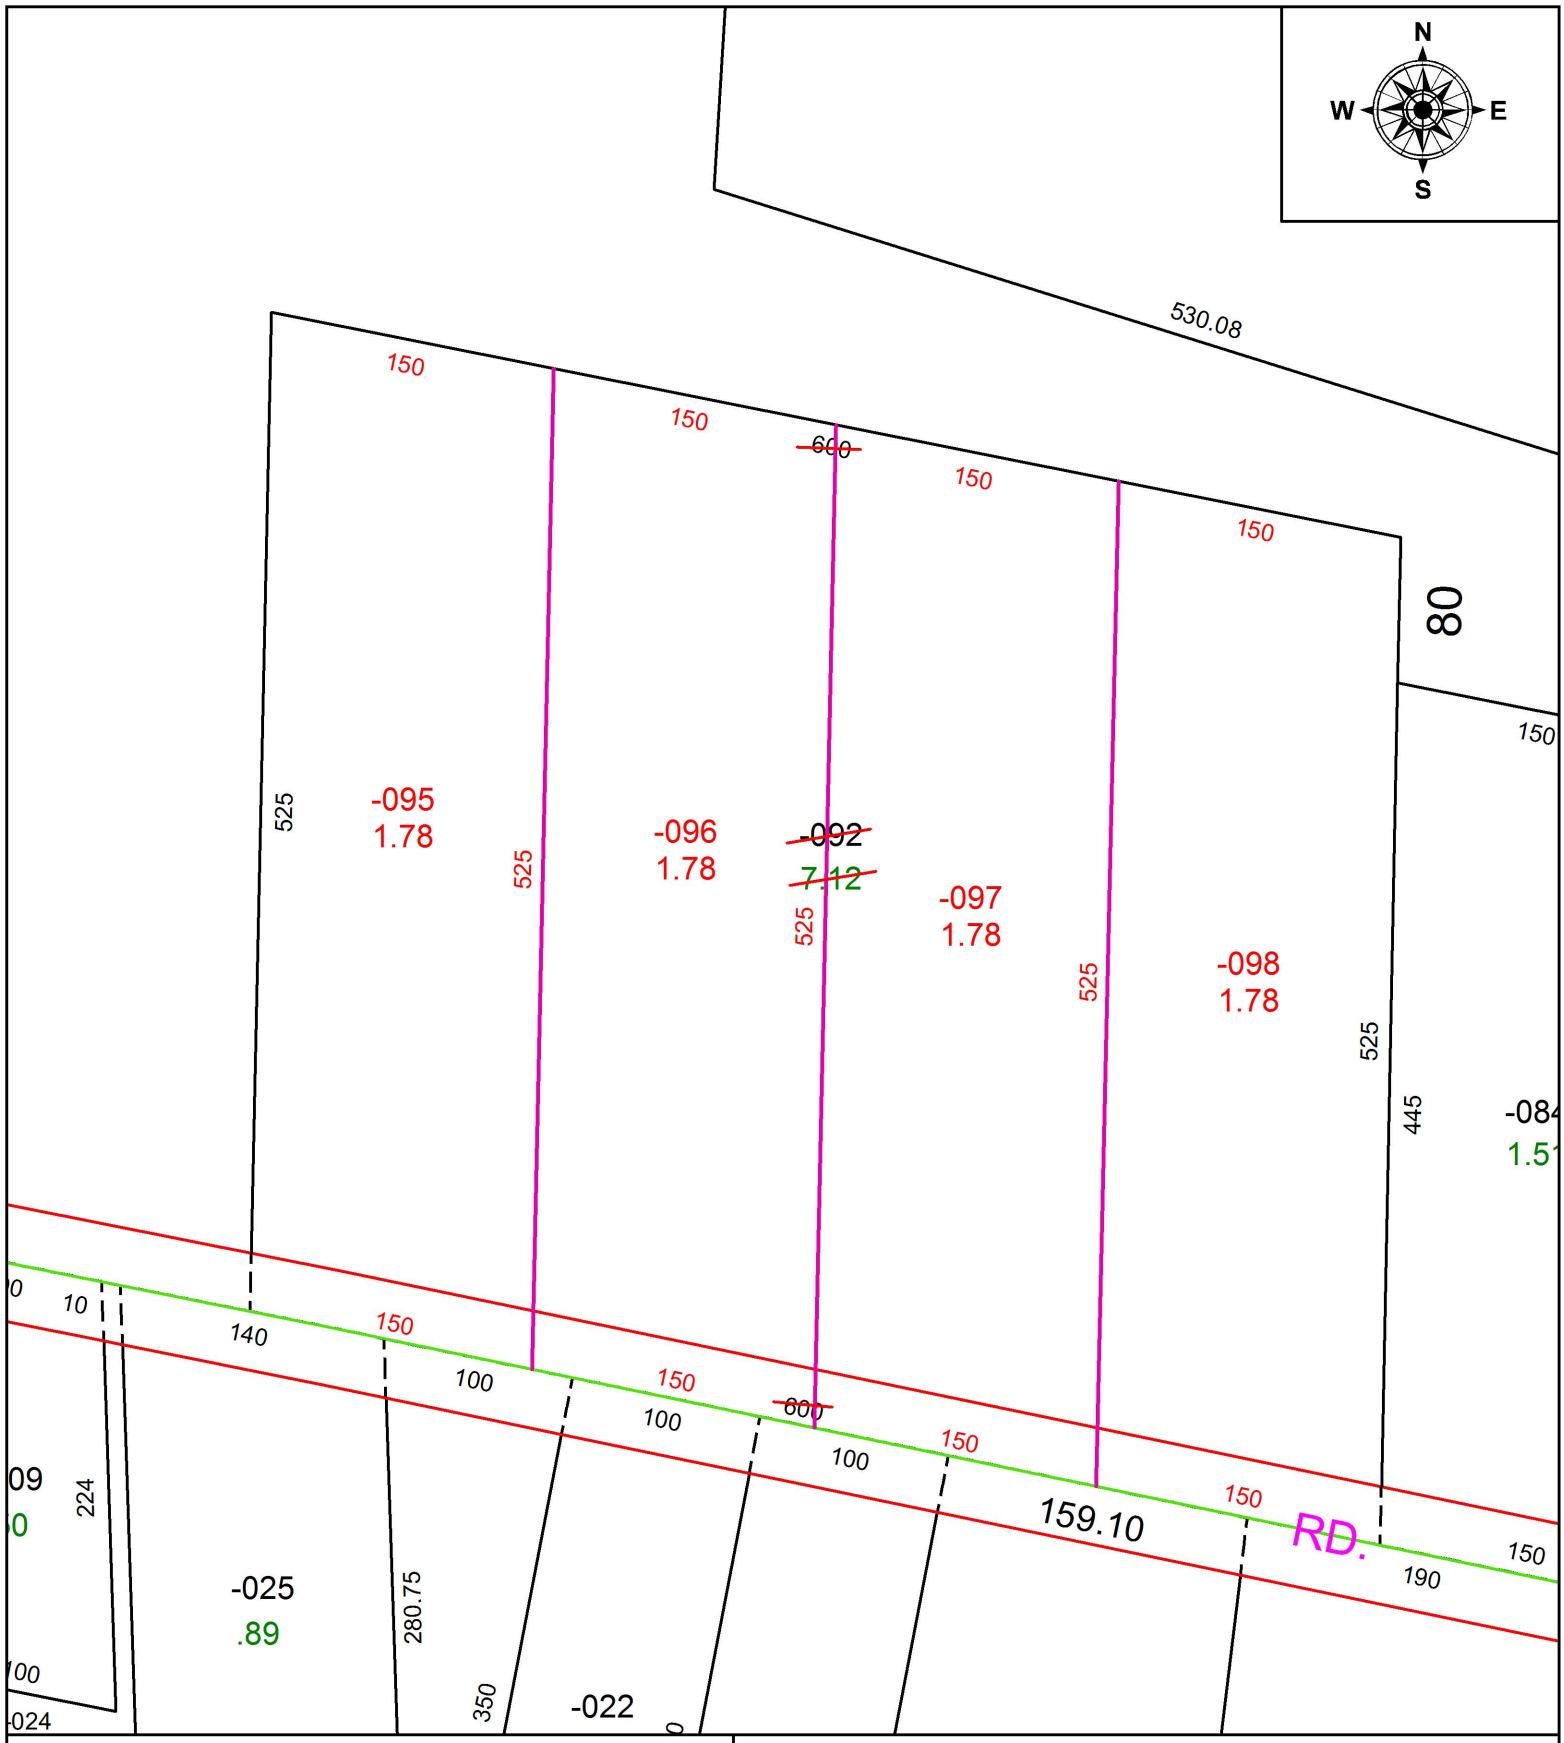

SPLITS/DEEDS PROCESSED

LORAIN COUNTY TAX MAP DEPARTMENT
226 MIDDLE AVE. ELYRIA, OH

SURVEYED BY: THOMAS A, SIMON
CLOSURE: 1:2147483648
MAP PAGE(S): 1-00-056
APPOVED BY: RRM **DATE:** 1-14-20
SCALE: 1" = 100 **PRIOR INSTRUMENT:** 20200744202