PARENT PARCEL: 16-00-087-000-014, -018

CHILD PARCEL: 16-00-087-000-020 THRU -022

STARTING POINT: SOUTHEAST CORNER OF O.L.87

20-04082

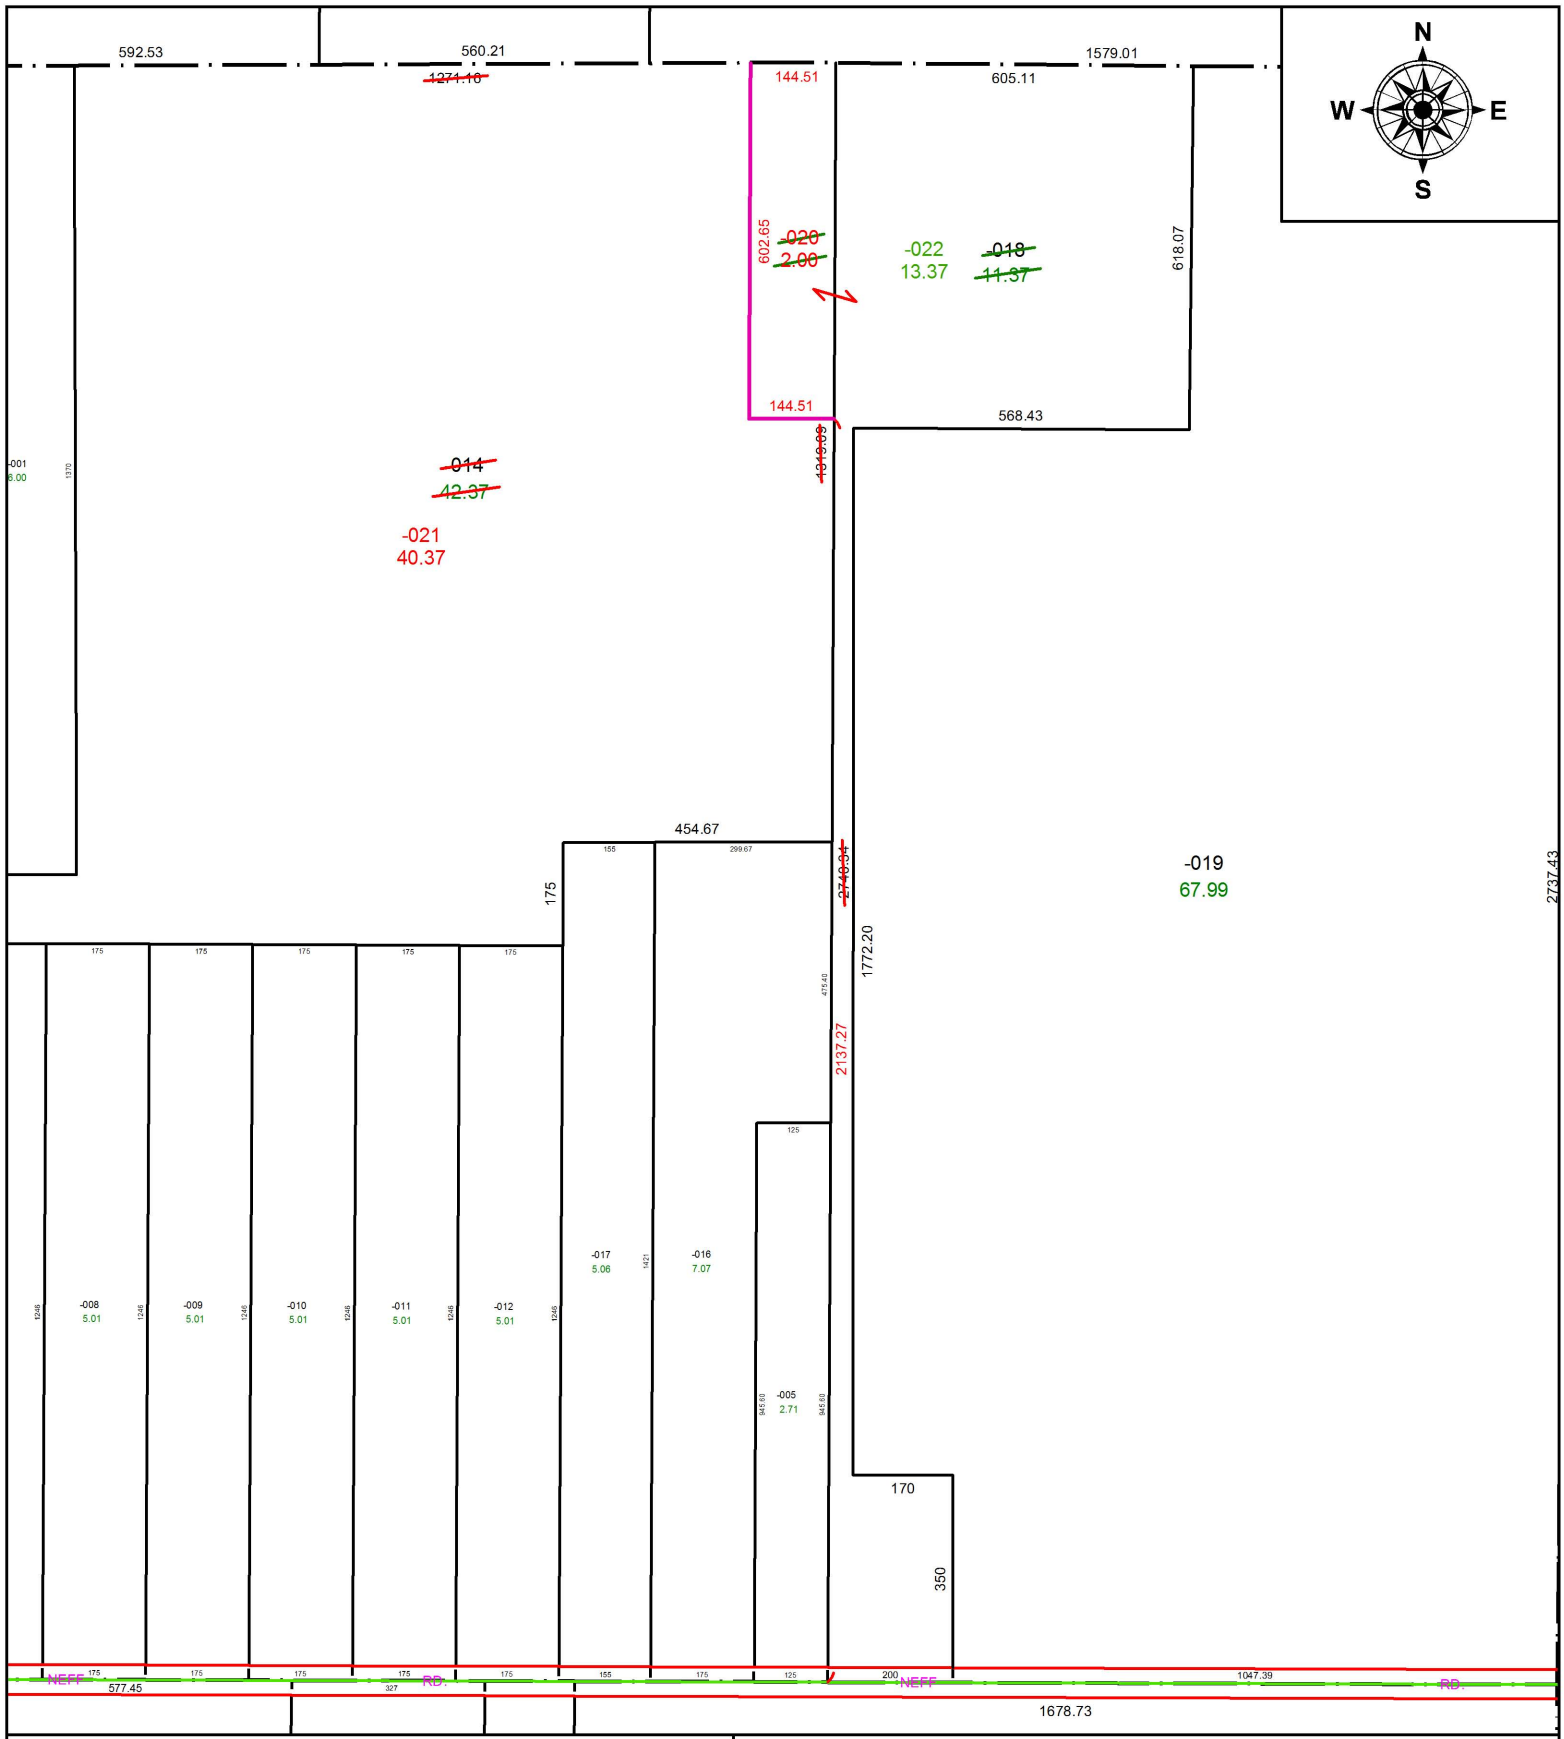

SPLITS/DEEDS PROCESSED

LORAIN COUNTY TAX MAP DEPARTMENT
226 MIDDLE AVE. ELYRIA, OH

SURVEYED BY: BRENT D, ANDERSON
CLOSURE: 1:644,290
MAP PAGE(S): 16-00-087
APPOVED BY: RRM **DATE:** 1-21-20
SCALE: 1" = 325 **PRIOR INSTRUMENT:** 20180698648