PARENT PARCEL: 07-00-041-000-008, -027, -033

CHILD PARCEL: 07-00-041-000-078, -079

STARTING POINT: INTERSECTION OF C/L OF OTTEN RD. AND WEST LINE OF O.L.41

20-04084

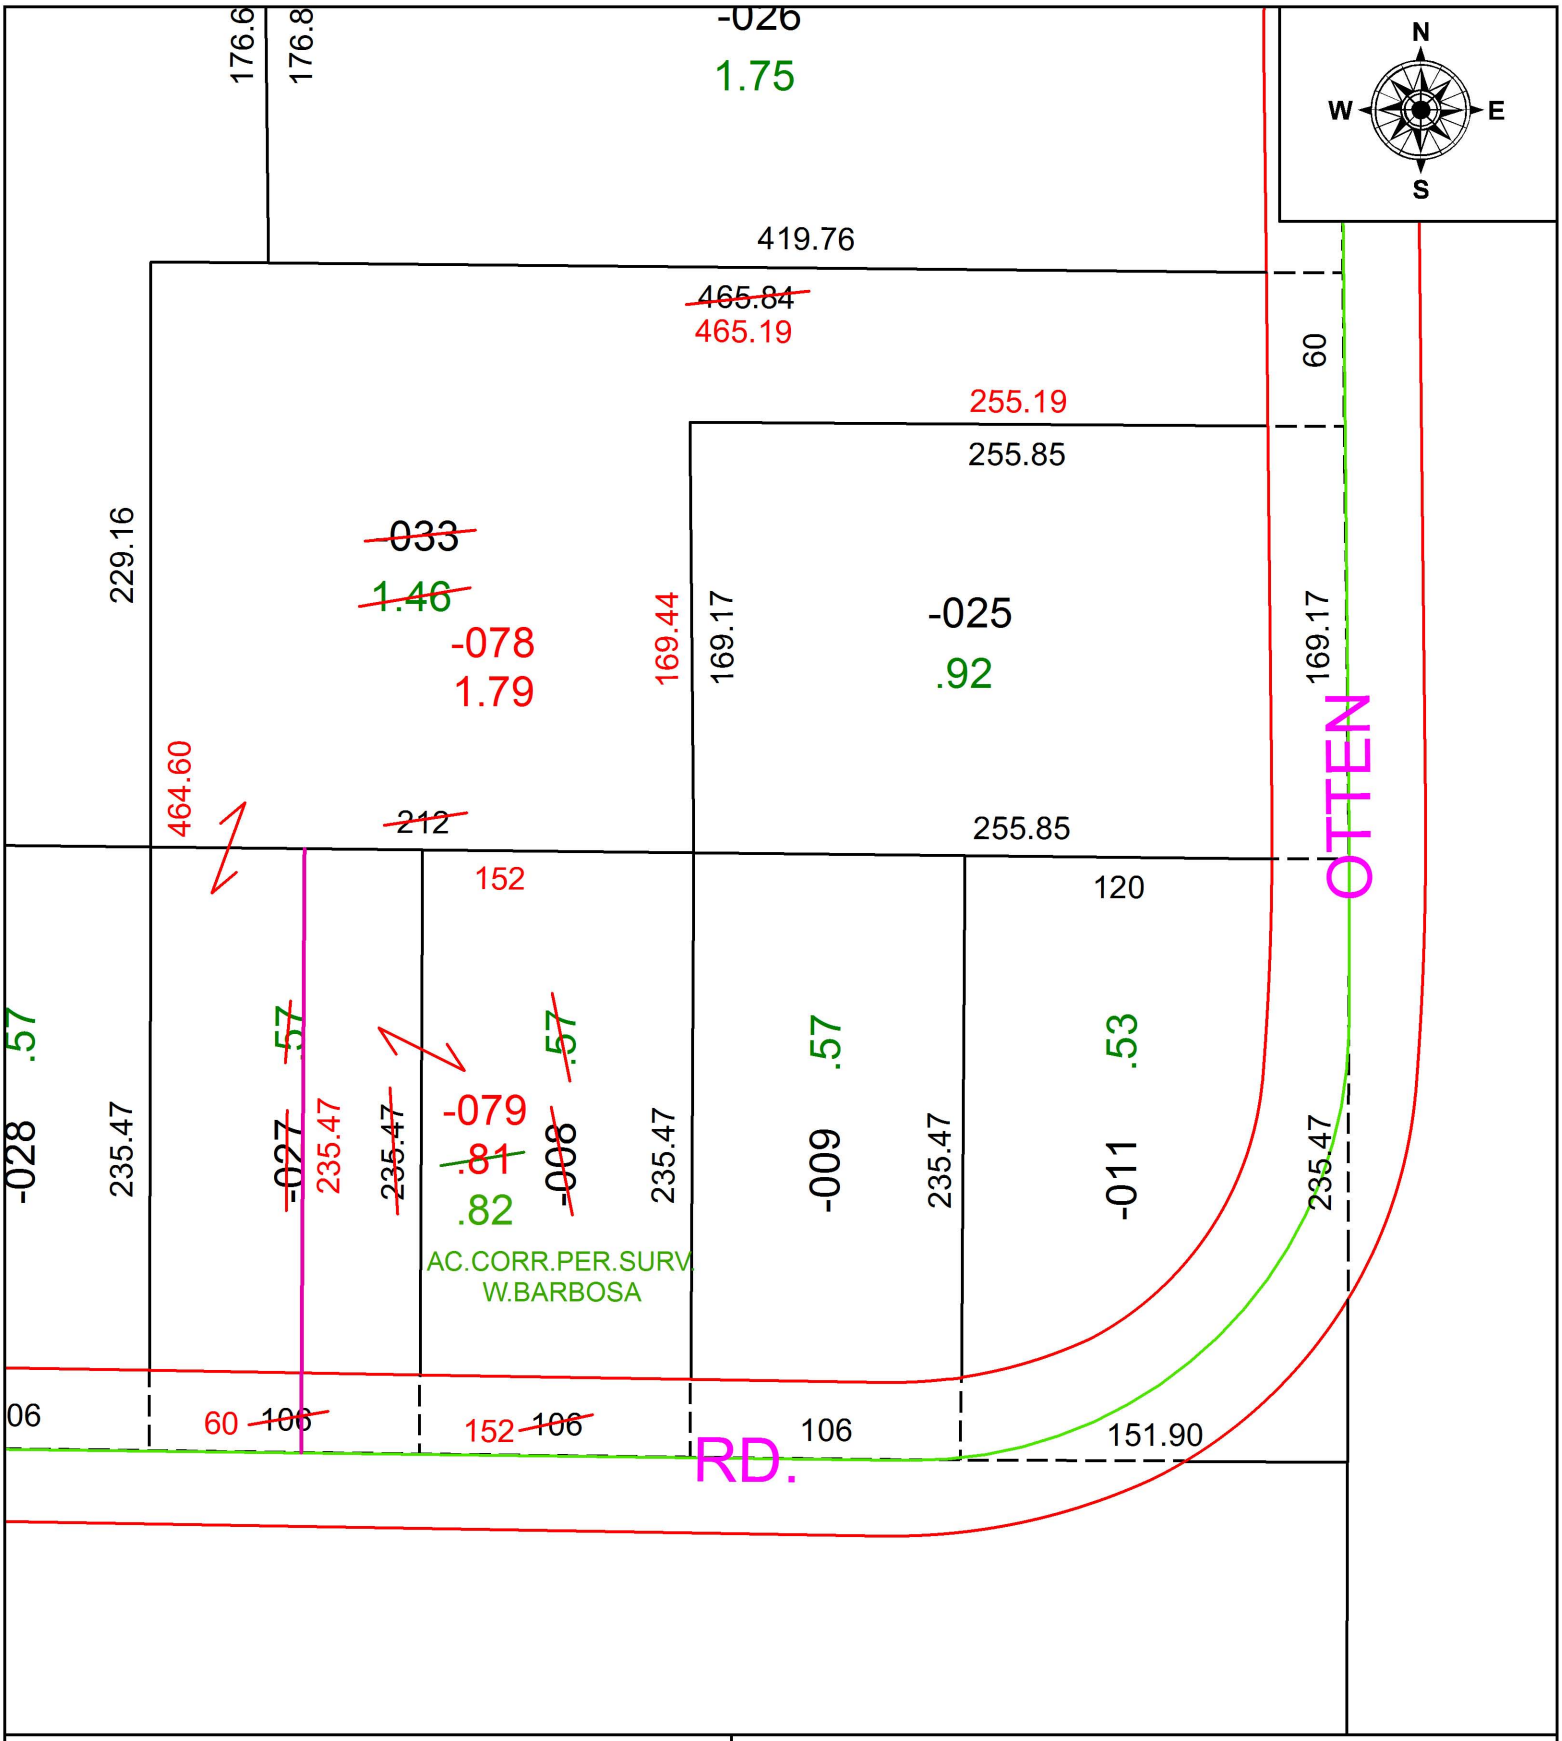

SPLITS/DEEDS PROCESSED

LORAIN COUNTY TAX MAP DEPARTMENT
226 MIDDLE AVE. ELYRIA, OH

SURVEYED BY: WILFREDO BARBOSA
CLOSURE: 1:199,691
MAP PAGE(S): 7-00-041
APPOVED BY: RRM **DATE:** 1-22-20
SCALE: 1" = 75 **PRIOR INSTRUMENT:** 20190712755