PARENT PARCEL: 04-00-030-103-012, -013, -014

CHILD PARCEL: 04-00-030-103-014, -045

STARTING POINT: INTERSECTION OF C/L OF NORTH POINT DR. EX. AND C/L OF LAKE RD.

19-04085-D

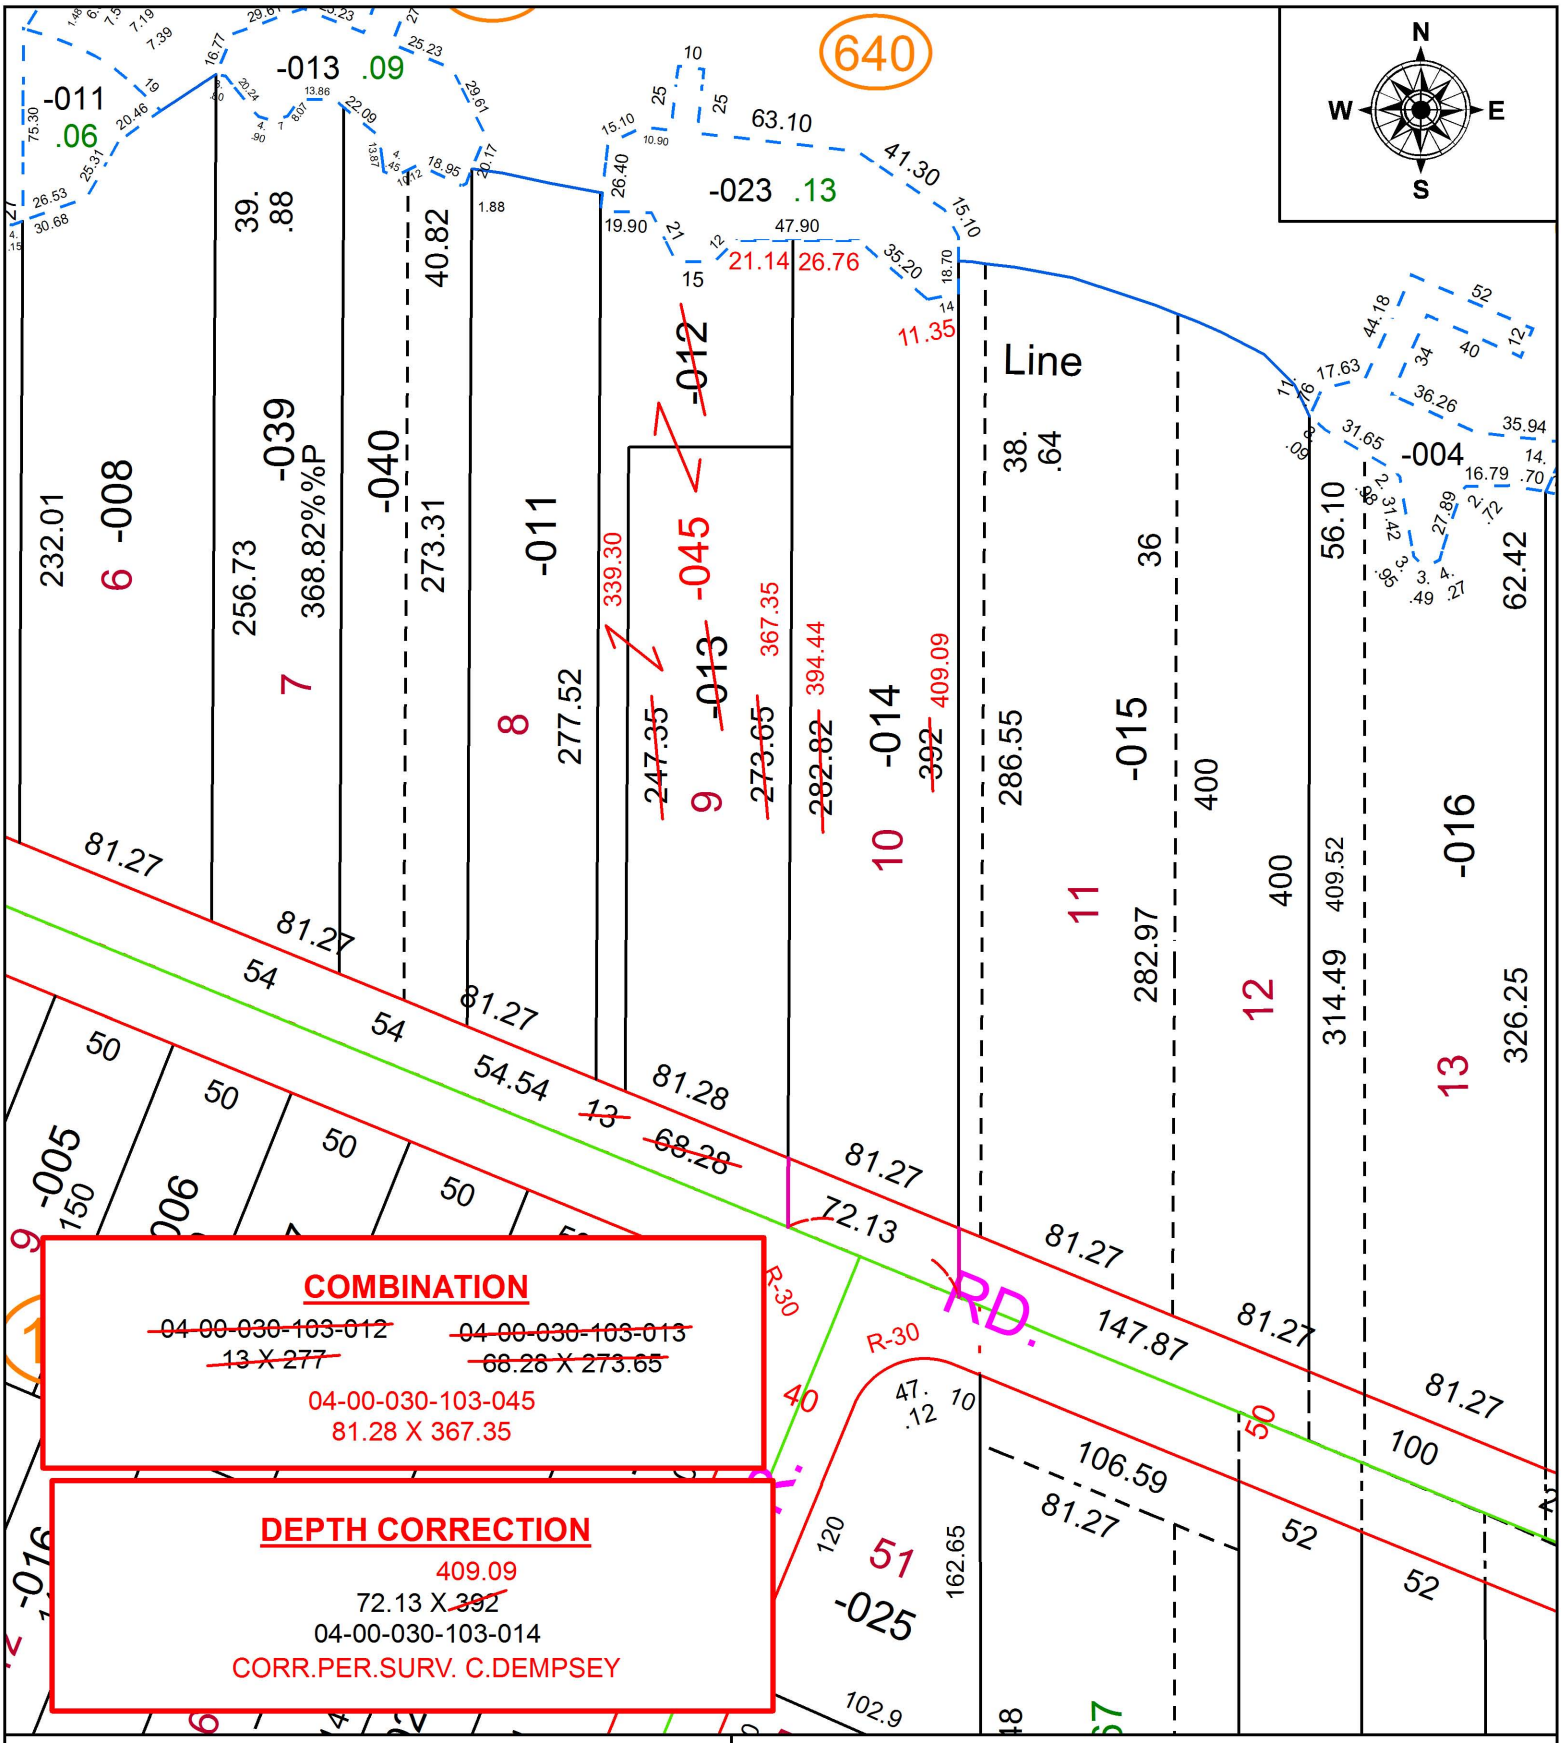

SPLITS/DEEDS PROCESSED

LORAIN COUNTY TAX MAP DEPARTMENT
226 MIDDLE AVE. ELYRIA, OH

SURVEYED BY: CHRISTOPHER J. DEMPSEY
CLOSURE: 1:222,148
MAP PAGE(S): 4-00-030
APPOVED BY: RRM **DATE:** 5-9-19
SCALE: 1" = 75 **PRIOR INSTRUMENT:** 20170652253