PARENT PARCEL: 13-11-009-000-006

CHILD PARCEL:

STARTING POINT: INTERSECTION OF C/L OF BAUMHART RD. AND NORTH LINE OF FORMER TOLEDO NORWALK CLEVELAND R.R.

19-04088-C

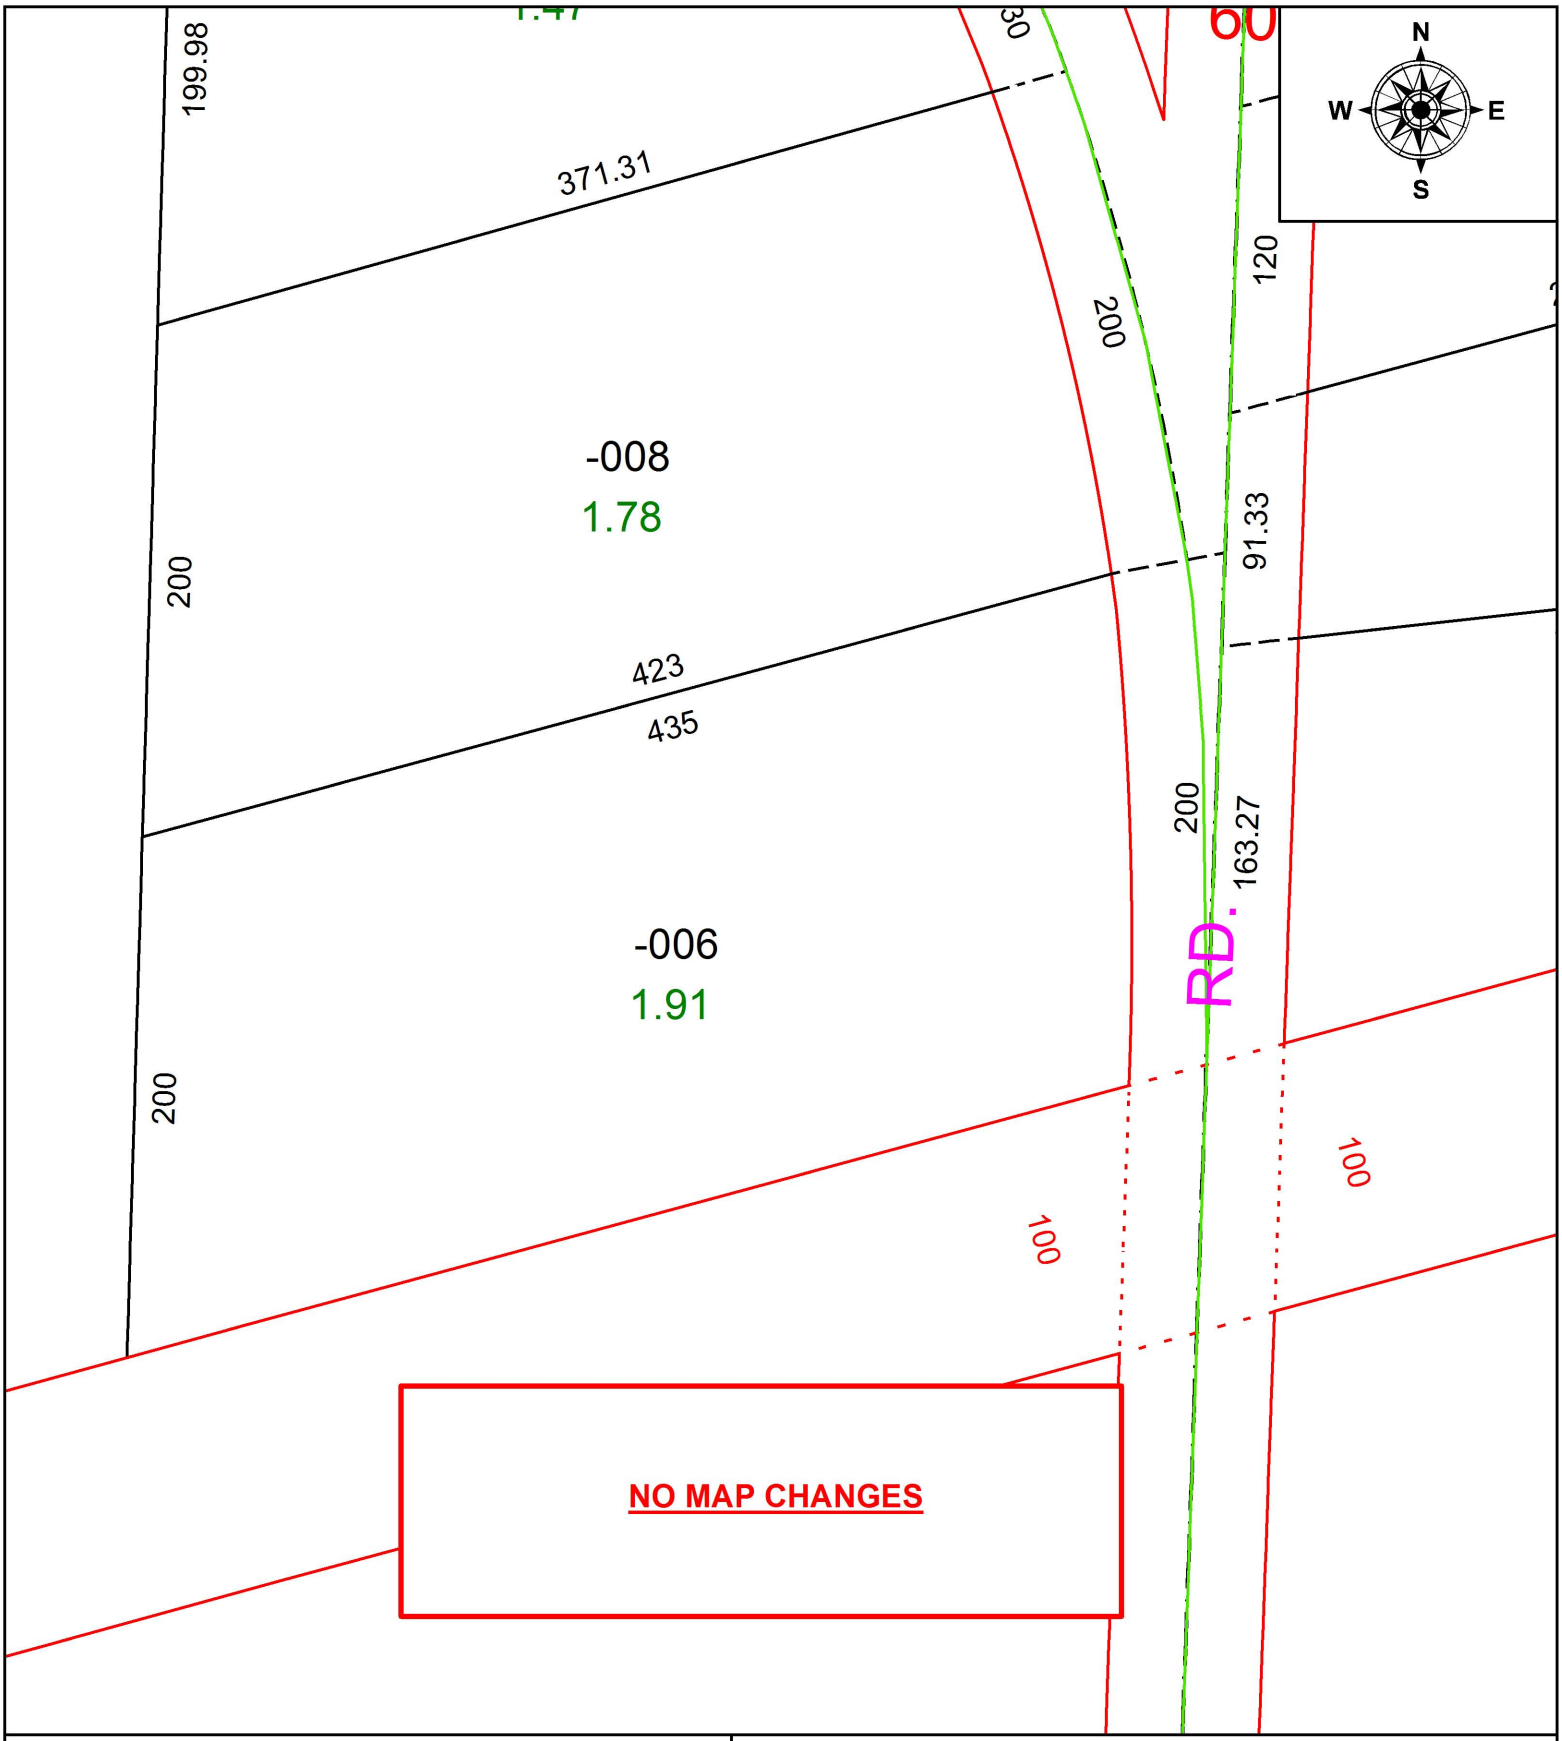

SPLITS/DEEDS PROCESSED

LORAIN COUNTY TAX MAP DEPARTMENT
226 MIDDLE AVE. ELYRIA, OH

SURVEYED BY: PATRICK A. MCGANNON
CLOSURE: 1:2147483648
MAP PAGE(S): 13-11-009
APPOVED BY: RRM **DATE:** 5-10-19
SCALE: 1" = 75 **PRIOR INSTRUMENT:** 20180685651