PARENT PARCEL: 10-00-005-106-008

CHILD PARCEL:

STARTING POINT: INTERSECTION OF C/L OF CHESTNUT RIDGE RD. AND C/L OF EAST RIVER RD.

19-04089-D

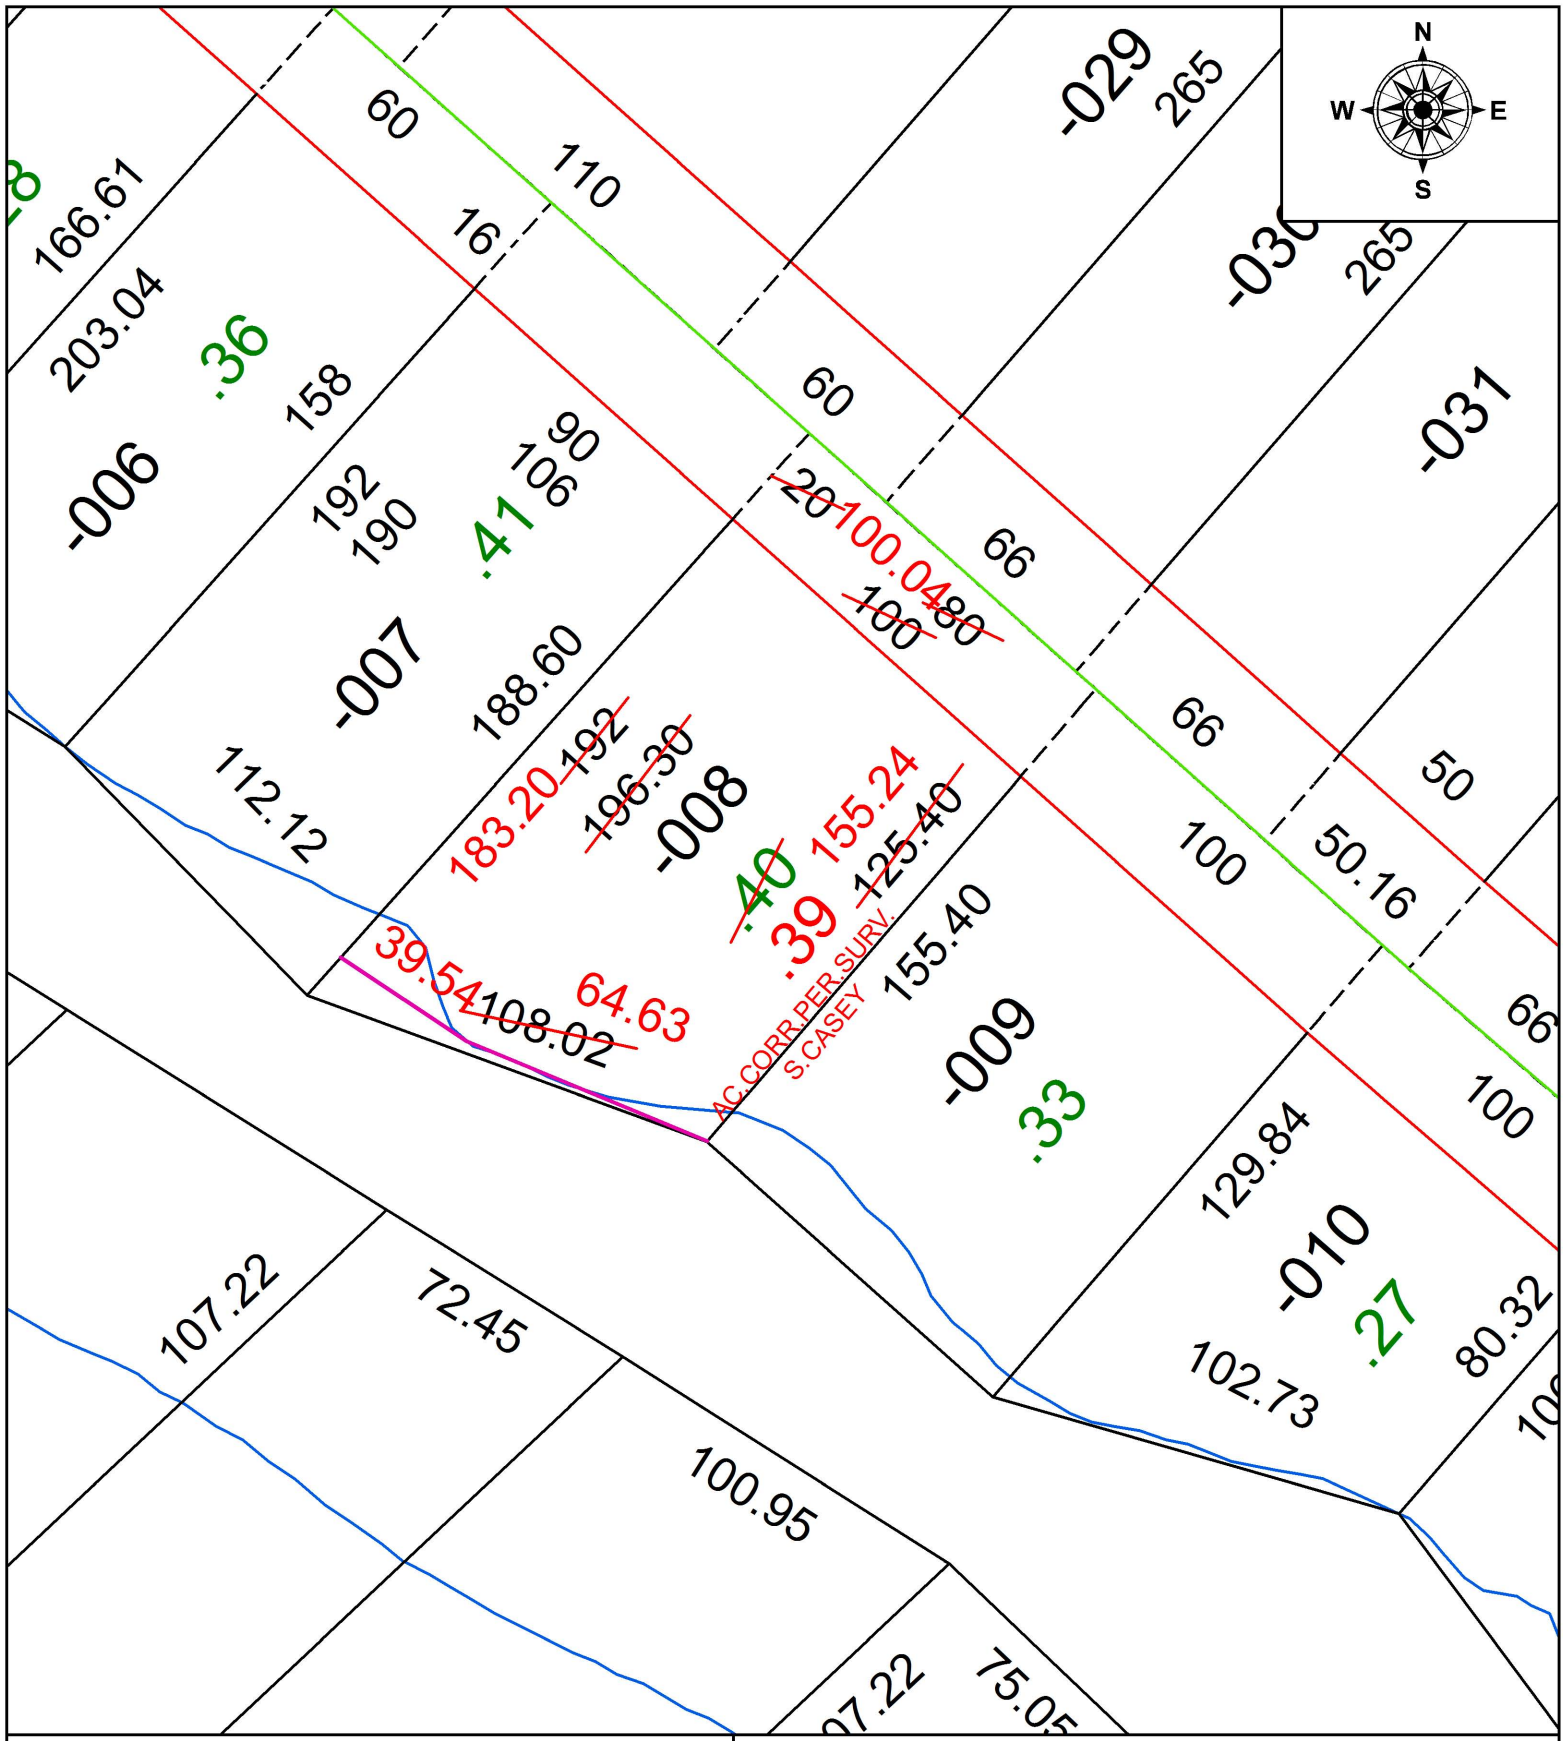

SPLITS/DEEDS PROCESSED

LORAIN COUNTY TAX MAP DEPARTMENT
226 MIDDLE AVE. ELYRIA, OH

SURVEYED BY: SCOTT J. CASEY
CLOSURE: 1: 394,503
MAP PAGE(S): 10-00-005
APPOVED BY: RRM **DATE:** 5-15-19
SCALE: 1" = 50 **PRIOR INSTRUMENT:** 20180665861