PARENT PARCEL: 05-00-052-000-056
CHILD PARCEL: 05-00-052-000-061, -062
STARTING POINT: INTERSECTION OF C/L OF OBERLIN RD. AND SOUTH LINE OF O.L.52

20-04089

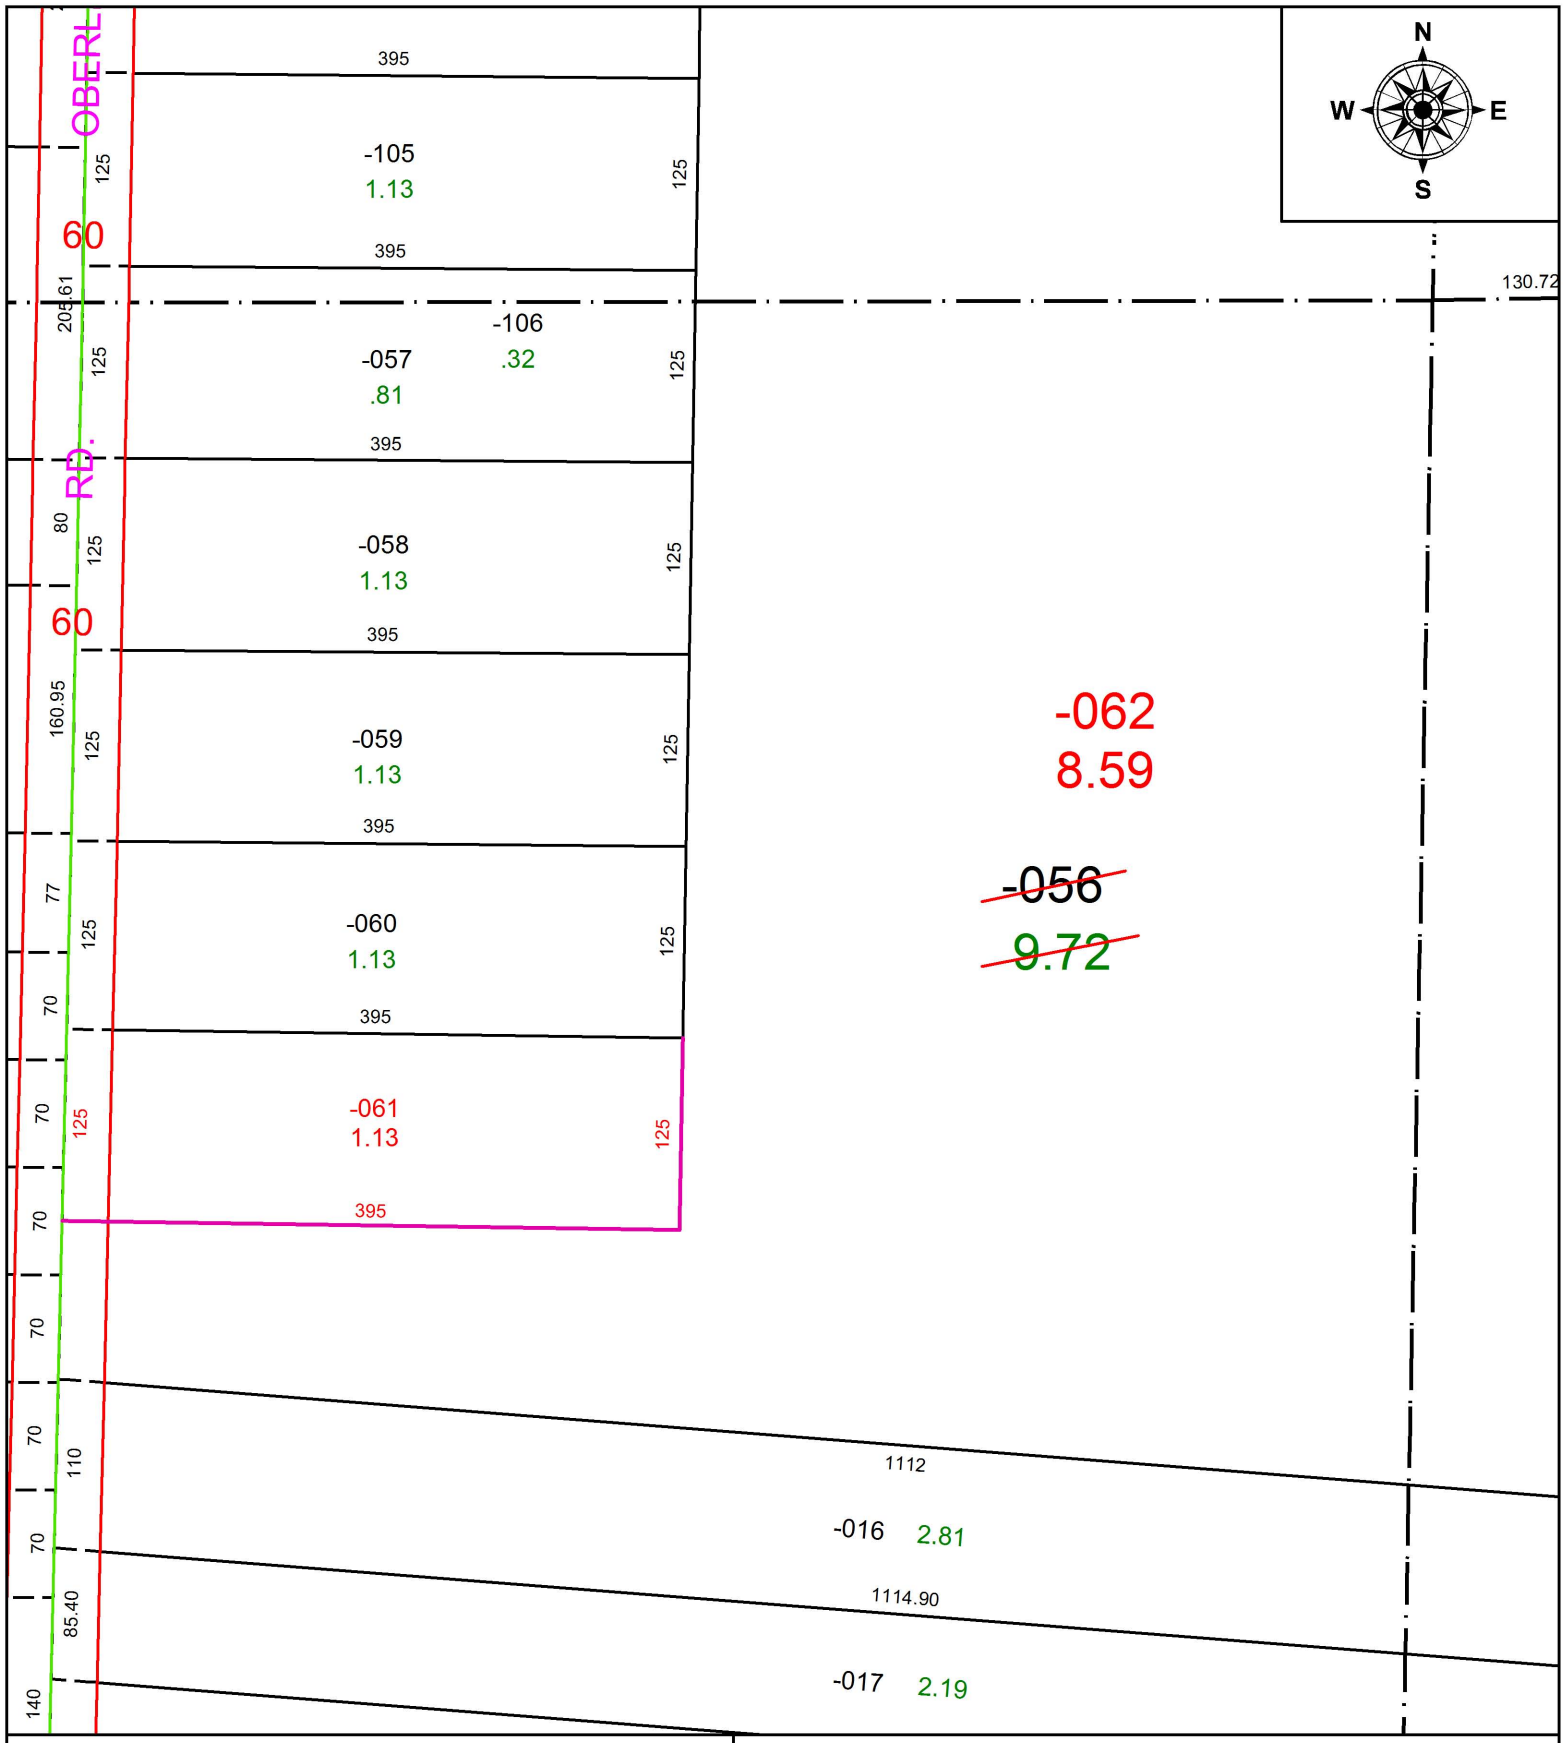

SPLITS/DEEDS PROCESSED
LORAIN COUNTY TAX MAP DEPARTMENT
226 MIDDLE AVE. ELYRIA, OH

SURVEYED BY: THOMAS A. SIMON
CLOSURE: 1:2147483648
MAP PAGE(S): 5-00-052
APPOVED BY: RRM **DATE:** 2-14-20
SCALE: 1" = 125 **PRIOR INSTRUMENT:** 20000707326