PARENT PARCEL: 07-00-003-102-094

CHILD PARCEL: 07-00-003-102-100, -101

STARTING POINT: INTERSECTION OF C/L OF VICTORY LN. AND C/L OF BUTTERNUT RIDGE RD.

20-04092

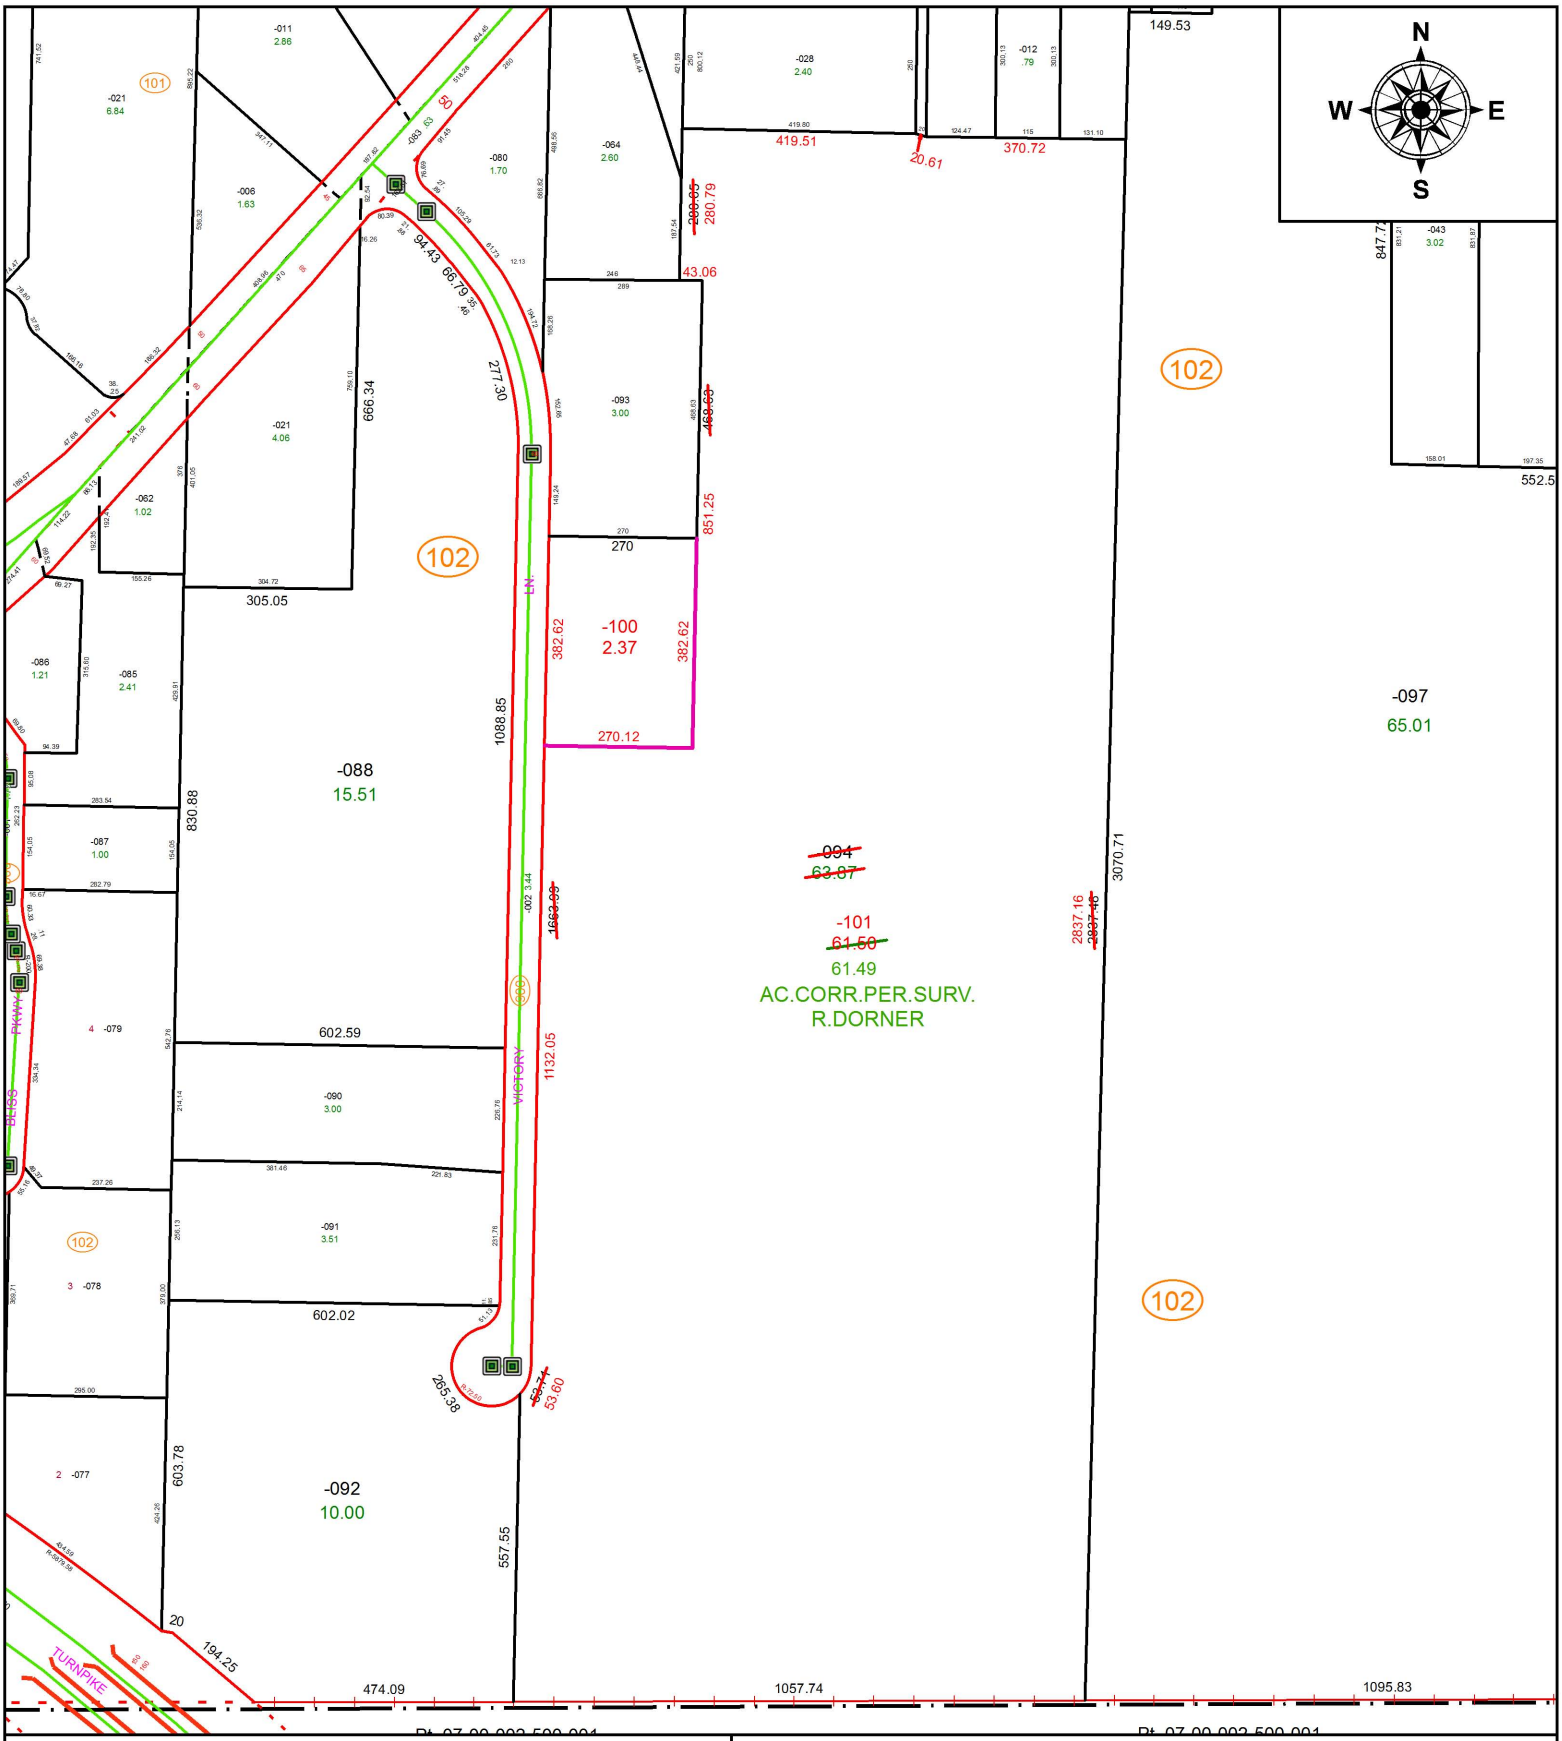

SPLITS/DEEDS PROCESSED

LORAIN COUNTY TAX MAP DEPARTMENT
226 MIDDLE AVE. ELYRIA, OH

SURVEYED BY: ROBERT A. DORNER
CLOSURE: 1:1,034,998
MAP PAGE(S): 7-00-003
APPOVED BY: RRM **DATE:** 2-28-20
SCALE: 1" = 350 **PRIOR INSTRUMENT:** 20150551956