**PARENT PARCEL:** 07-00-039-000-013

**CHILD PARCEL:**

**STARTING POINT:** INTERSECTION OF C/L OF CENTER RIDGE RD. AND C/L OF RACE RD.

# 19-04094-C

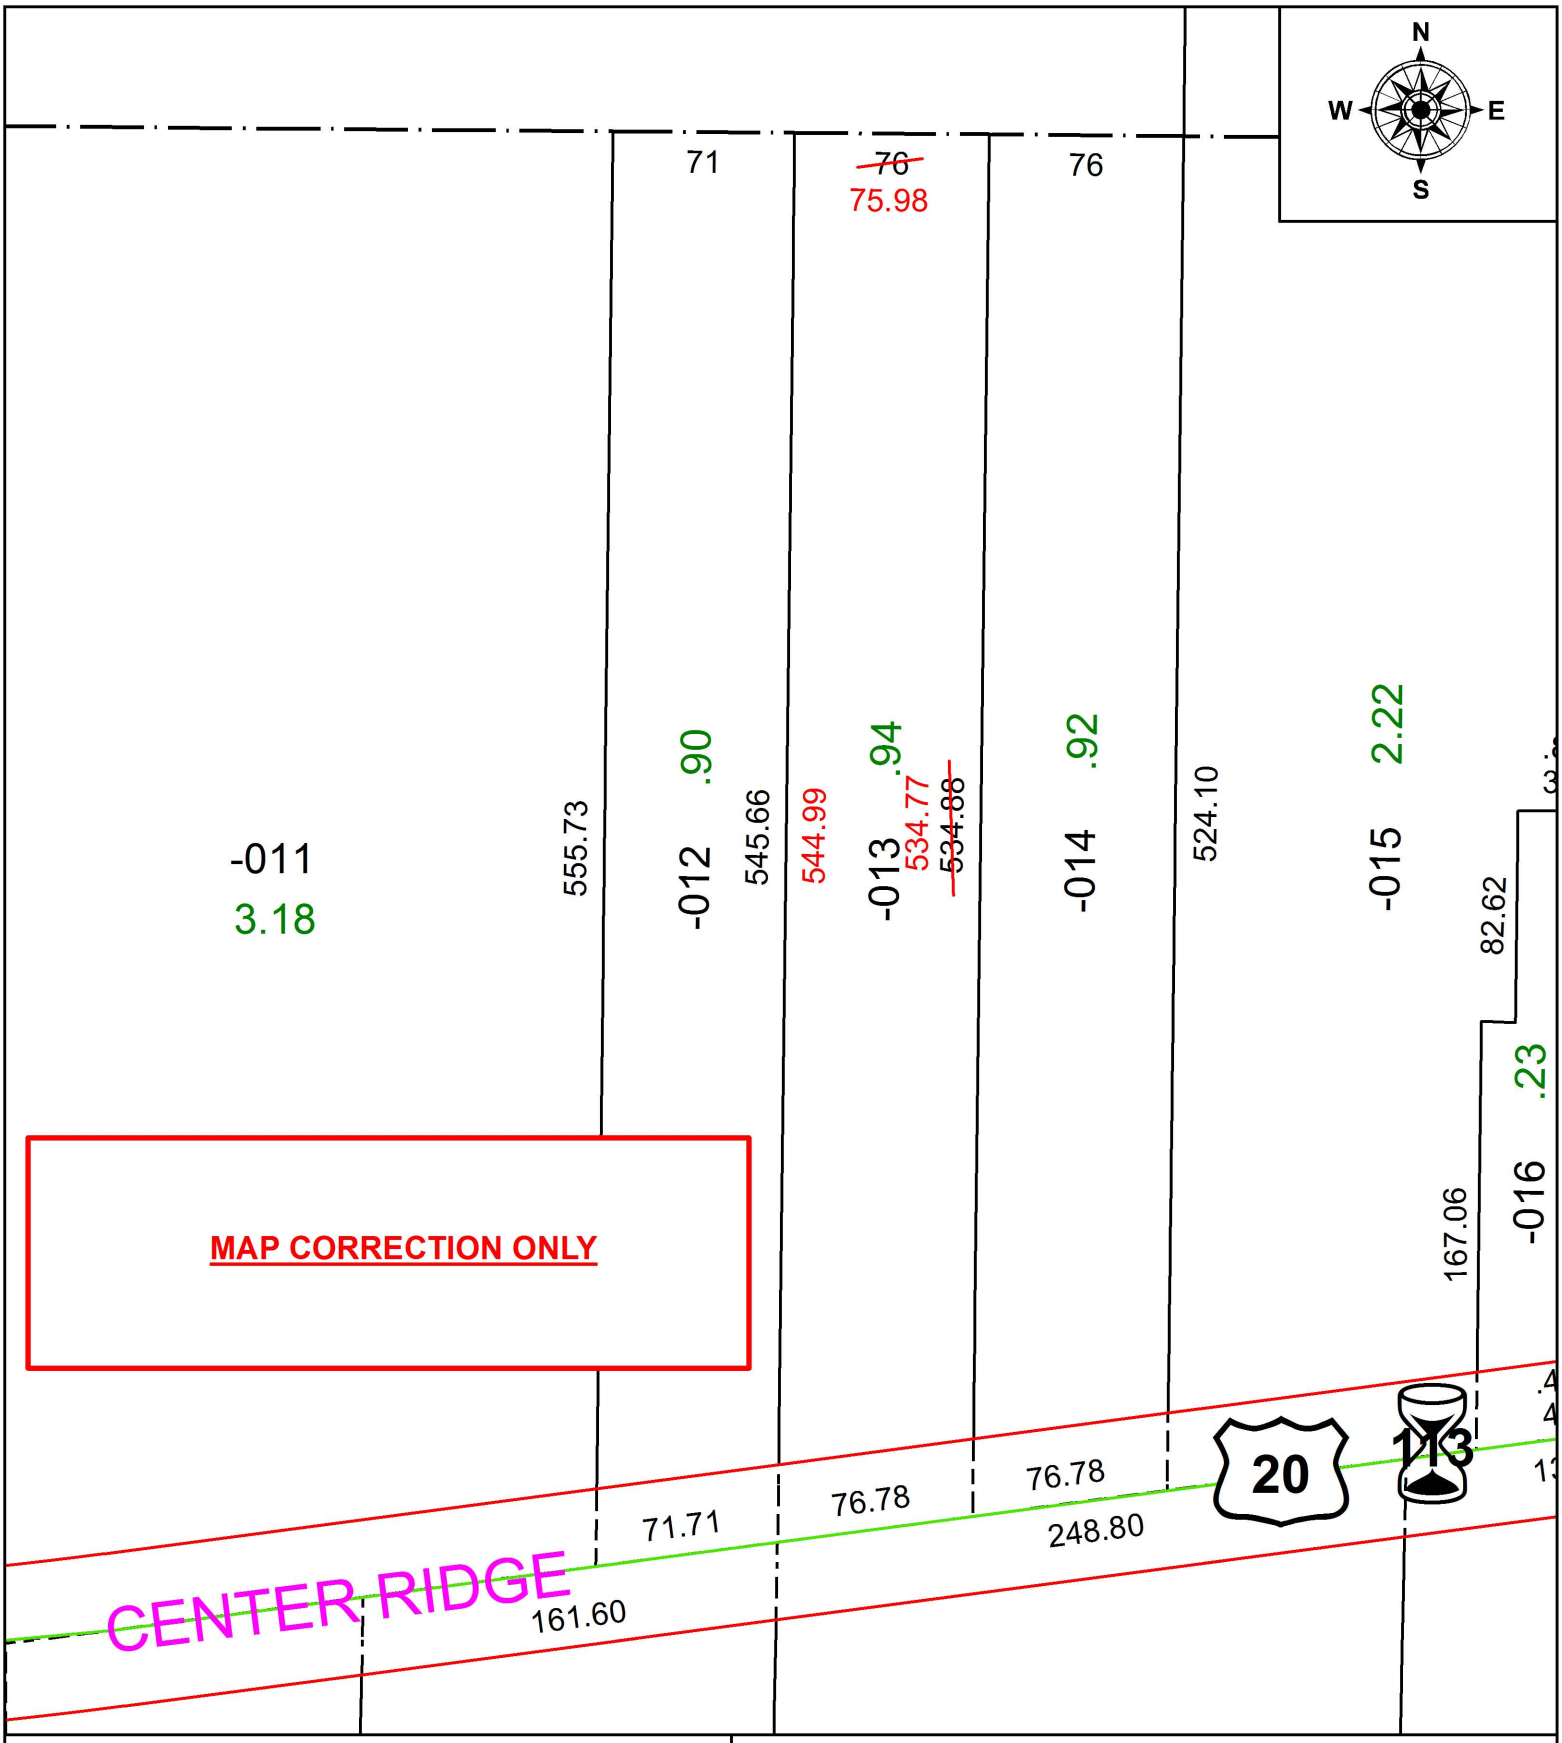


**SPLITS/DEEDS PROCESSED**

LORAIN COUNTY TAX MAP DEPARTMENT
226 MIDDLE AVE. ELYRIA, OH

**SURVEYED BY:** DAVID J. ZECK
**CLOSURE:** 1: 182,083
**MAP PAGE(S):** 7-00-039
**APPOVED BY:** RRM **DATE:** 5-24-19
**SCALE:** 1" = 75 **PRIOR INSTRUMENT:** 20190706545