PARENT PARCEL: 03-00-001-000-101, -103, -172, -178, -183

CHILD PARCEL: 03-00-001-000-203

STARTING POINT: INTERSECTION OF C/L OF ABBE RD. AND SOUTH LINE OF SHEFFIELD VILLAGE

20-04101

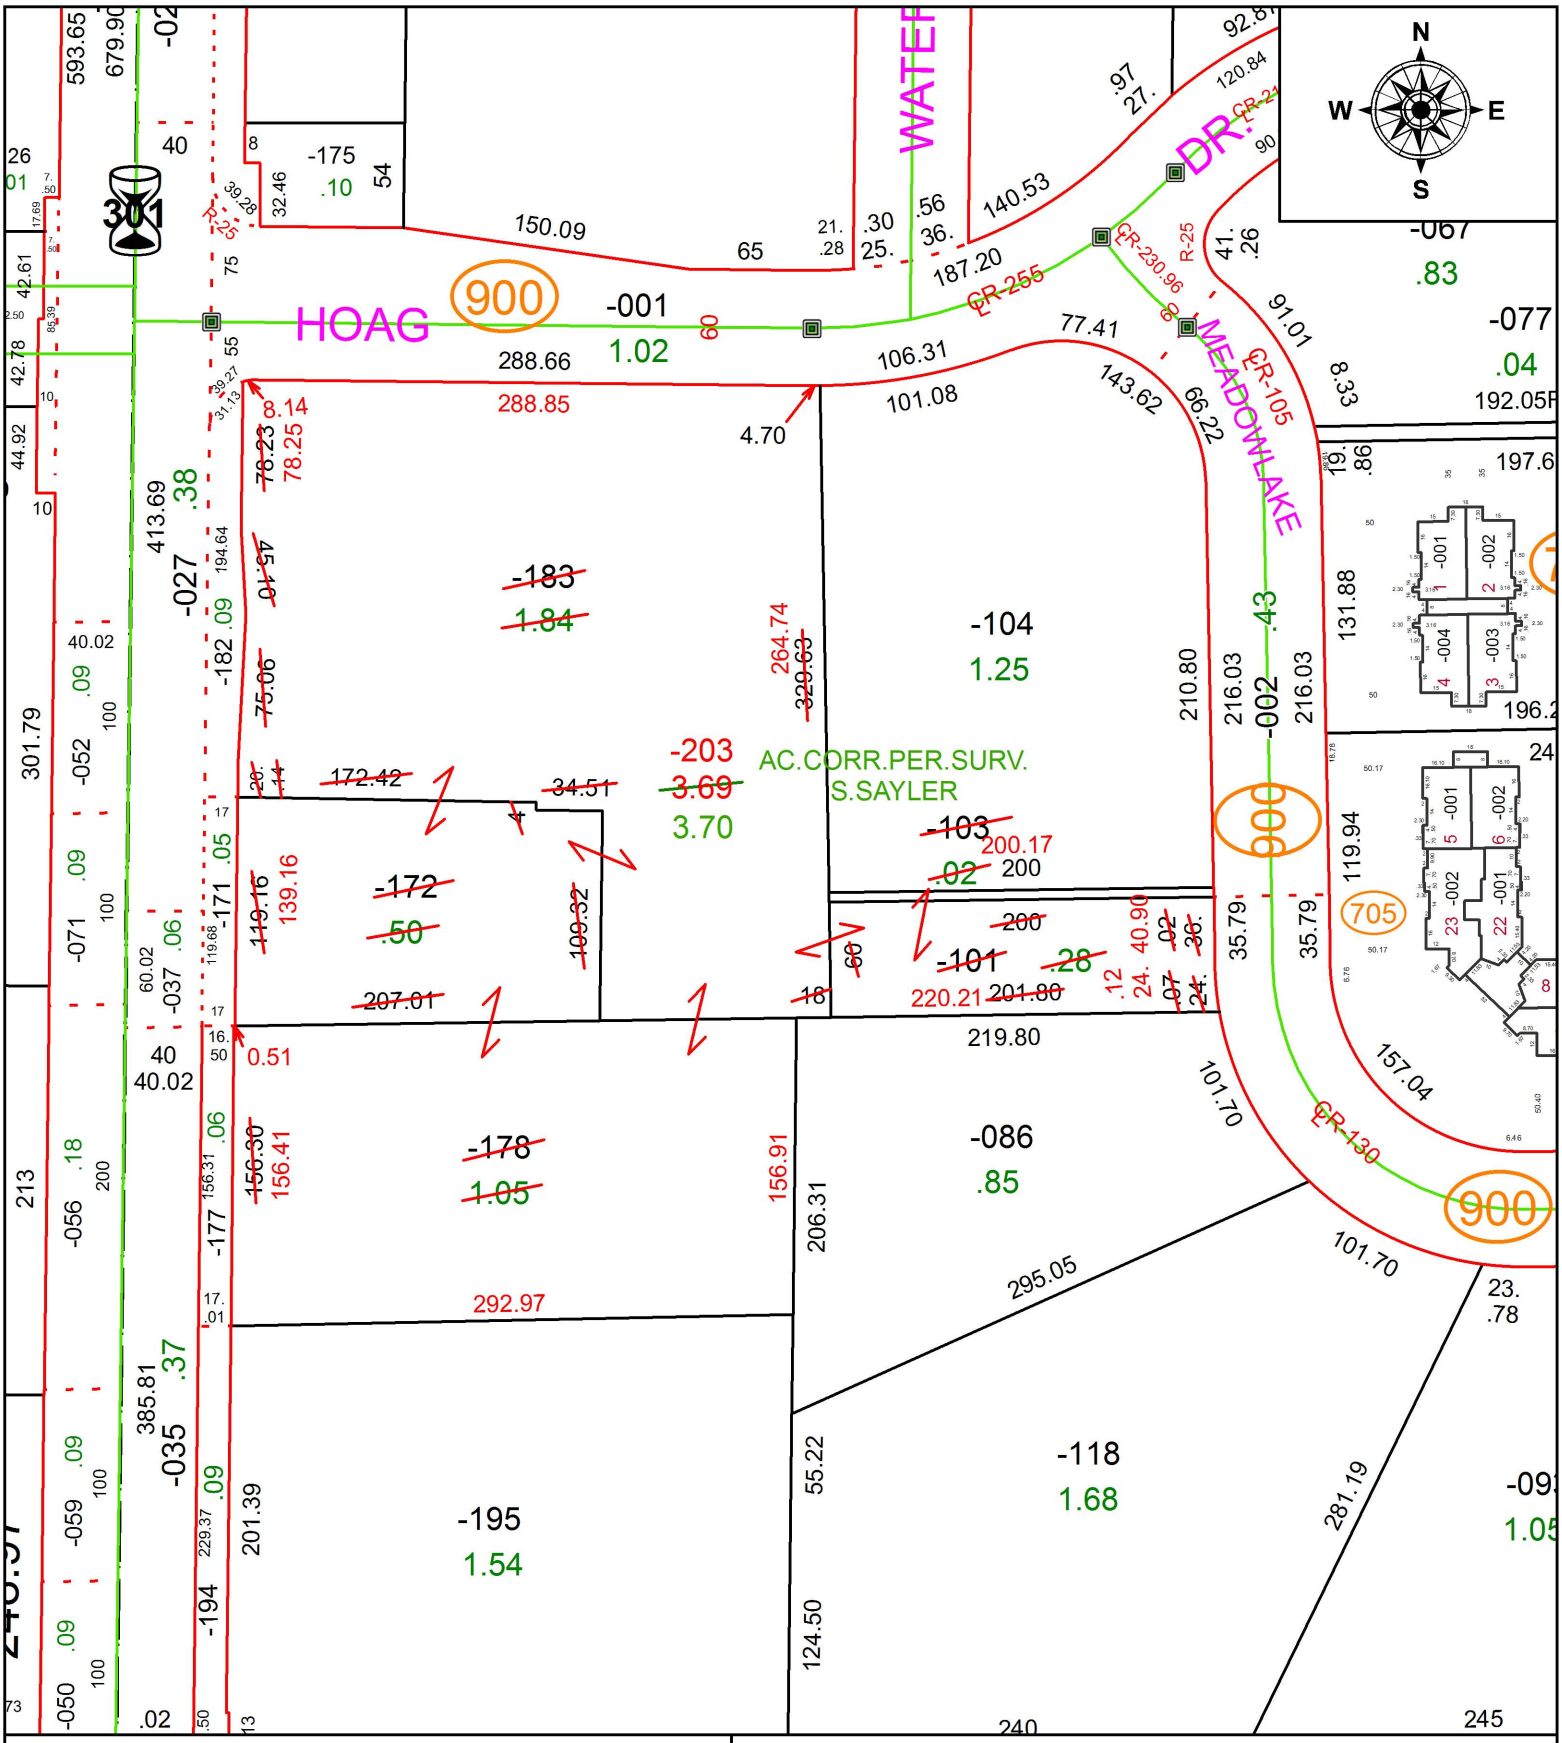

SPLITS/DEEDS PROCESSED

LORAIN COUNTY TAX MAP DEPARTMENT
226 MIDDLE AVE. ELYRIA, OH

SURVEYED BY: STUART W. SAYLER
CLOSURE: 1:528,629
MAP PAGE(S): 3-00-001
APPOVED BY: RRM **DATE:** 3-5-20
SCALE: 1" = 100 **PRIOR INSTRUMENT:** 20200751636