PARENT PARCEL: 09-00-048-000-013

CHILD PARCEL: 09-00-048-000-014, -015

STARTING POINT: INTERSECTION OF C/L OF OBERLIN RD. AND NORTHWEST CORNER OF O.L.48

20-04104

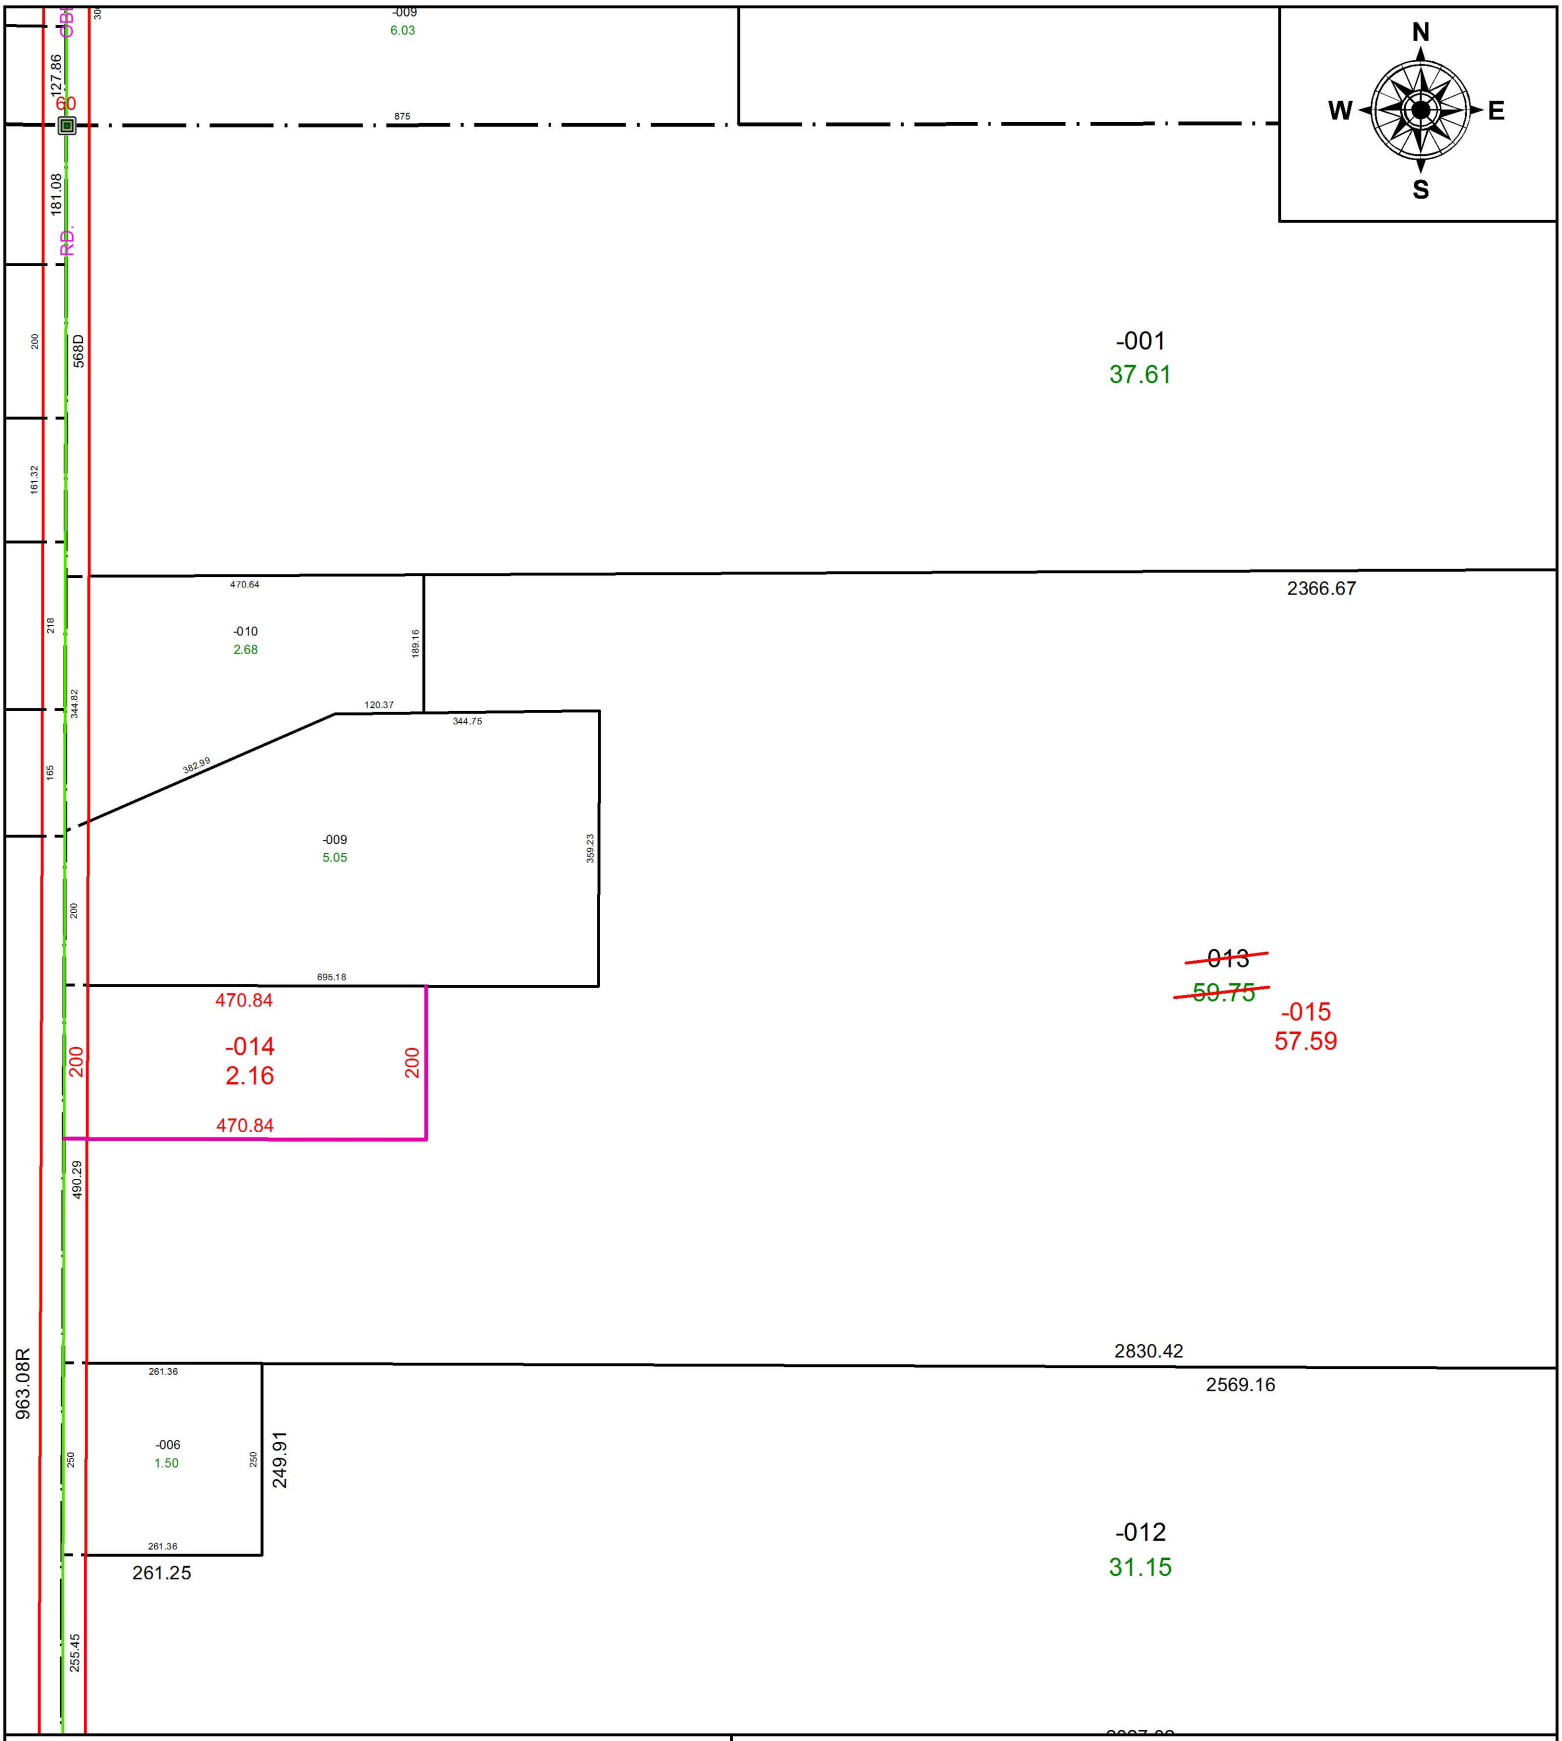

SPLITS/DEEDS PROCESSED

LORAIN COUNTY TAX MAP DEPARTMENT
226 MIDDLE AVE. ELYRIA, OH

SURVEYED BY: TIMOTHY D. HOZALSKI
CLOSURE: 1:2147483648
MAP PAGE(S): 9-00-048
APPOVED BY: RRM **DATE:** 3-16-20
SCALE: 1" = 250 **PRIOR INSTRUMENT:** 20190712370