PARENT PARCEL: ADD TO DUPLICATE

CHILD PARCEL: 02-01-004-101-090 & 02-01-004-103-033

STARTING POINT: VACATION PORTION OF 16' ALLEY 16 X 17.50 PER ORD. #58-19

19-04105-V

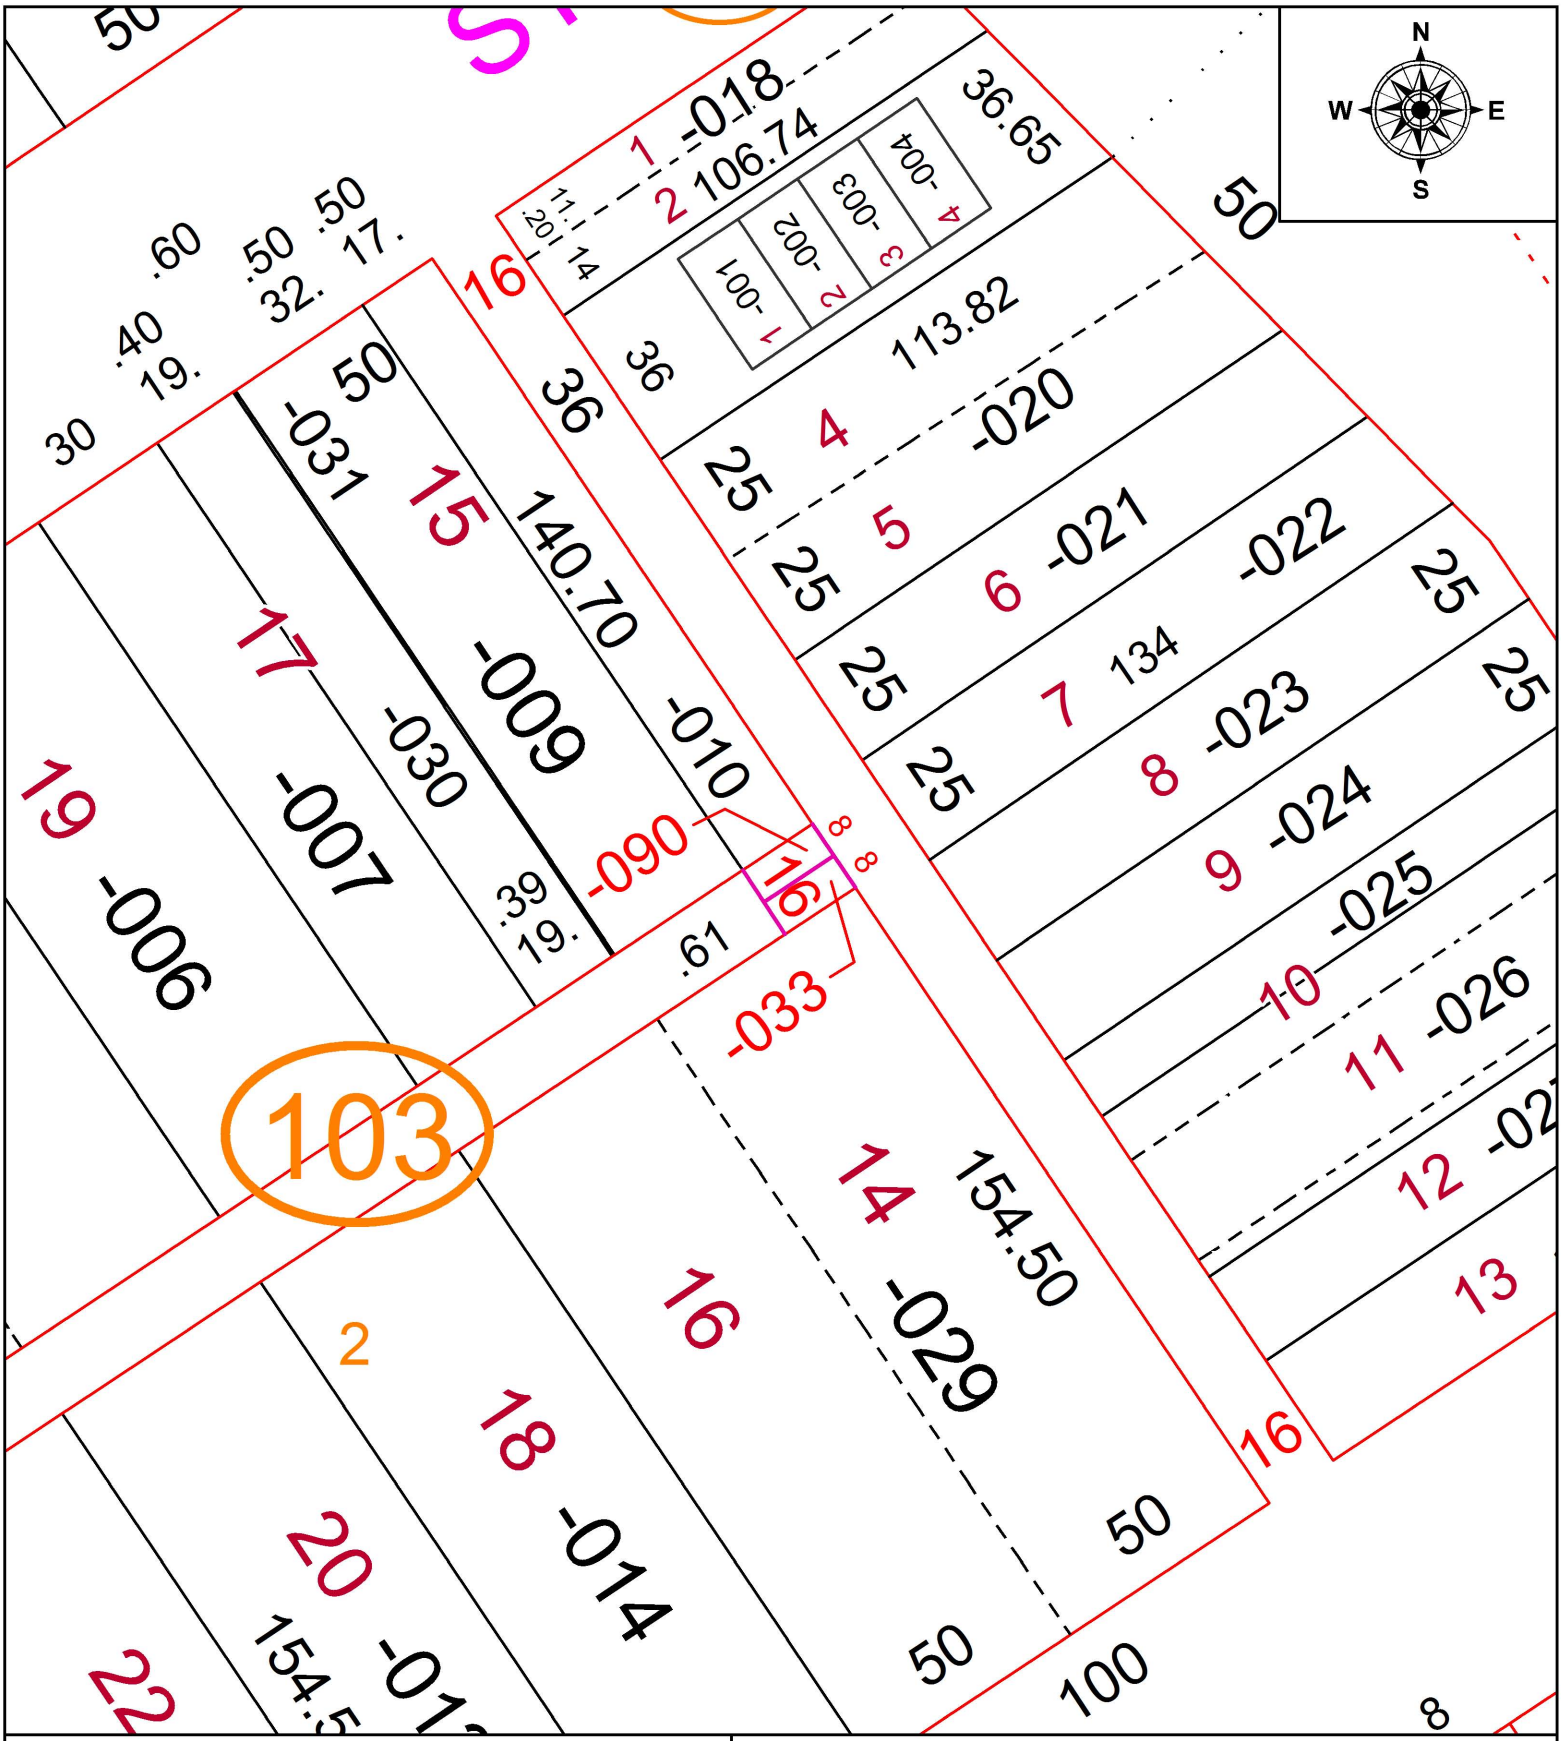

SPLITS/DEEDS PROCESSED

LORAIN COUNTY TAX MAP DEPARTMENT
226 MIDDLE AVE. ELYRIA, OH

SURVEYED BY: DOUG HASEL
CLOSURE: NA
MAP PAGE(S): 02-01-004
APPOVED BY: TJS **DATE:** 5/29/19
SCALE: 1" = 40' **PRIOR INSTRUMENT:** DV XXXX/XXXX