PARENT PARCEL: 10-00-009-121-016, -019

CHILD PARCEL: 10-00-009-121-020 THRU -022

STARTING POINT: STATION 660+02.48 S.R. 20 SHOWN ON PLAT VOL.17 PG.14

20-04105

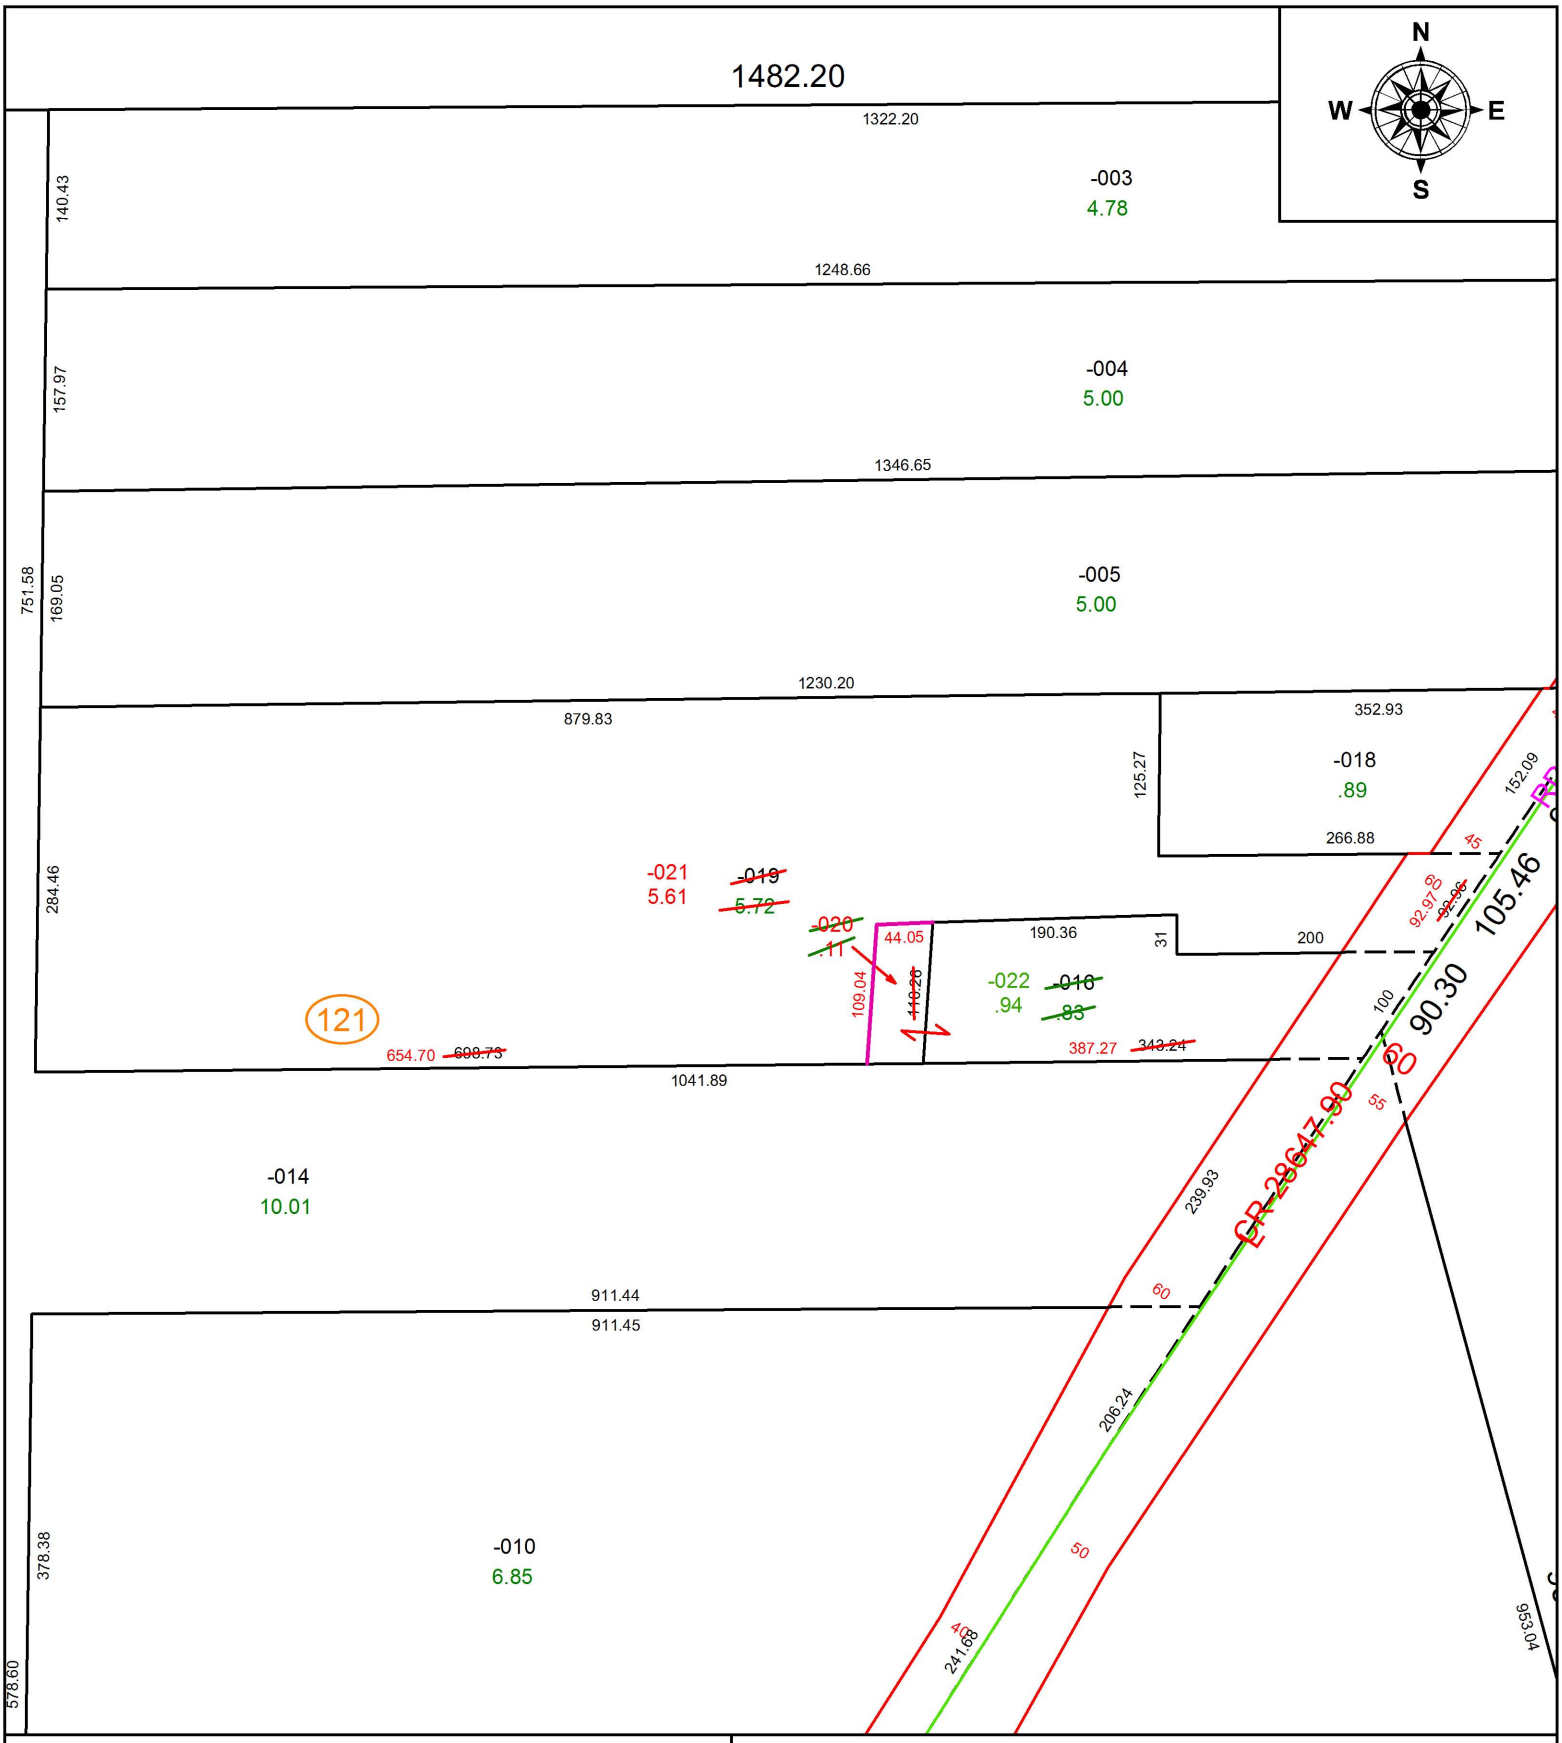

SPLITS/DEEDS PROCESSED

LORAIN COUNTY TAX MAP DEPARTMENT
226 MIDDLE AVE. ELYRIA, OH

SURVEYED BY: RICHARD D. CARLSON
CLOSURE: 1:410,058
MAP PAGE(S): 10-00-009
APPOVED BY: RRM **DATE:** 3-16-20
SCALE: 1" = 150 **PRIOR INSTRUMENT:** 20040047888