PARENT PARCEL: 10-00-015-108-039

CHILD PARCEL:

STARTING POINT: INTERSECTION OF NORTH LINE OF EDGEWOOD DR. AND EAST LINE OF LAKEVIEW DR.

19-04106-C

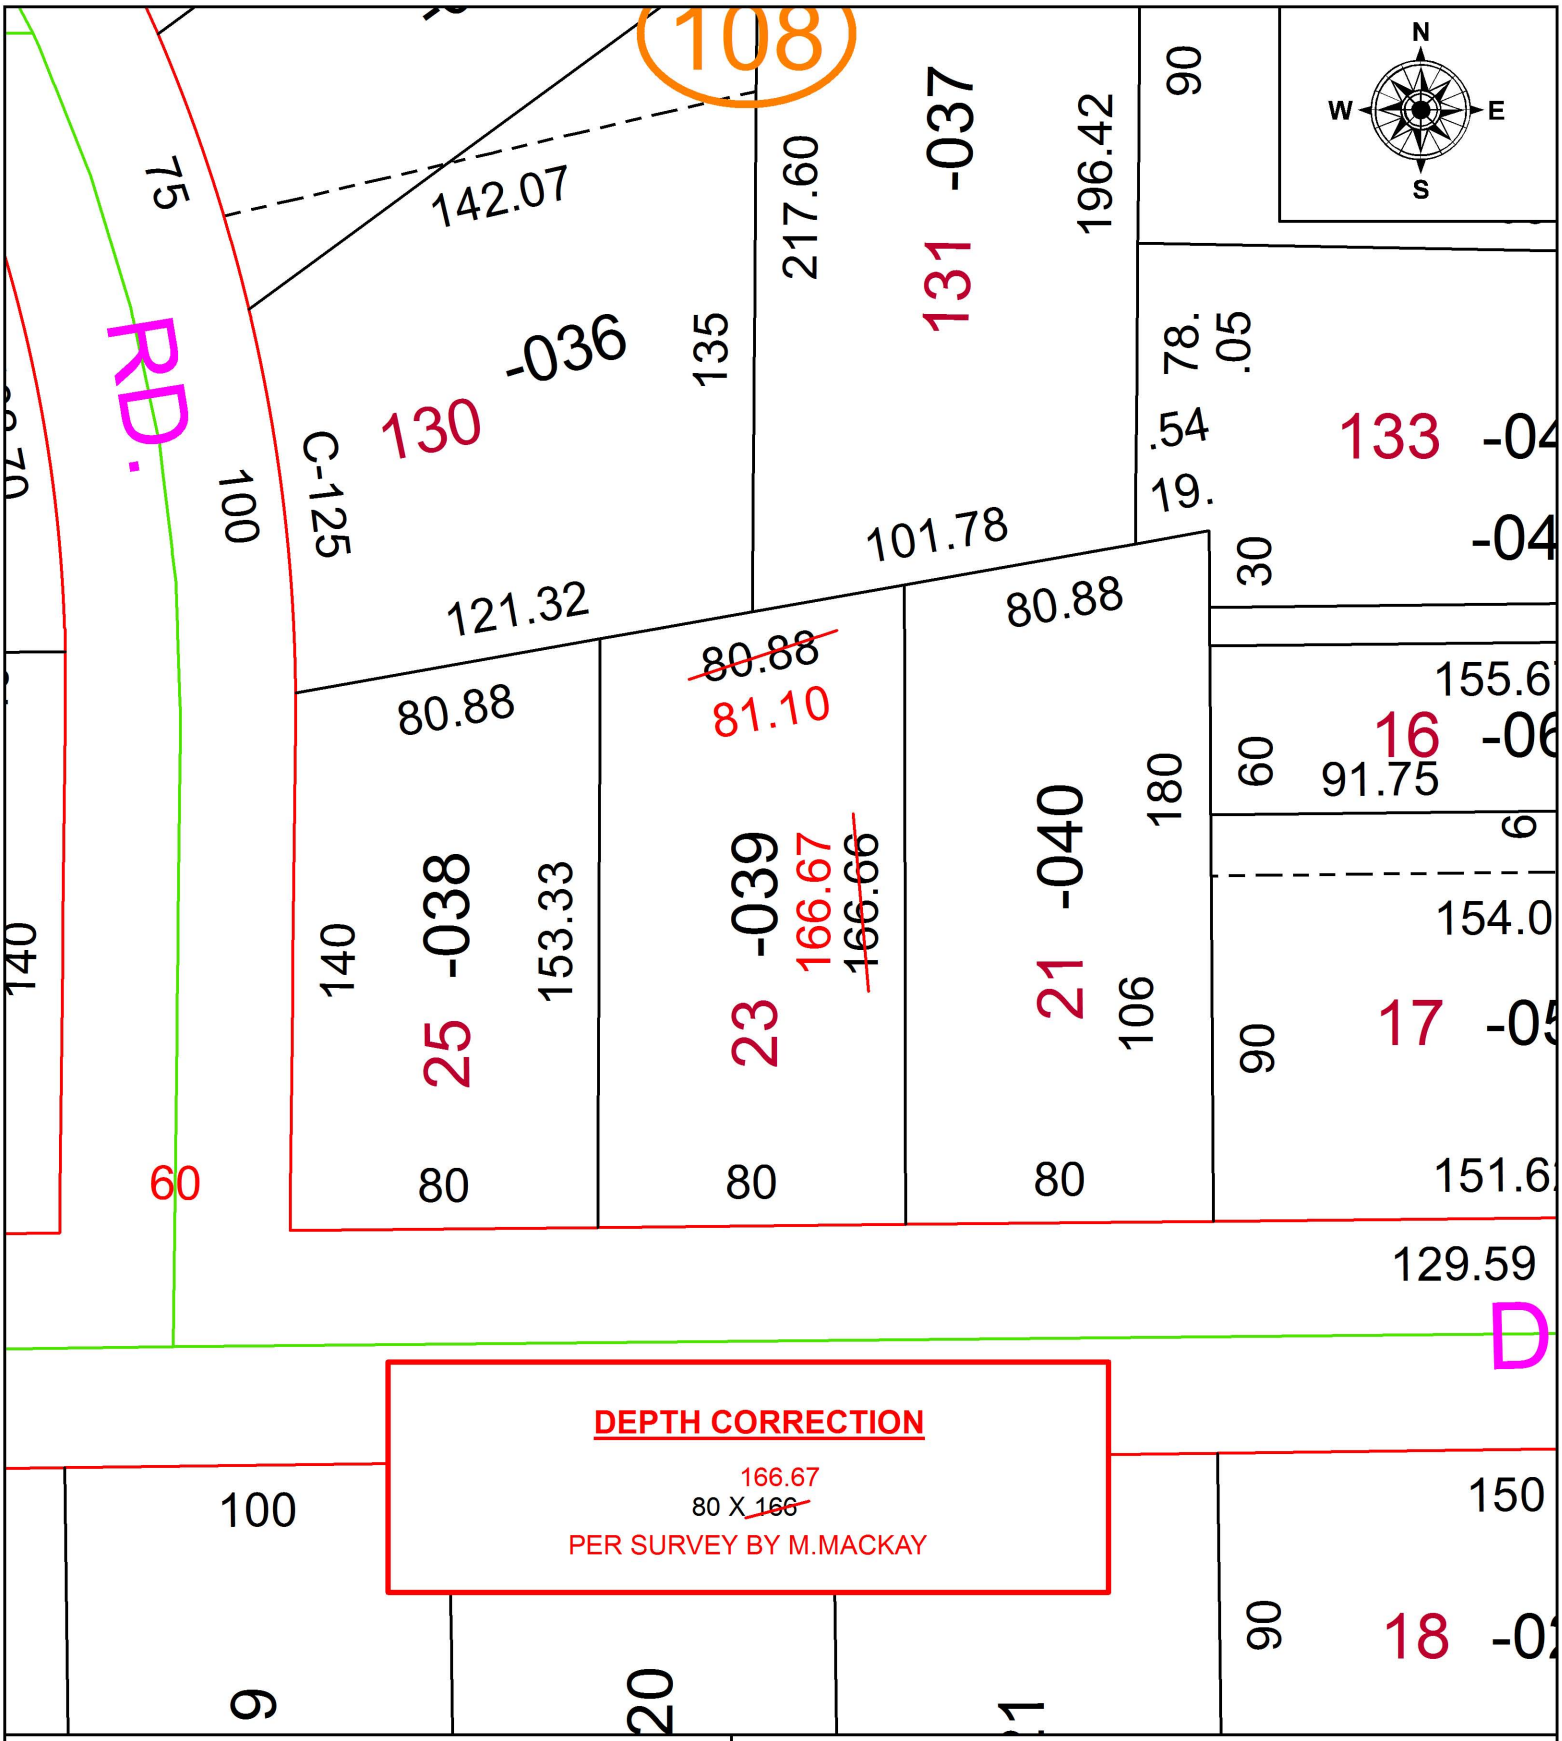

SPLITS/DEEDS PROCESSED

LORAIN COUNTY TAX MAP DEPARTMENT
226 MIDDLE AVE. ELYRIA, OH

SURVEYED BY: MICHAEL MACKAY
CLOSURE: 1:104,215
MAP PAGE(S): 10-00-015
APPOVED BY: RRM **DATE:** 5-31-19
SCALE: 1" = 50 **PRIOR INSTRUMENT:** 20180683641