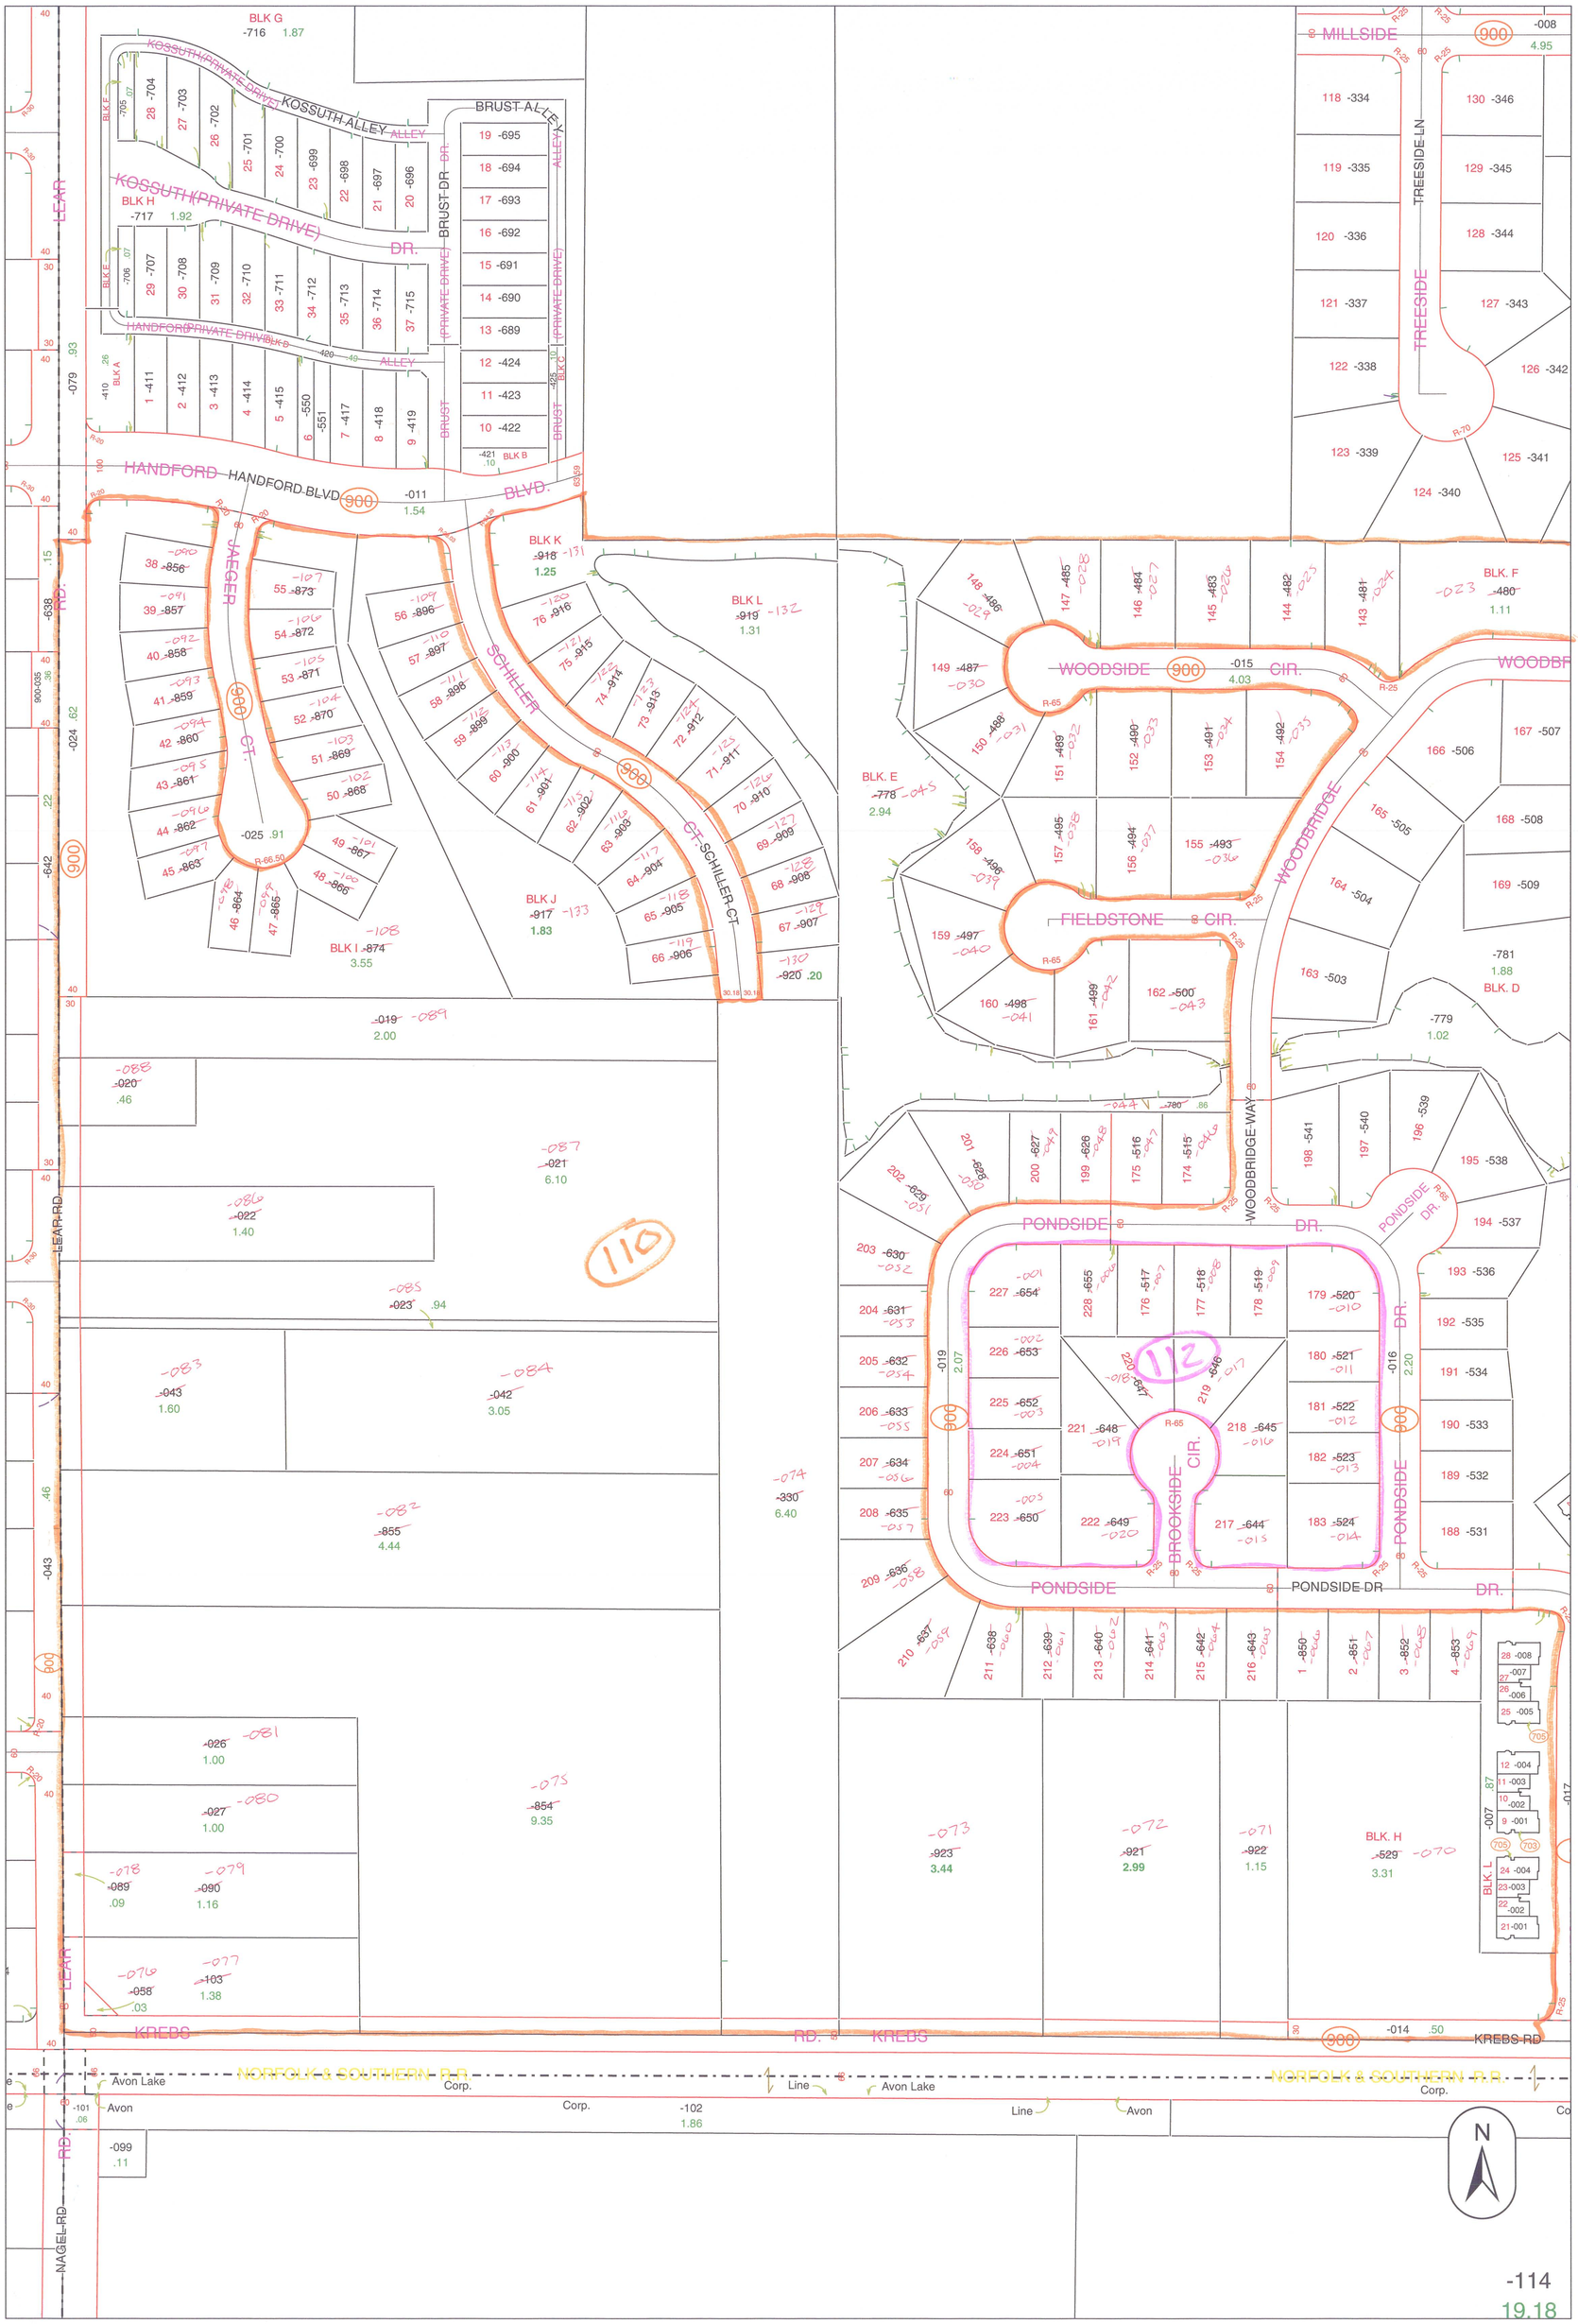

-114
19.18

Map produced by:
J. Craig Snodgrass, CPA, CGFM - Lorain County Auditor
GIS Department - May 29, 2019

Scale: 1 inch = 100 feet