PARENT PARCEL: 02-03-008-000-007

CHILD PARCEL: 02-03-008-000-009, -010

STARTING POINT: INTERSECTION OF C/L OF OAK POINT RD. AND SOUTH LINE OF O.L.7 TR.3

20-04108

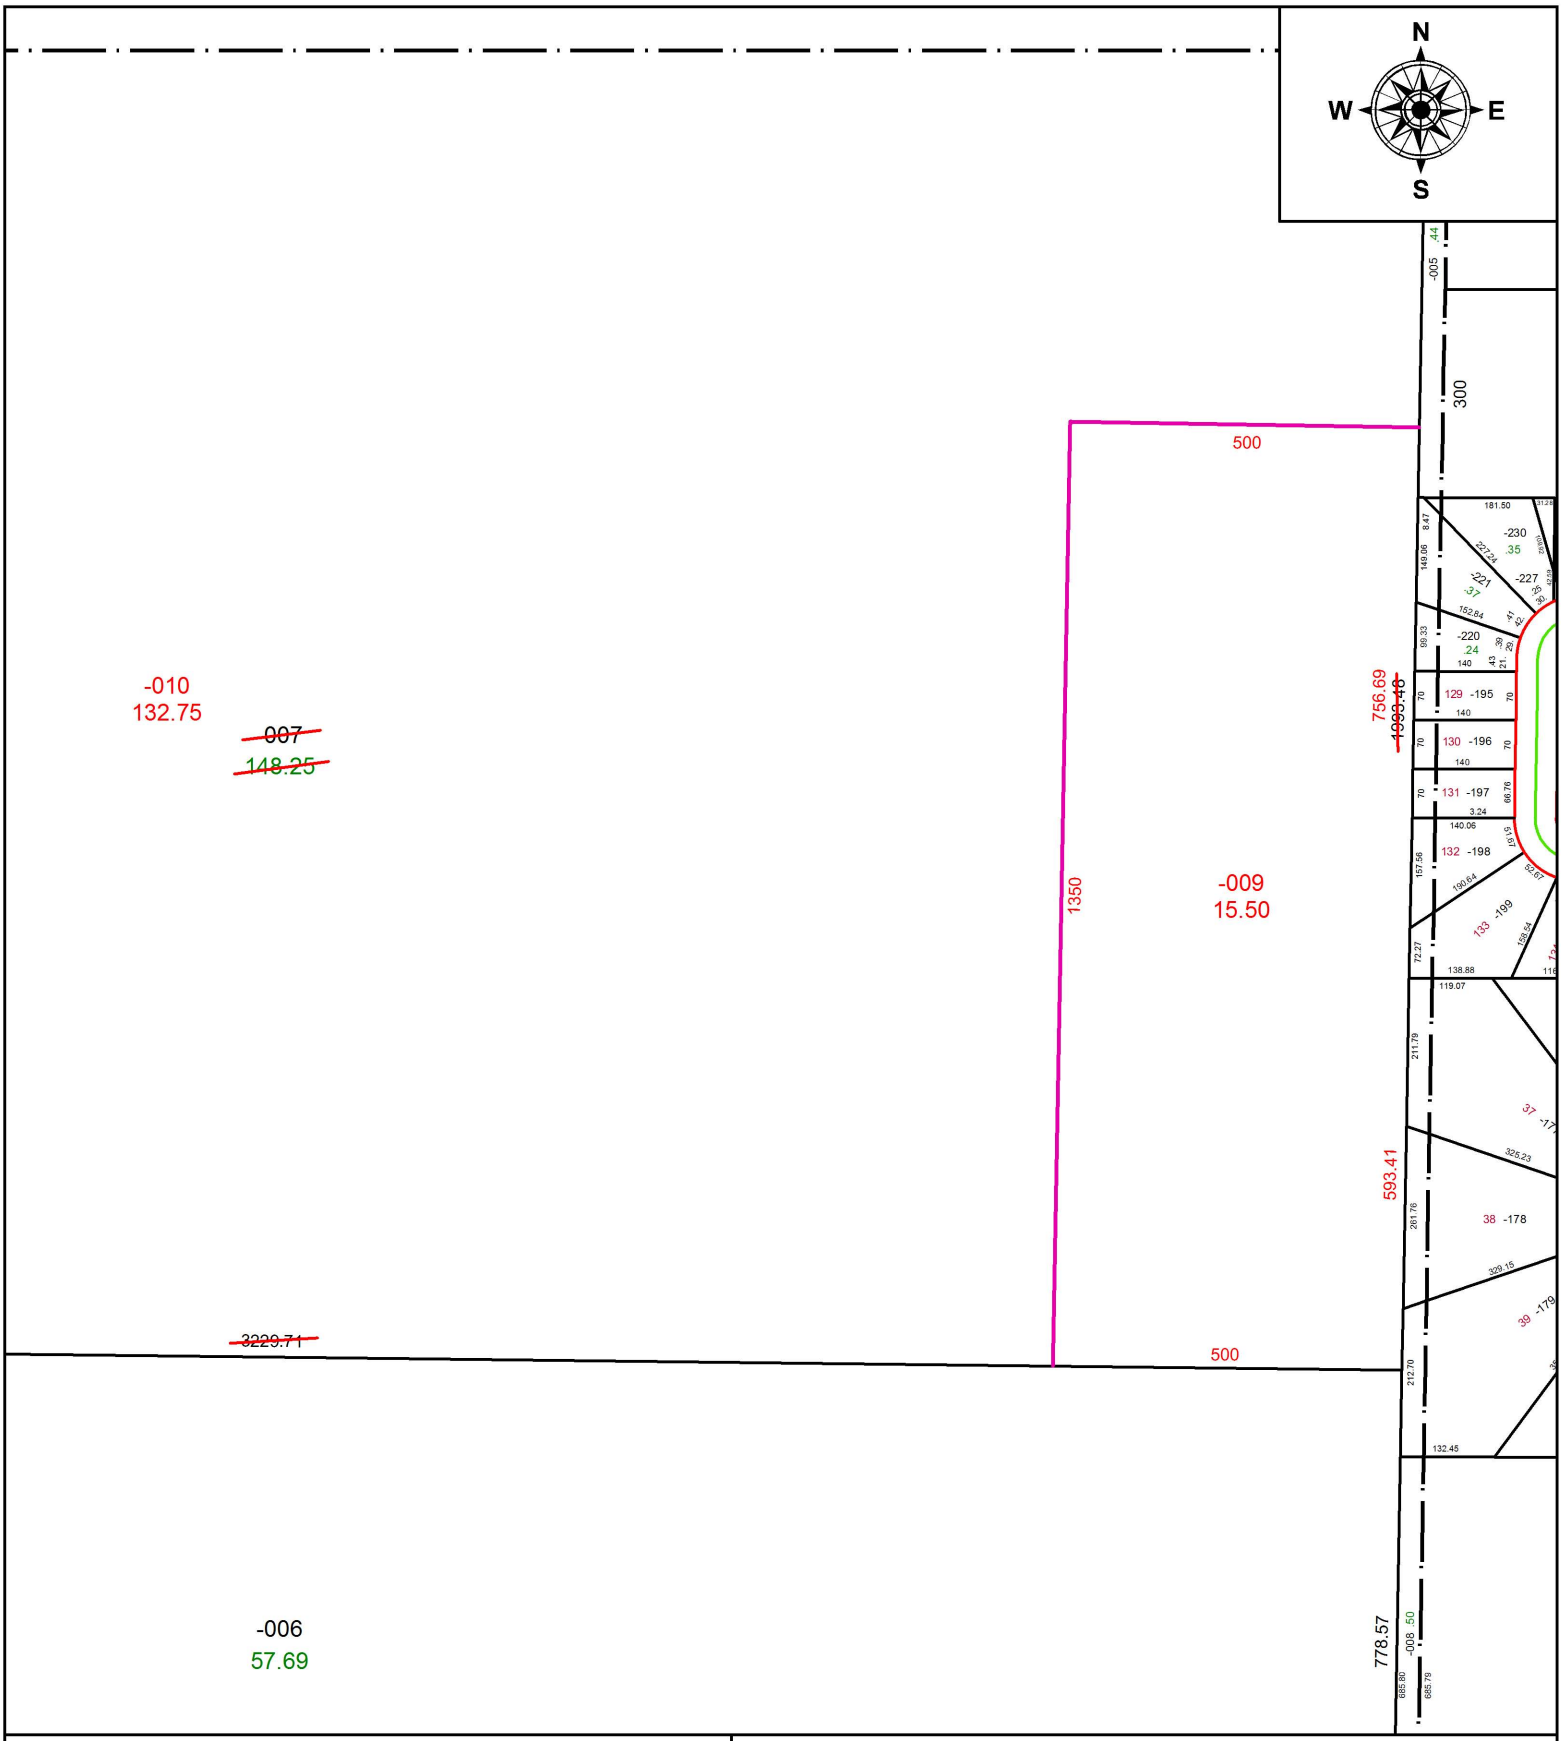

SPLITS/DEEDS PROCESSED

LORAIN COUNTY TAX MAP DEPARTMENT
226 MIDDLE AVE. ELYRIA, OH

SURVEYED BY: THOMAS M. SNEZEK
CLOSURE: 1:505,047
MAP PAGE(S): 2-03-008
APPOVED BY: RRM **DATE:** 3-24-20
SCALE: 1" = 275 **PRIOR INSTRUMENT:** 20190709311