PARENT PARCEL: 03-00-043-107-006, -007

CHILD PARCEL: 03-00-043-107-028

STARTING POINT: INTERSECTION OF C/L OF MAPLE GROVE DR. AND C/L OF LAKE RD.

20-04412-C

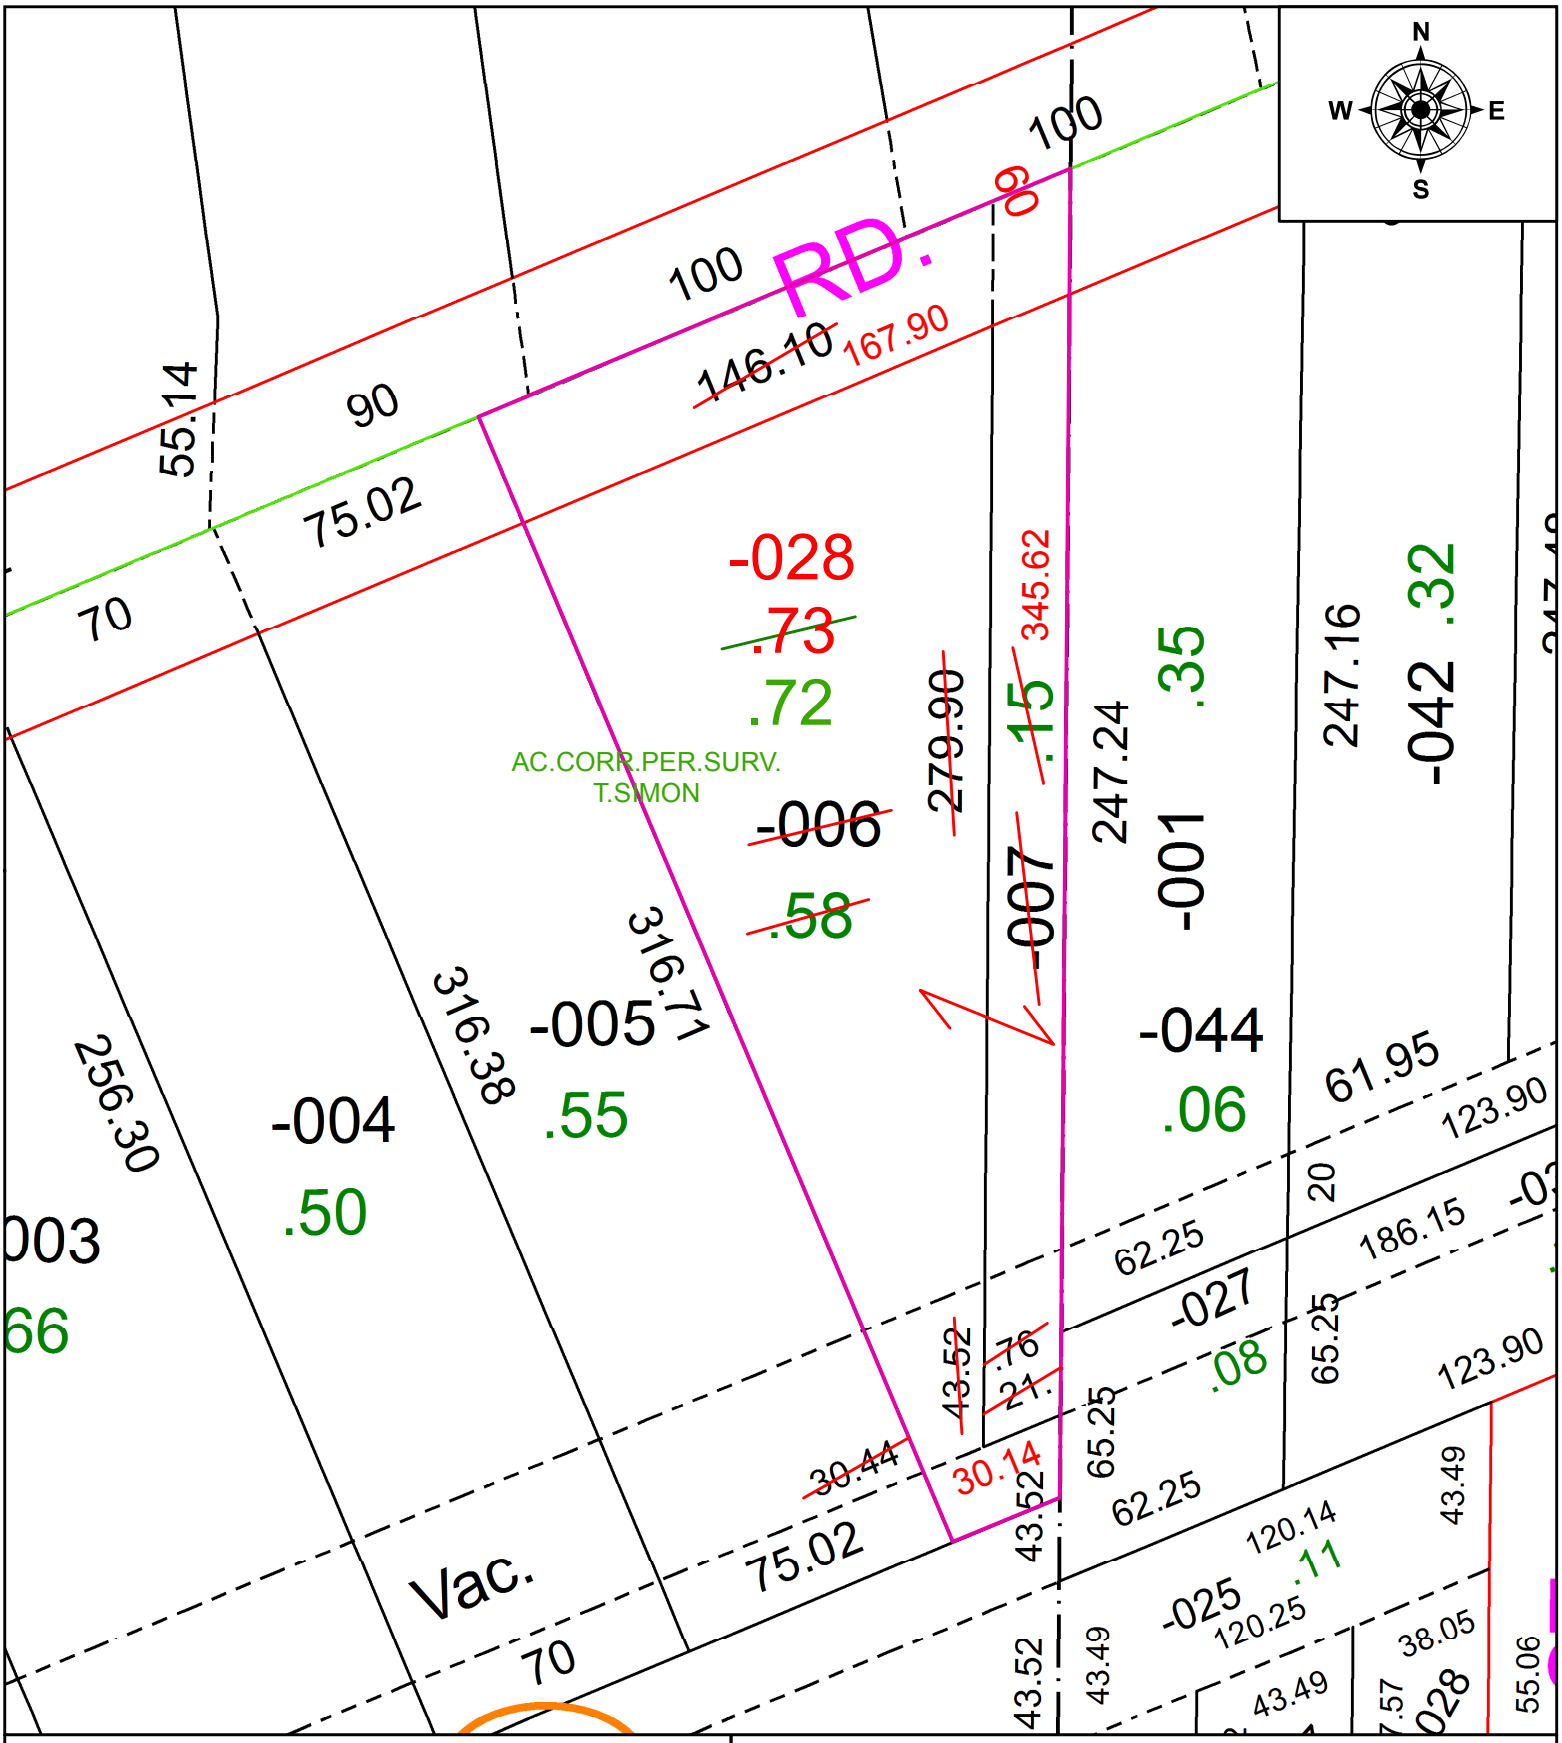

SPLITS/DEEDS PROCESSED

LORAIN COUNTY TAX MAP DEPARTMENT
226 MIDDLE AVE. ELYRIA, OH

SURVEYED BY: THOMAS A. SIMON
CLOSURE: 1:174,251
MAP PAGE(S): 3-00-043
APPOVED BY: RRM **DATE:** 10-9-20
SCALE: 1" = 50 **PRIOR INSTRUMENT:** 20160579543