PARENT PARCEL: 18-00-027-104-002

CHILD PARCEL:

STARTING POINT: INTERSECTION OF C/L OF BENNETT ST. AND C/L OF W. HERRICK AVE.

19-04112-D

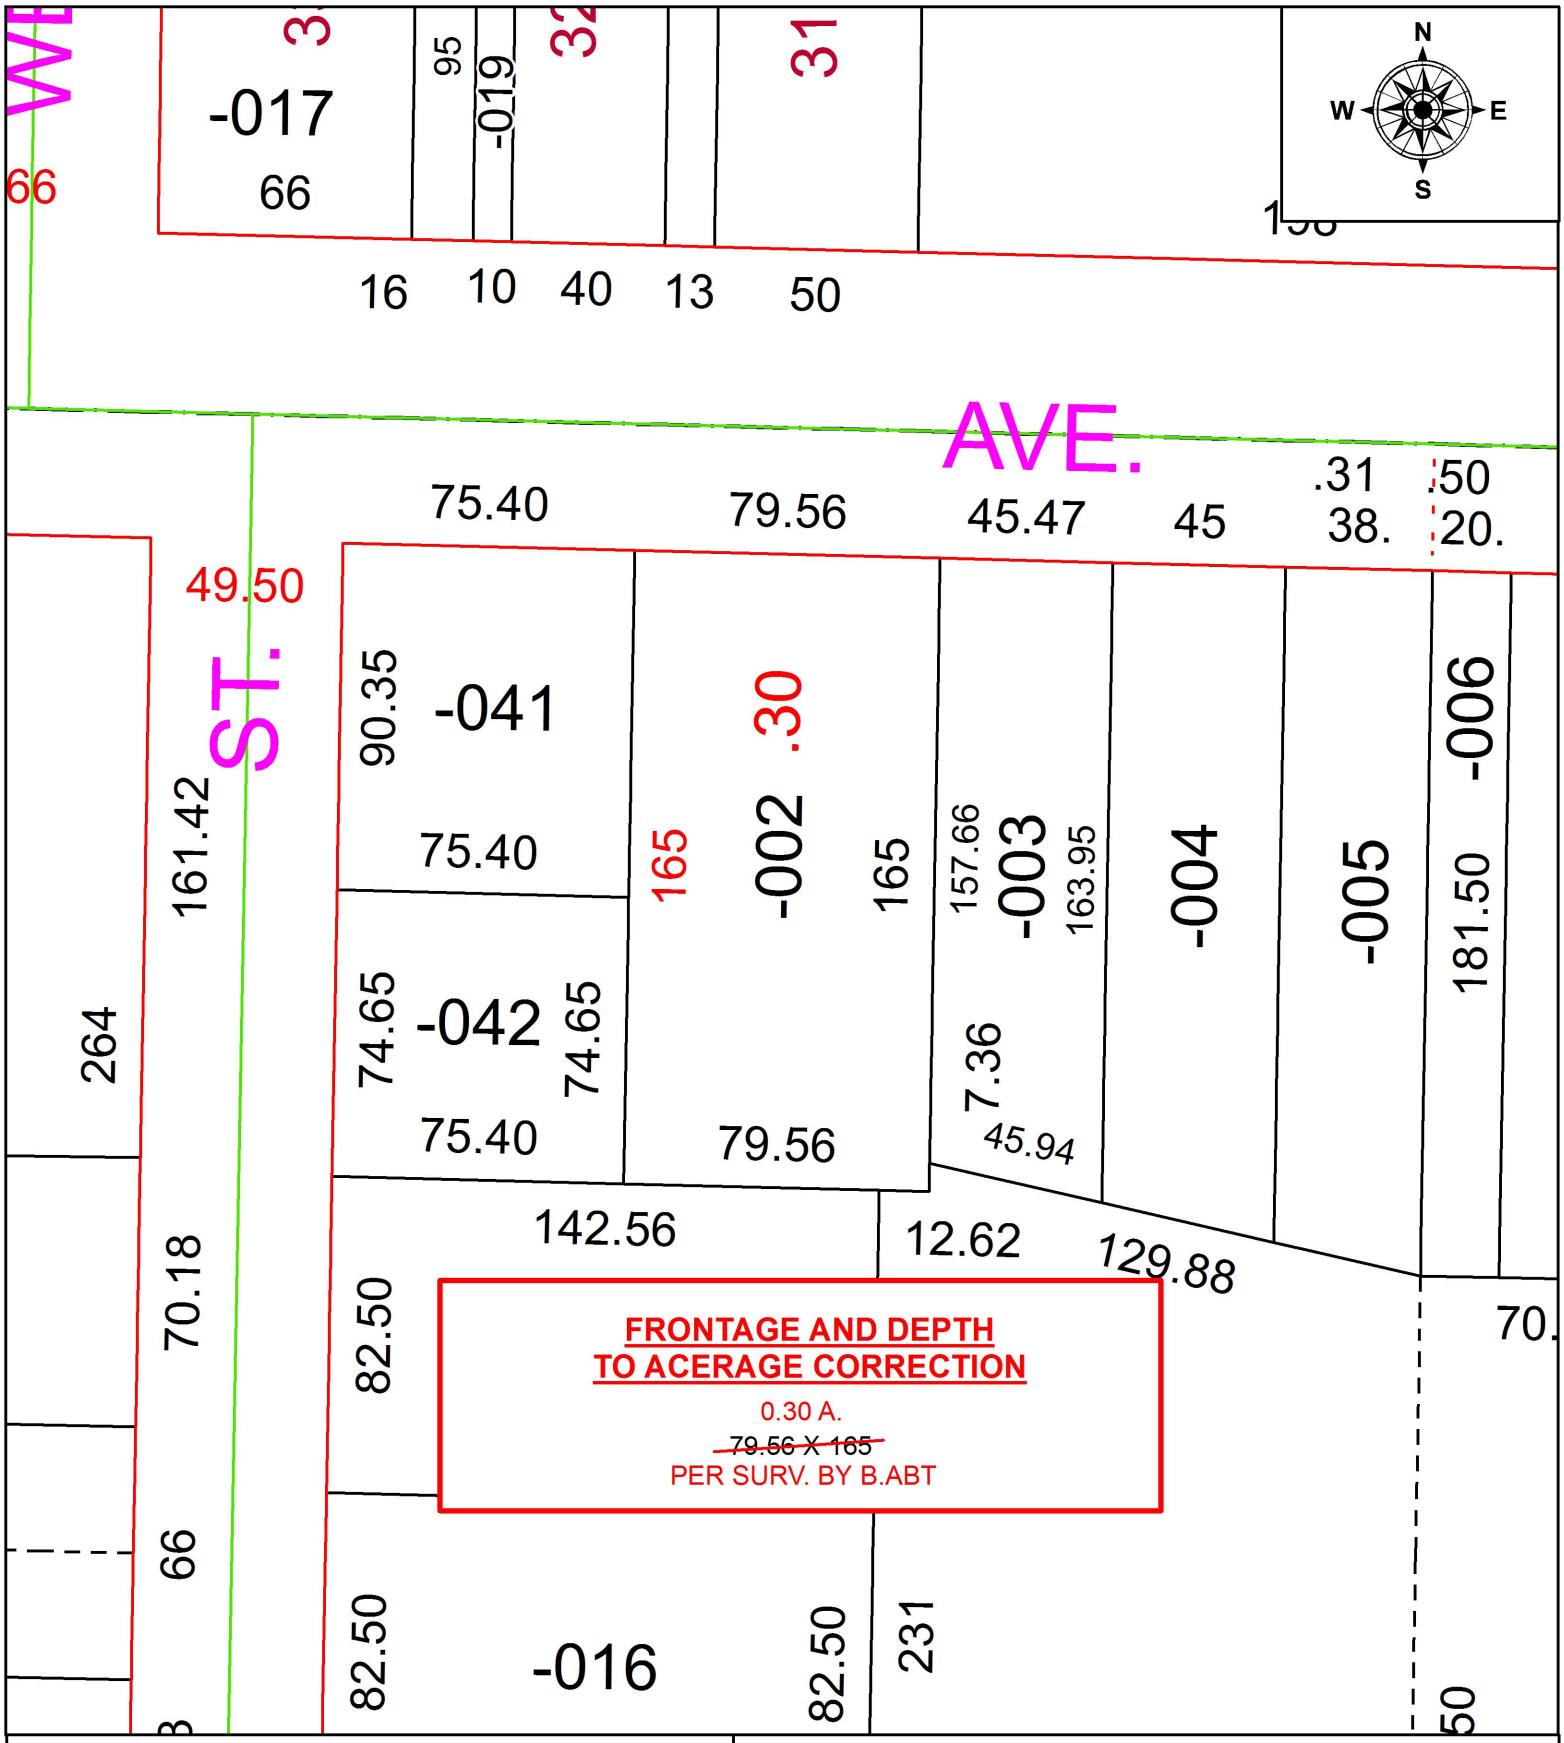

SPLITS/DEEDS PROCESSED

LORAIN COUNTY TAX MAP DEPARTMENT
226 MIDDLE AVE. ELYRIA, OH

SURVEYED BY: BRYANT ABT
CLOSURE: 1:2147483648
MAP PAGE(S): 18-00-027
APPOVED BY: RRM **DATE:** 6-10-19
SCALE: 1" = 50 **PRIOR INSTRUMENT:** 20190709575