PARENT PARCEL: 07-00-014-101-039

CHILD PARCEL: 07-00-014-101-040 THRU -042

STARTING POINT: INTERSECTION OF C/L OF CHESTNUT RIDGE RD. AND C/L OF ROOT RD.

20-04115

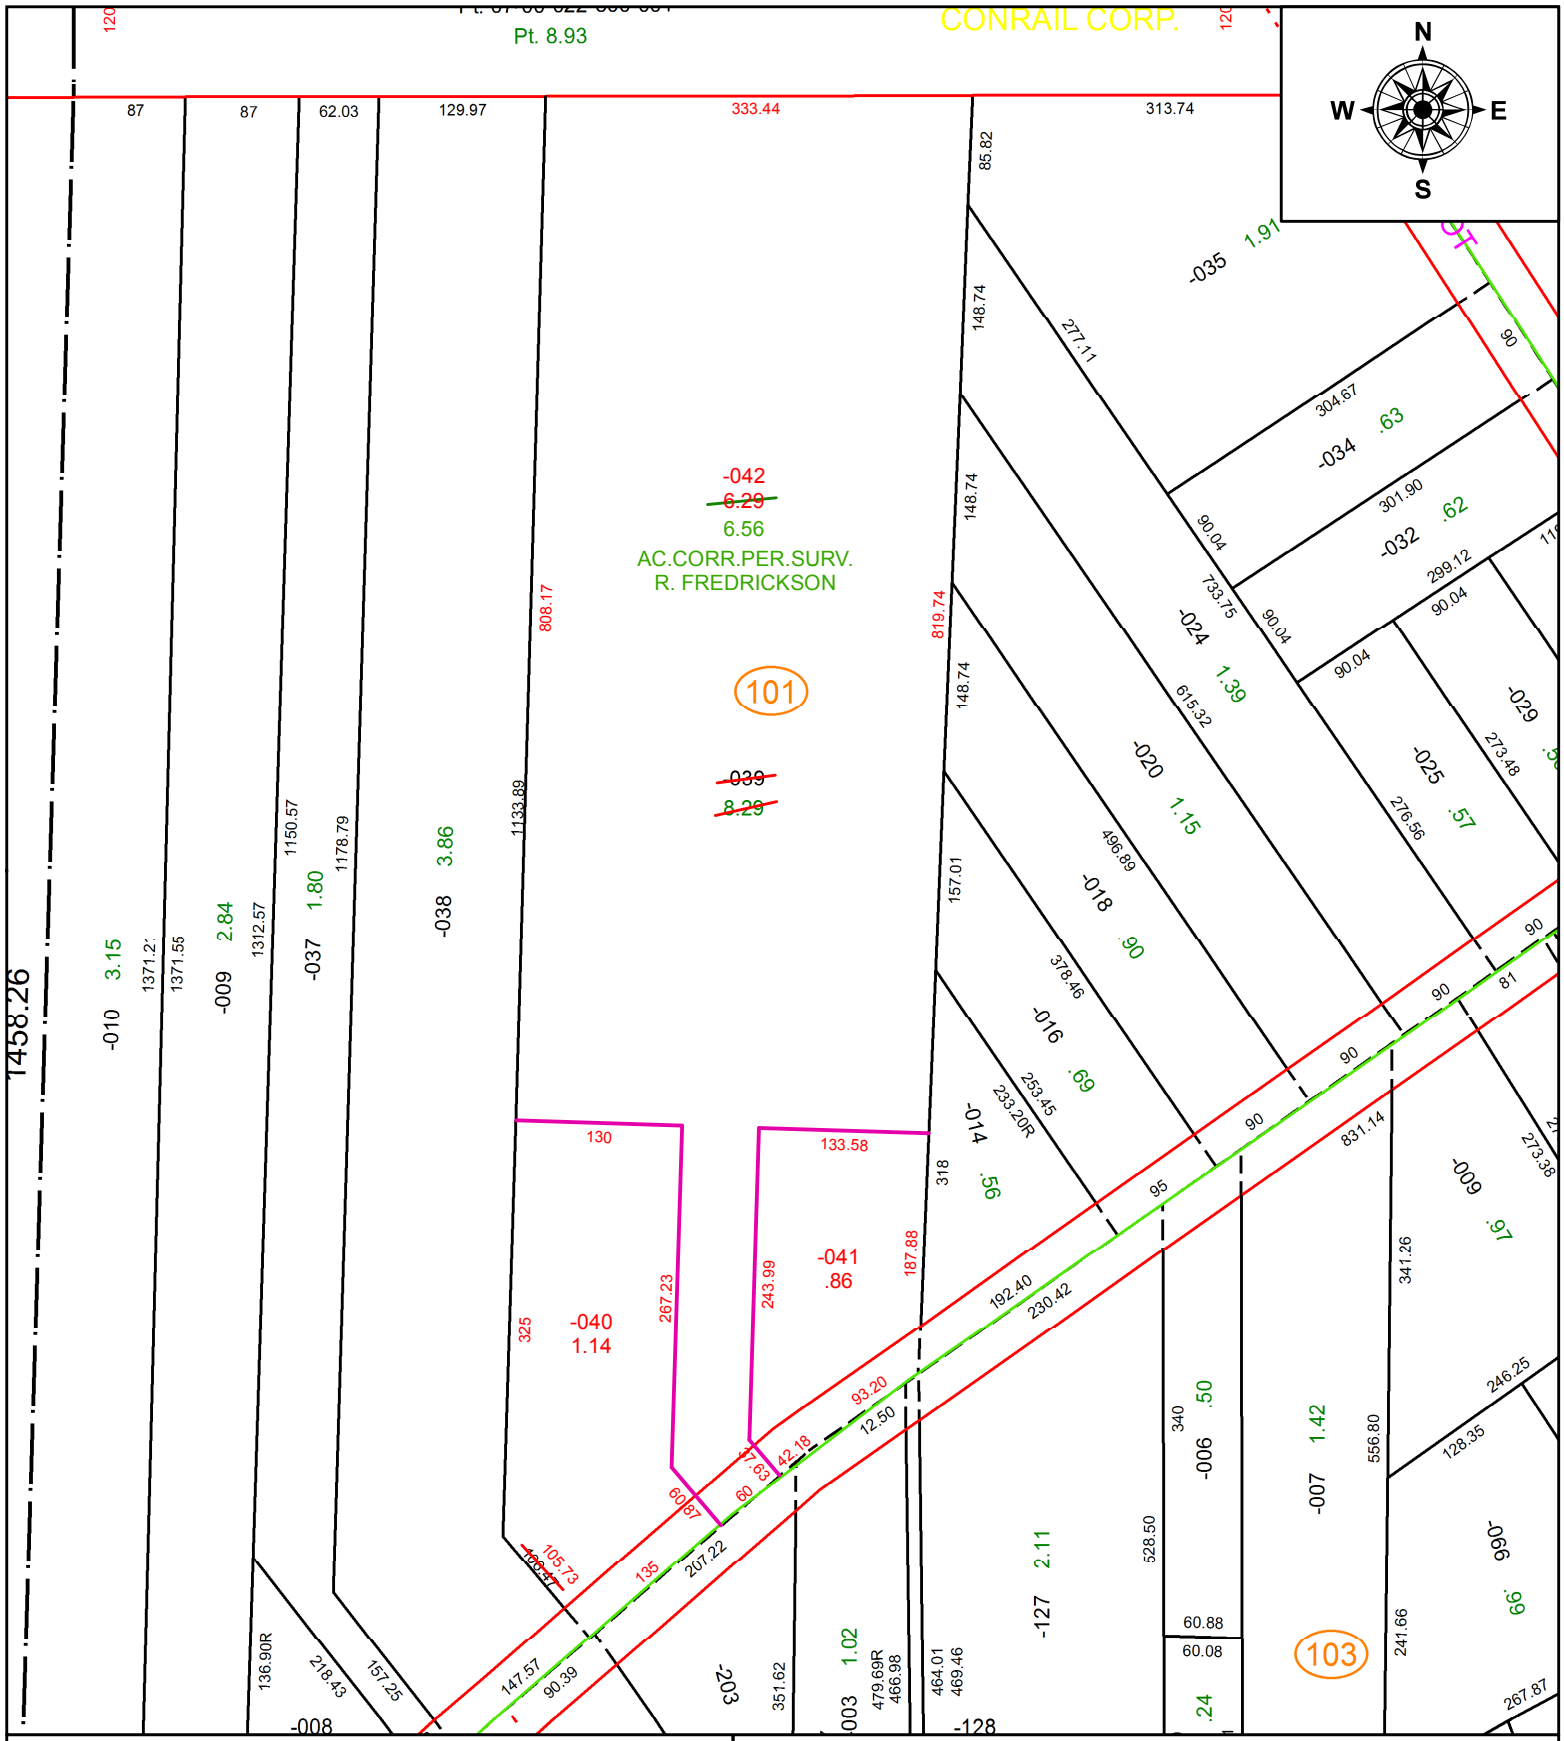

SPLITS/DEEDS PROCESSED

LORAIN COUNTY TAX MAP DEPARTMENT
226 MIDDLE AVE. ELYRIA, OH

SURVEYED BY: RICHARD A. FREDRICKSON
CLOSURE: 1:146,895
MAP PAGE(S): 7-00-014
APPOVED BY: RRM **DATE:** 4-20-20
SCALE: 1" = 150 **PRIOR INSTRUMENT:** 20200746843