PARENT PARCEL: 11-00-097-000-034

CHILD PARCEL: 11-00-097-000-042, -043

STARTING POINT: INTERSECTION OF C/L OF CAPEL RD. AND C/L OF GRAFTON RD.

20-04116

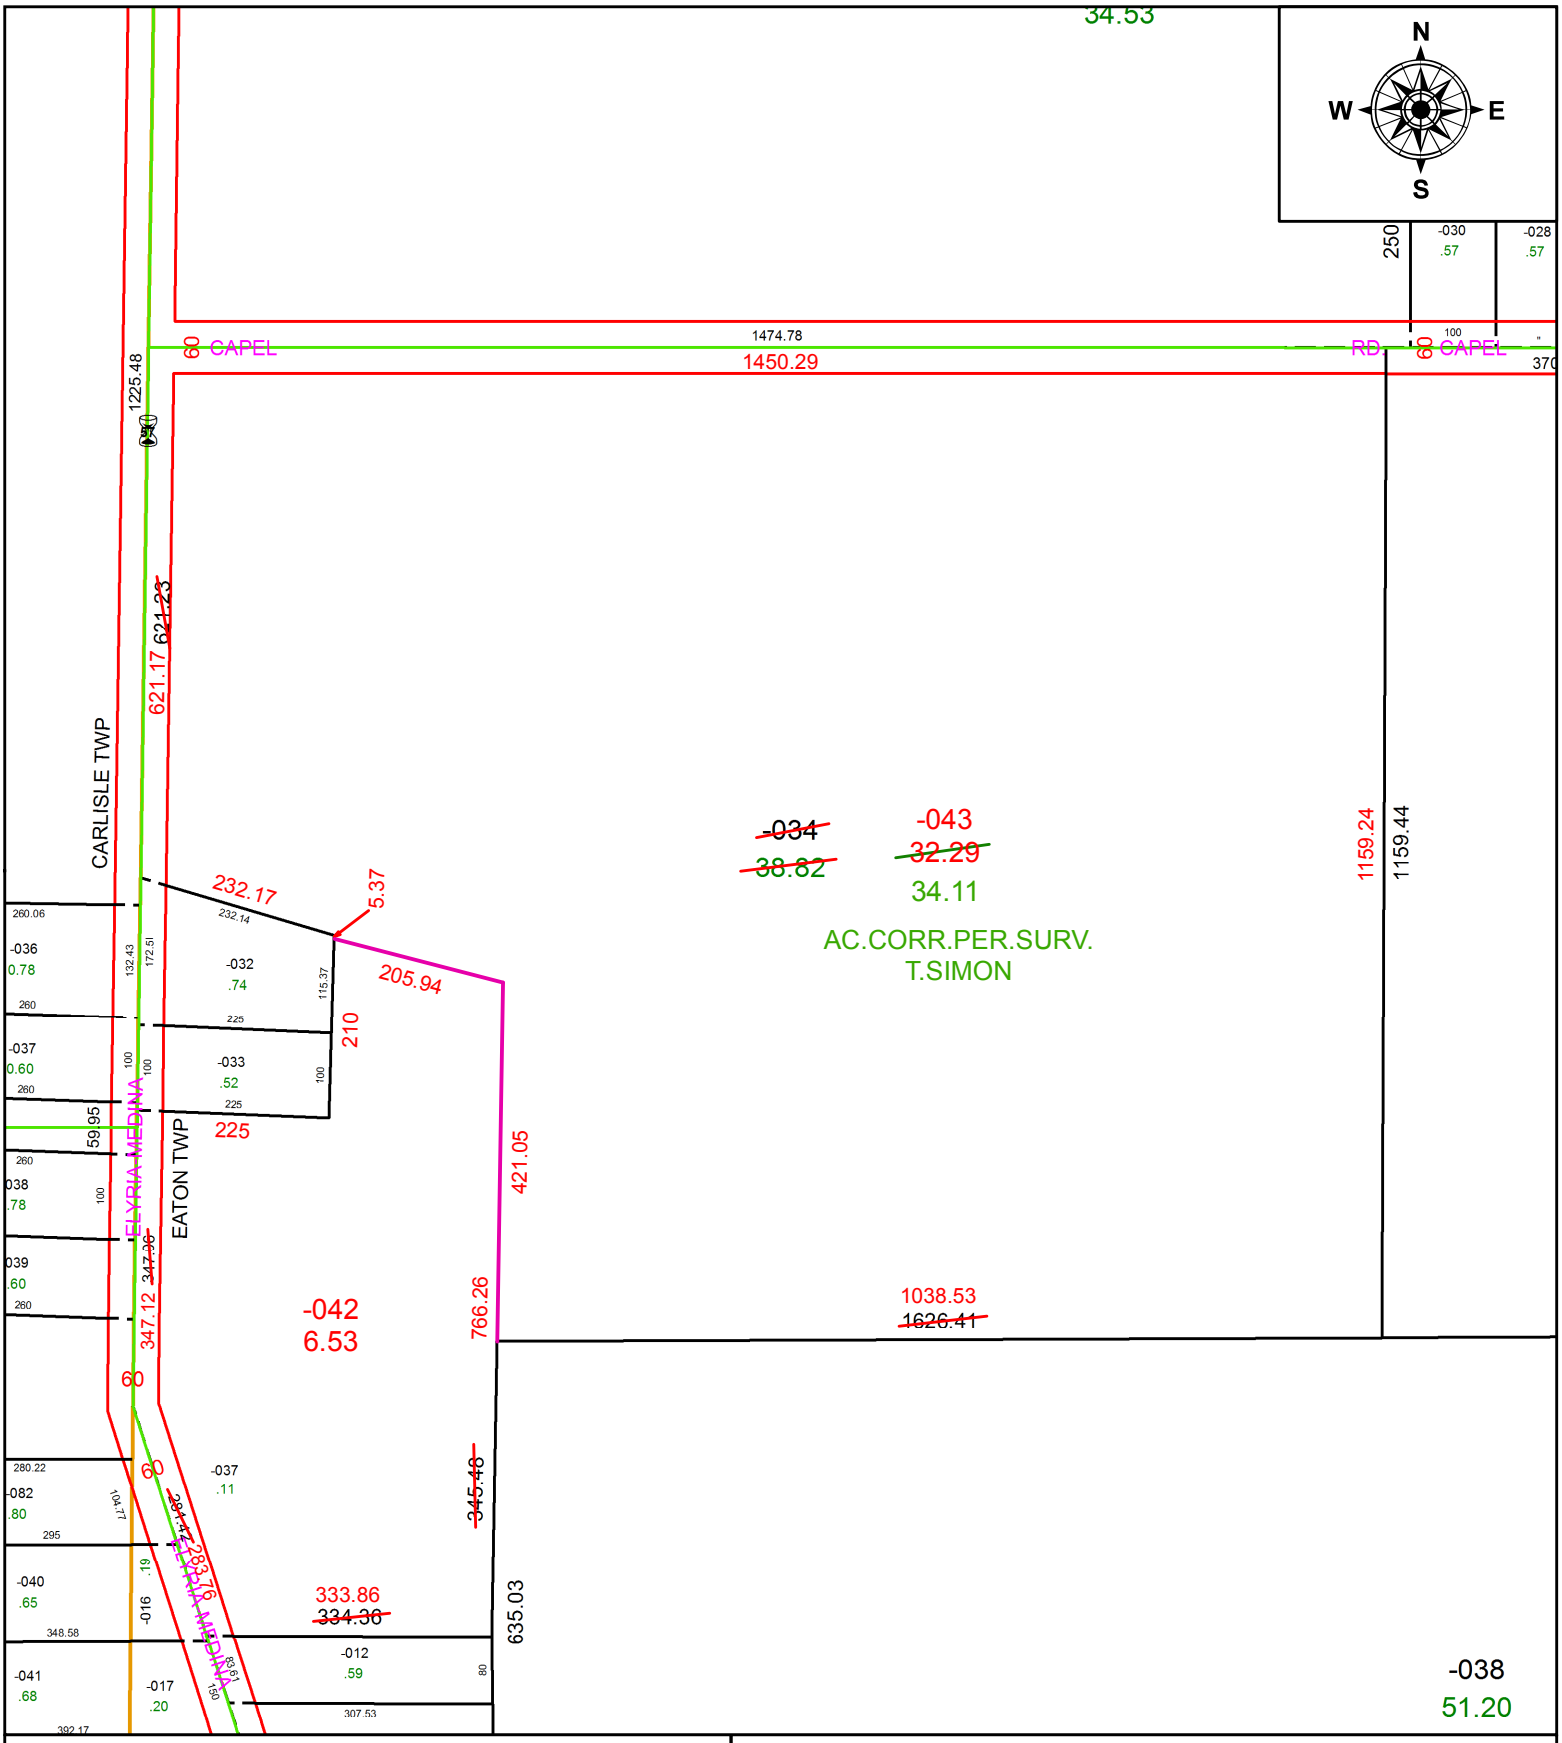

SPLITS/DEEDS PROCESSED

LORAIN COUNTY TAX MAP DEPARTMENT
226 MIDDLE AVE. ELYRIA, OH

SURVEYED BY: THOMAS A. SIMON
CLOSURE: 1:572,016
MAP PAGE(S): 11-00-097
APPOVED BY: RRM **DATE:** 4-22-20
SCALE: 1" = 225 **PRIOR INSTRUMENT:** 20090280480