PARENT PARCEL: 05-00-062-101-034, -085

CHILD PARCEL: 05-00-062-101-090

STARTING POINT: INTERSECTION OF C/L OF KAY AVE. AND C/L OF OBERLIN RD.

20-04122

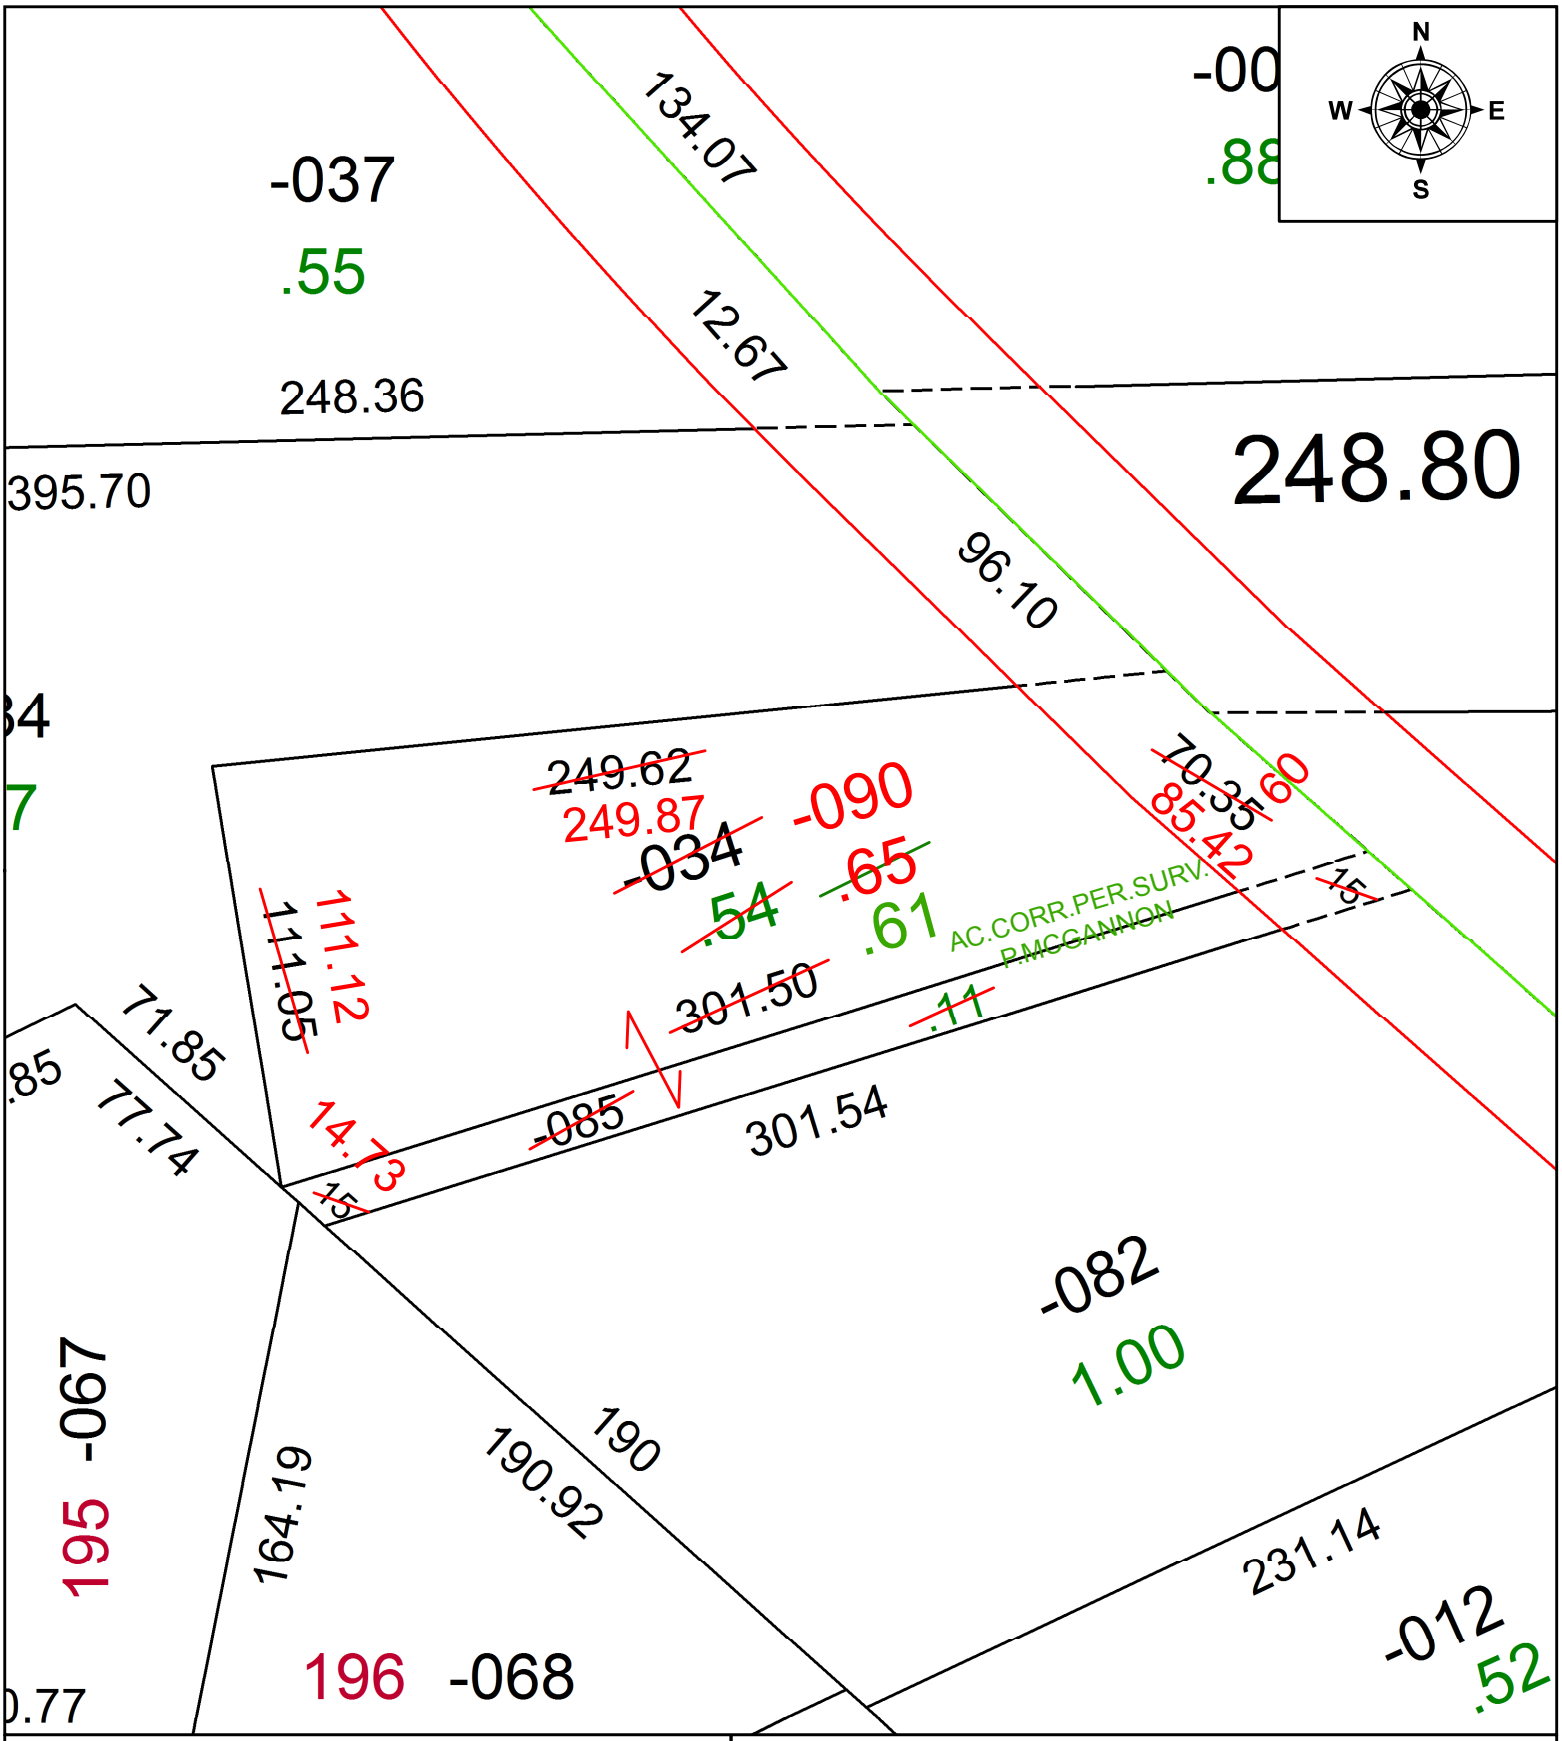

SPLITS/DEEDS PROCESSED

LORAIN COUNTY TAX MAP DEPARTMENT
226 MIDDLE AVE. ELYRIA, OH

SURVEYED BY: PATRICK A. MCGANNON
CLOSURE: 1:69,955
MAP PAGE(S): 5-00-062
APPOVED BY: RRM **DATE:** 5-14-20
SCALE: 1" = 50 **PRIOR INSTRUMENT:** 20010732065