PARENT PARCEL: 08-00-092-103-003

CHILD PARCEL:

STARTING POINT: INTERSECTION OF C/L OF S.R. 113 AND C/L OF VERMILION RD.

19-04123-A

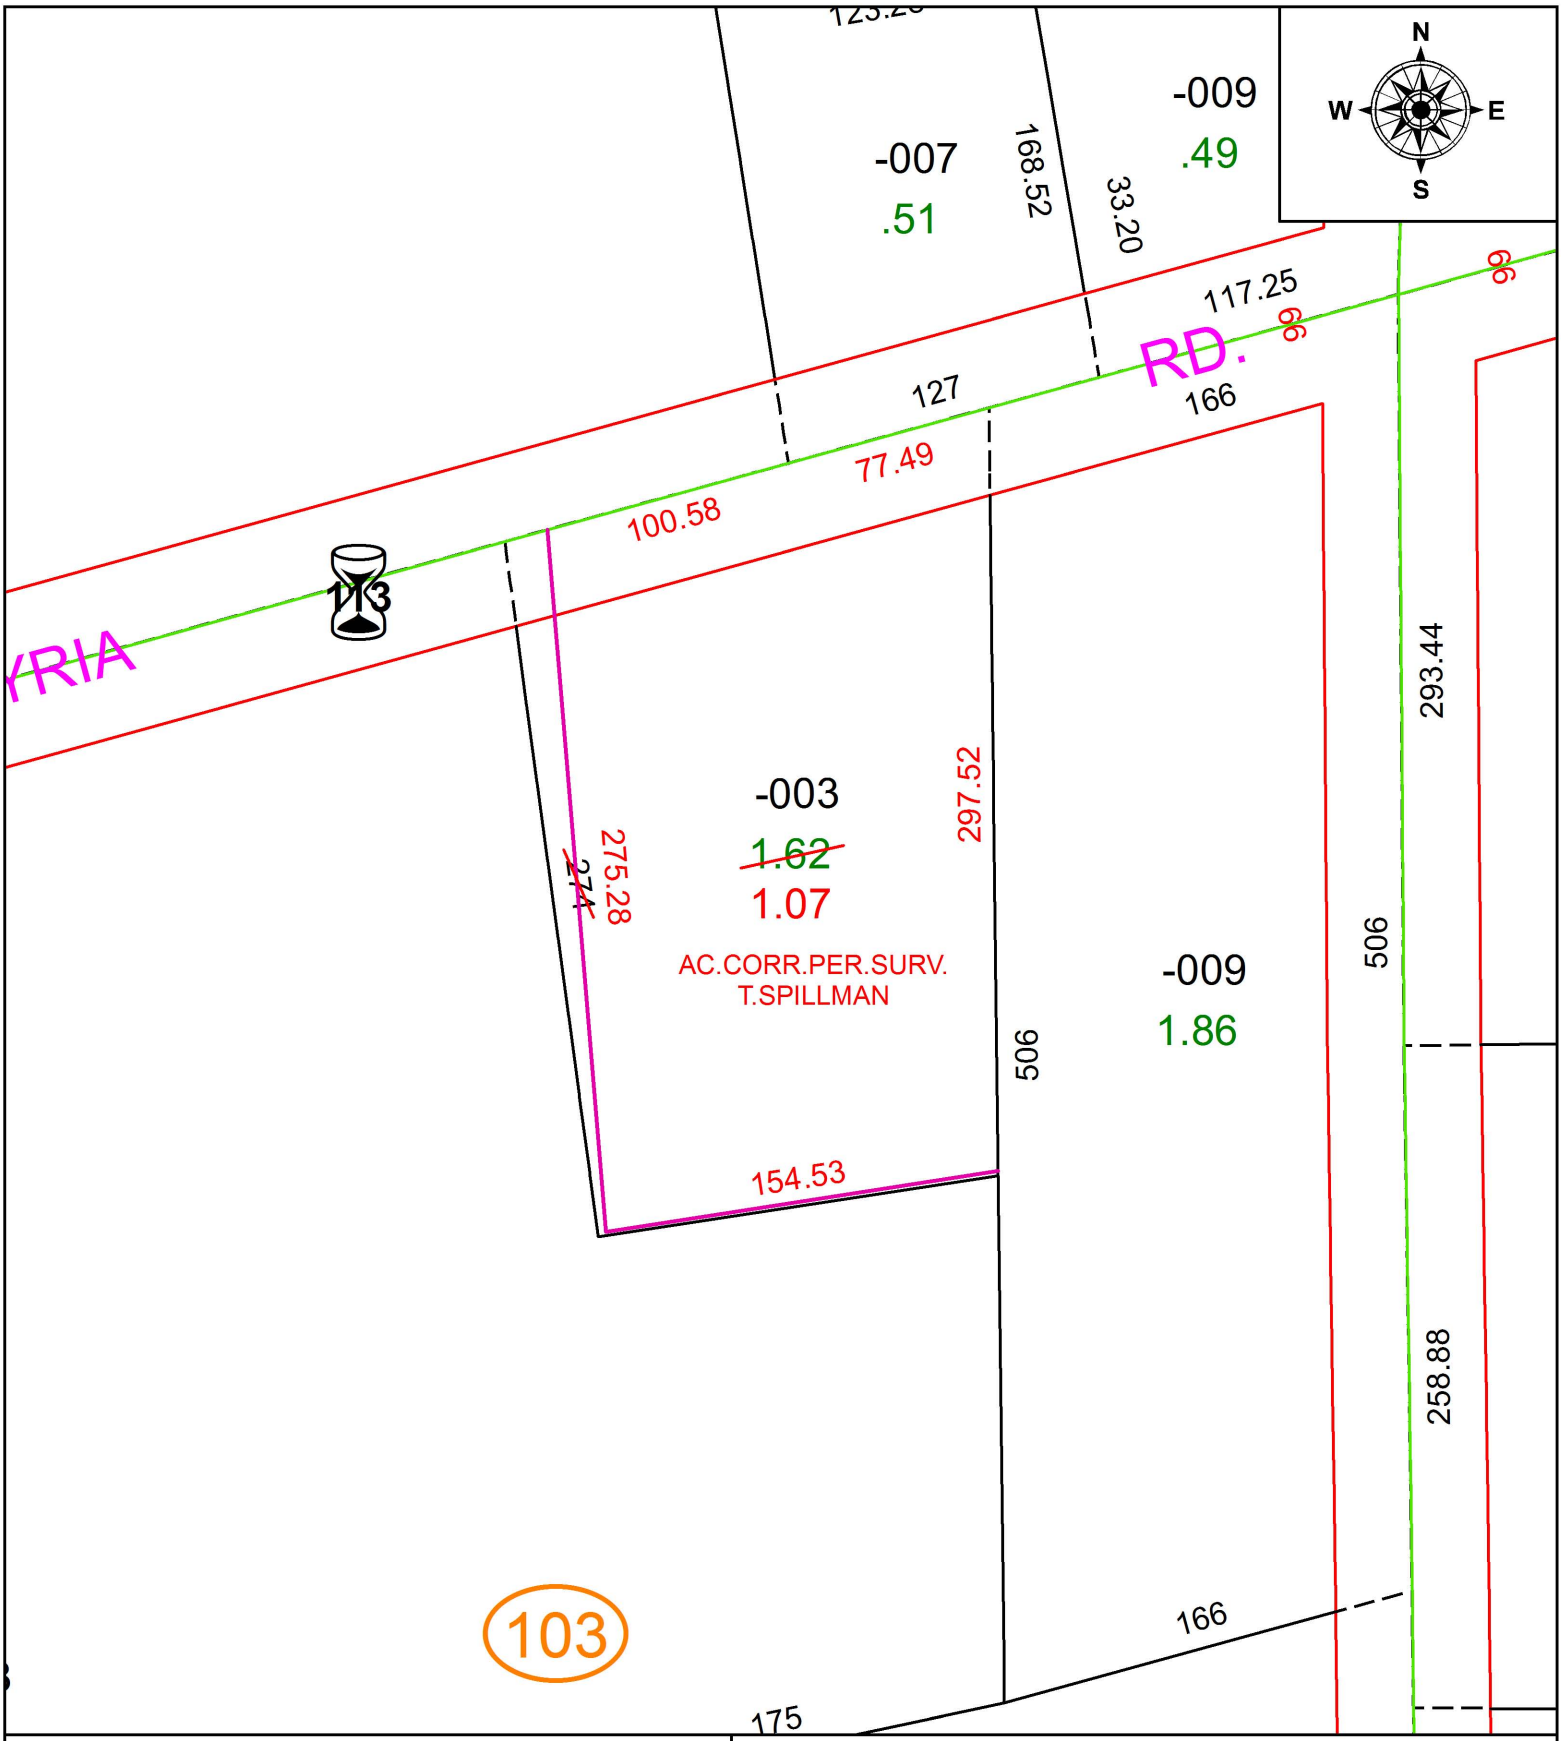

SPLITS/DEEDS PROCESSED

LORAIN COUNTY TAX MAP DEPARTMENT
226 MIDDLE AVE. ELYRIA, OH

SURVEYED BY: THEODORE J. SPILLMAN
CLOSURE: 1:162,071
MAP PAGE(S): 8-00-092
APPOVED BY: RRM **DATE:** 6-26-19
SCALE: 1" = 75 **PRIOR INSTRUMENT:** 19990592229