PARENT PARCEL: 03-00-036-101-001

CHILD PARCEL:

STARTING POINT: INTERSECTION OF C/L OF EAST LAKE RD, AND C/L OF LAFAYETTE BLVD.

19-04124-A

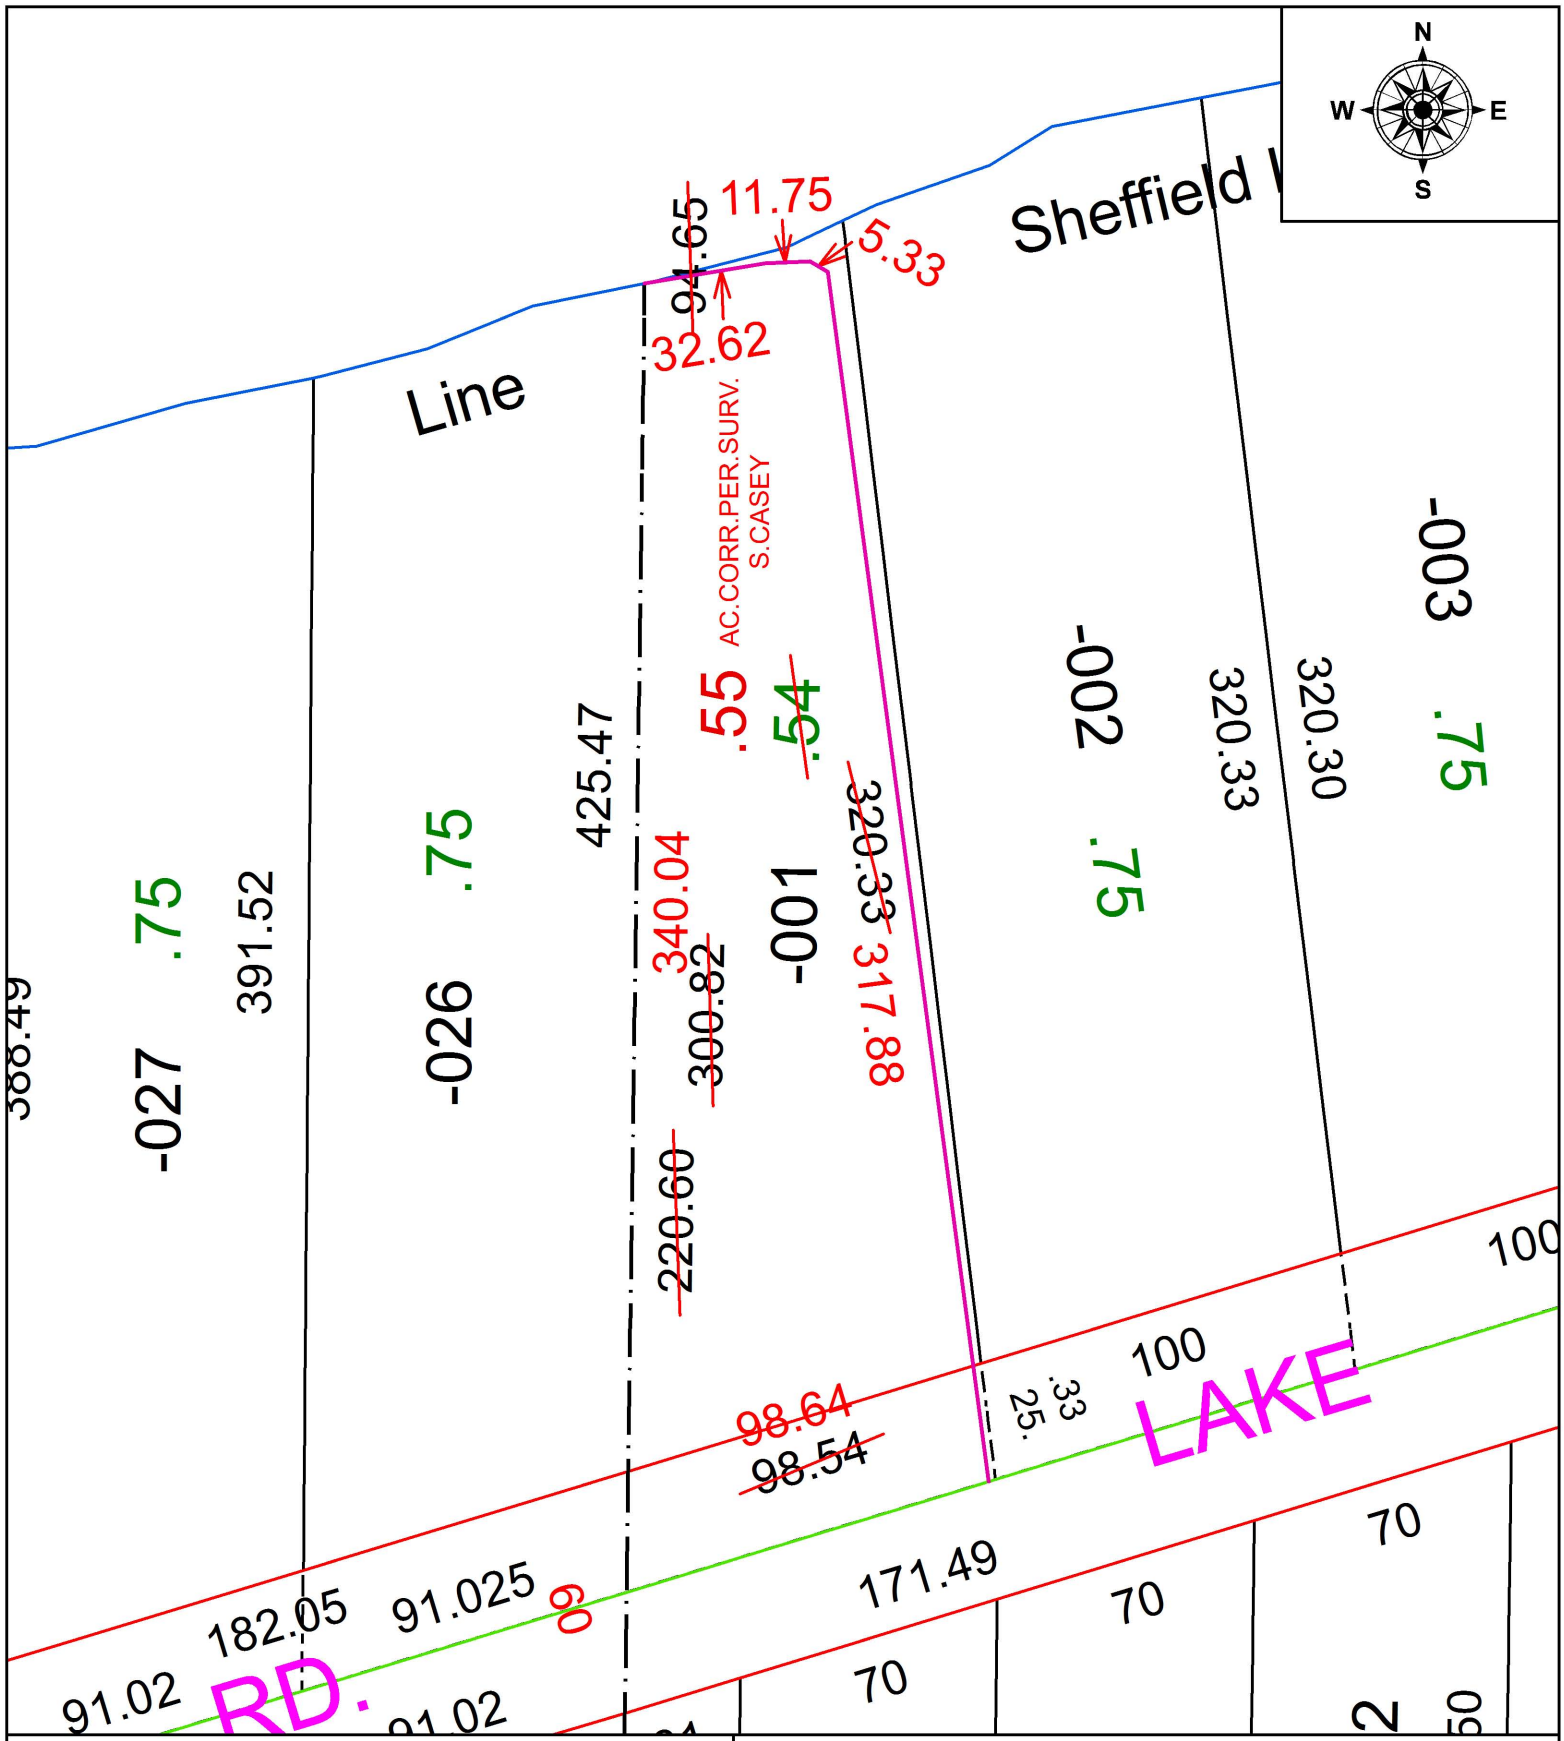

SPLITS/DEEDS PROCESSED

LORAIN COUNTY TAX MAP DEPARTMENT
226 MIDDLE AVE. ELYRIA, OH

SURVEYED BY: SCOTT J. CASEY
CLOSURE: 1:69,471
MAP PAGE(S): 3-00-036
APPOVED BY: RRM **DATE:** 6-27-19
SCALE: 1" = 50 **PRIOR INSTRUMENT:** 20180683951