PARENT PARCEL: 11-00-024-000-006, -033, -045

CHILD PARCEL: 11-00-024-000-085 THRU -090

STARTING POINT: INTERSECTION OF C/L OF REED RD. AND C/L OF CAPEL RD.

20-04124

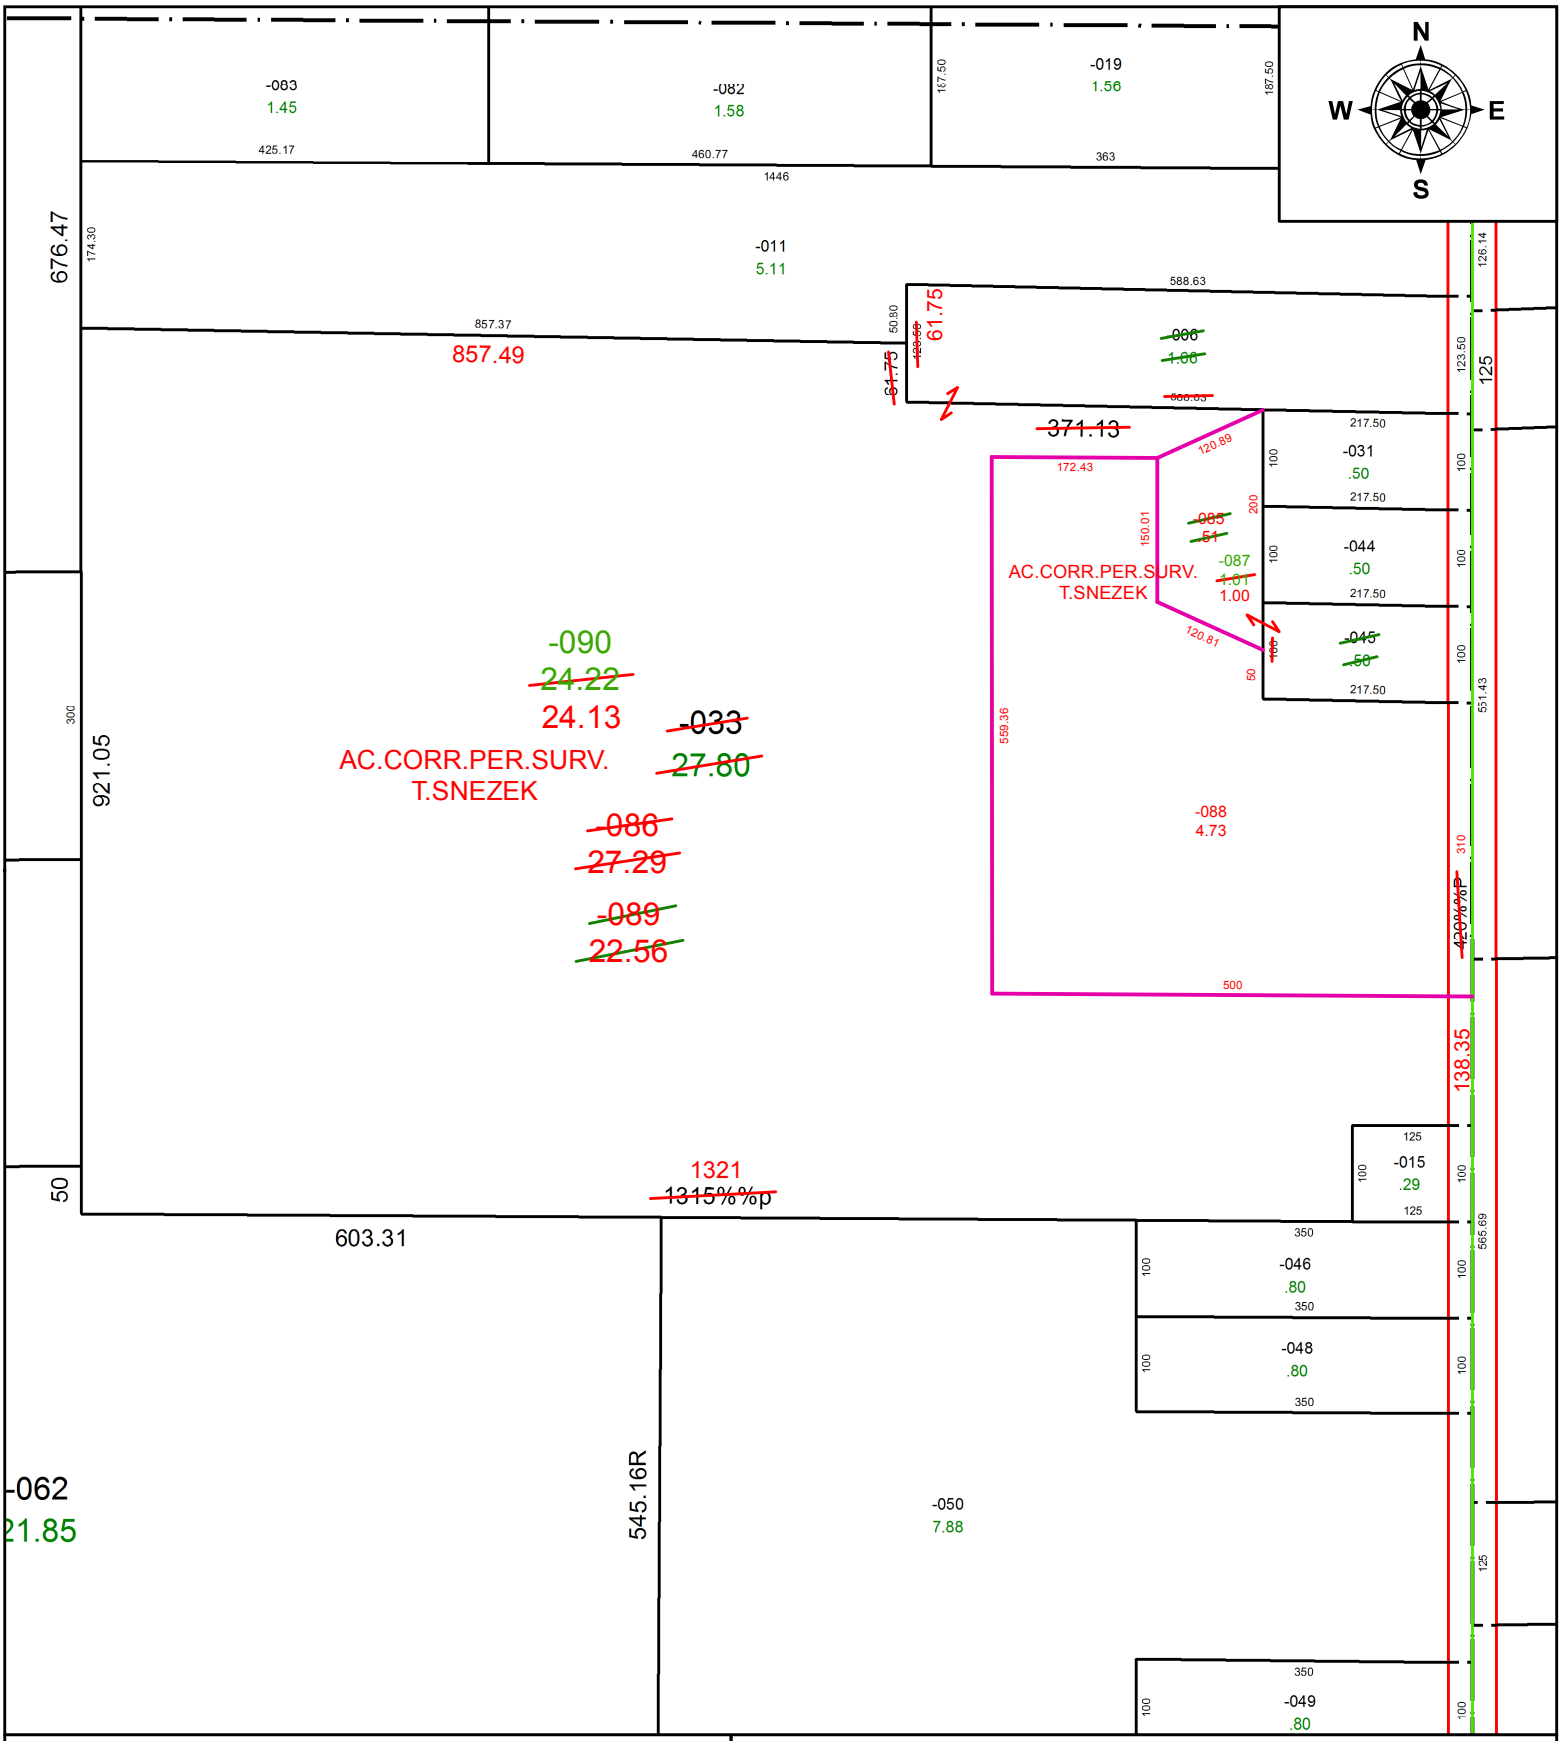

SPLITS/DEEDS PROCESSED

LORAIN COUNTY TAX MAP DEPARTMENT
226 MIDDLE AVE. ELYRIA, OH

SURVEYED BY: THOMAS M. SNEZEK
CLOSURE: 1:206,174
MAP PAGE(S): 11-00-024
APPOVED BY: RRM **DATE:** 5-22-20
SCALE: 1" = 200 **PRIOR INSTRUMENT:** DV 1155/718