PARENT PARCEL: 12-00-015-000-051, -056, -068
CHILD PARCEL: 12-00-015-000-097 THRU -100
STARTING POINT: SOUTHWEST CORNER OF O.L.12

20-04127

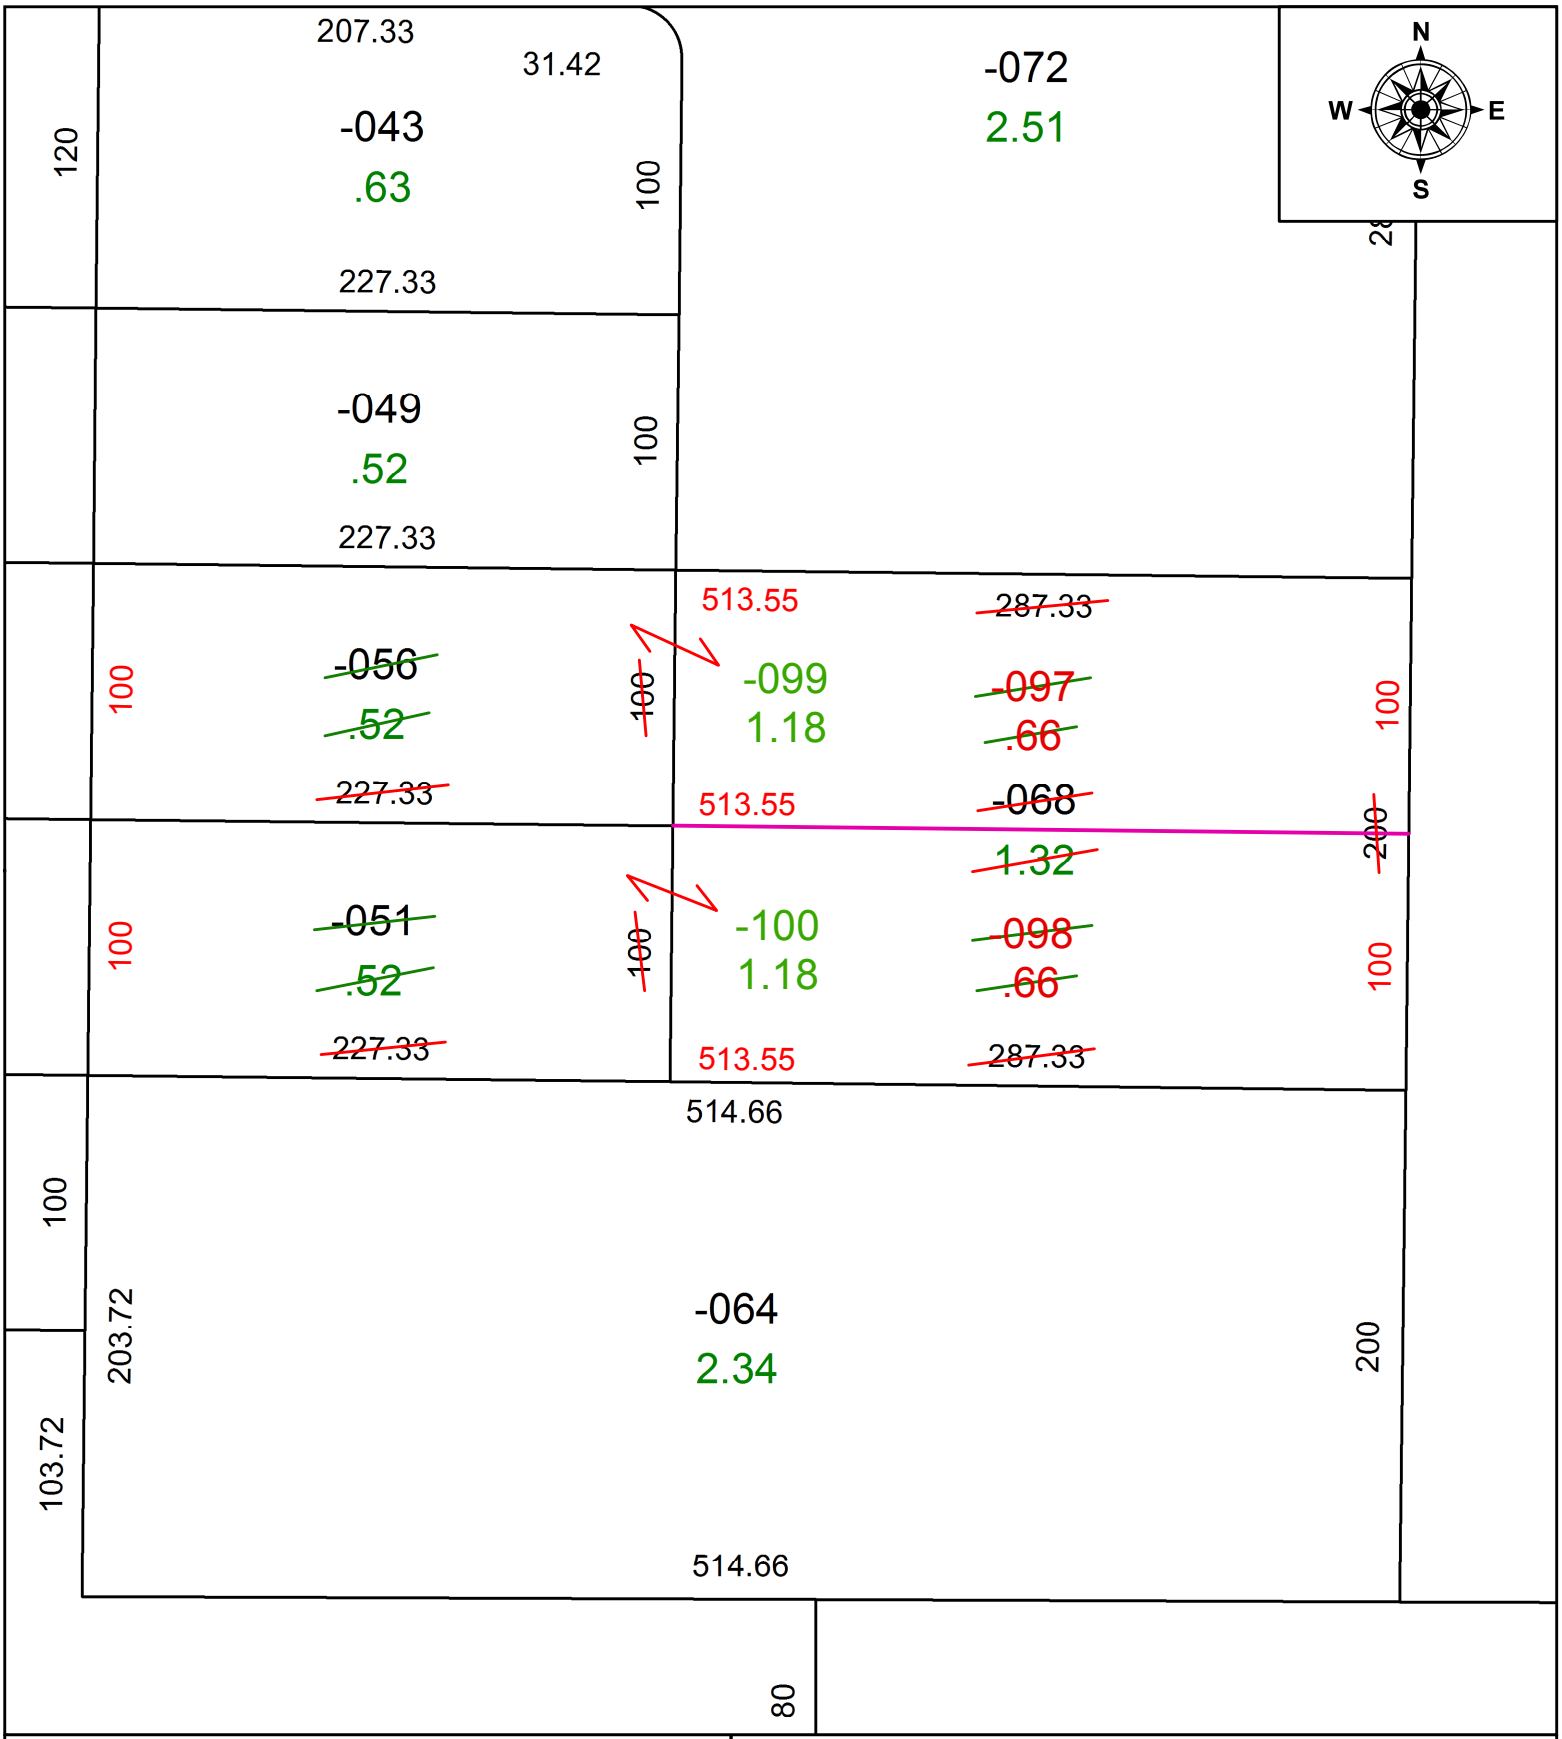

SPLITS/DEEDS PROCESSED
LORAIN COUNTY TAX MAP DEPARTMENT
226 MIDDLE AVE. ELYRIA, OH

SURVEYED BY: ANDREW G. PLANET
CLOSURE: 1:2147483648
MAP PAGE(S): 12-00-015
APPOVED BY: RRM **DATE:** 5-26-20
SCALE: 1" = 75 **PRIOR INSTRUMENT:** 19980582060