PARENT PARCEL: 01-00-029-000-026, 01-00-036-000-005

CHILD PARCEL:

STARTING POINT: INTERSECTION OF C/L OF COOPER FOSTER PARK RD. AND C/L OF SUNNYSIDE RD.

19-04128-A

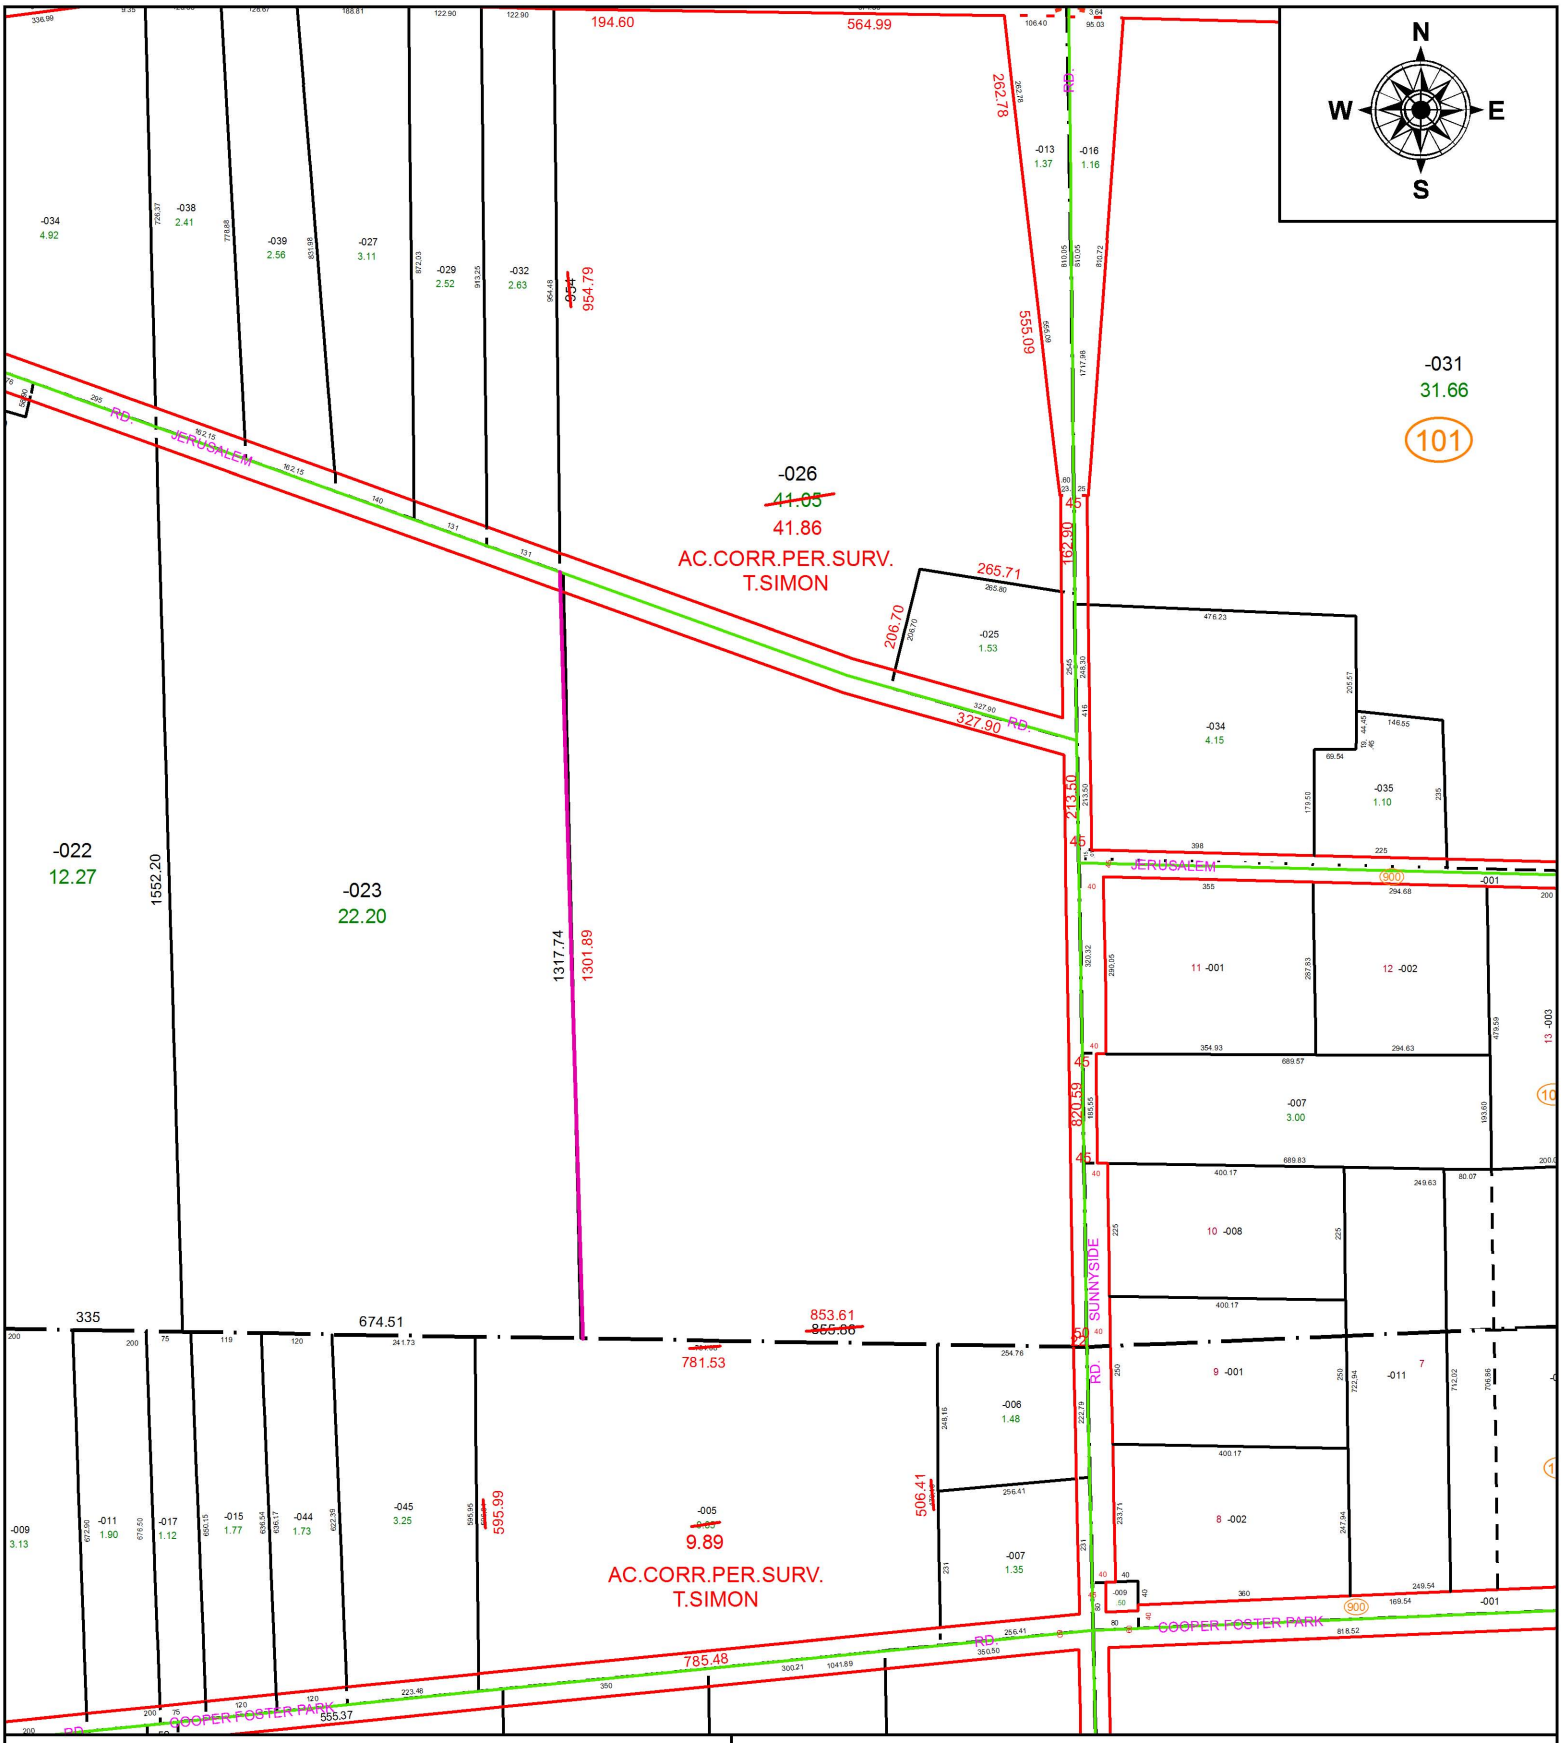

SPLITS/DEEDS PROCESSED

LORAIN COUNTY TAX MAP DEPARTMENT
226 MIDDLE AVE. ELYRIA, OH

SURVEYED BY: THOMAS A. SIMON
CLOSURE: 1:1,059,370
MAP PAGE(S): 1-00-029
APPOVED BY: RRM **DATE:** 6-28-19
SCALE: 1" = 325 **PRIOR INSTRUMENT:** 20190708334