PARENT PARCEL: 13-09-027-000-003, -005

CHILD PARCEL: 13-09-027-000-006 THRU -010

STARTING POINT: NORTHWEST CORNER OF O.L.27

20-04128

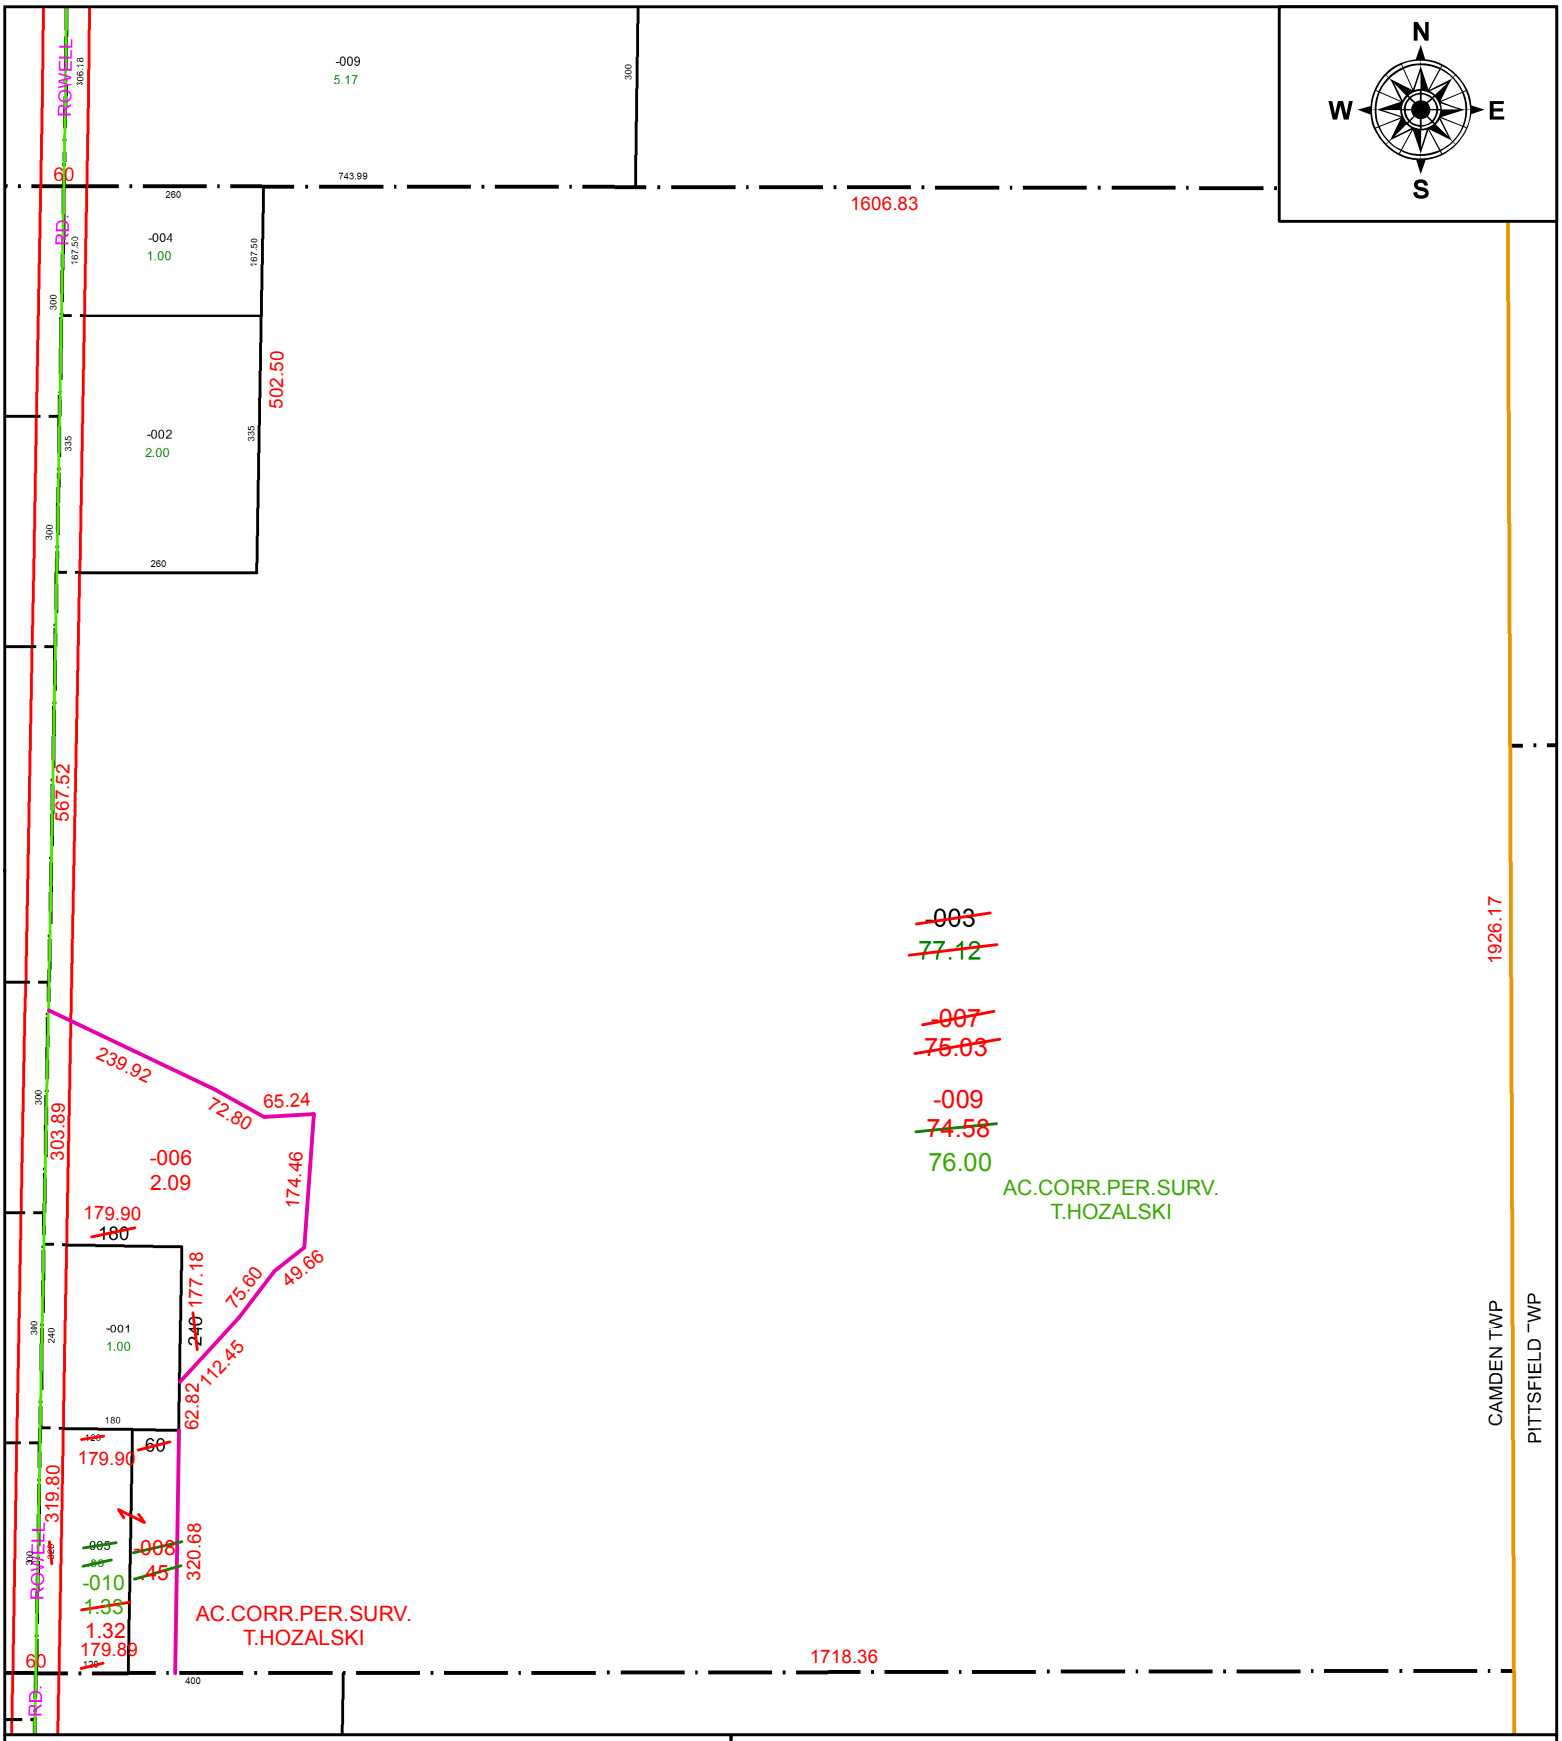

SPLITS/DEEDS PROCESSED

LORAIN COUNTY TAX MAP DEPARTMENT
226 MIDDLE AVE. ELYRIA, OH

SURVEYED BY: TIMOTHY D. HOZALSKI
CLOSURE: 1:298,647
MAP PAGE(S): 13-09-027
APPOVED BY: RRM **DATE:** 5-26-20
SCALE: 1" = 250 **PRIOR INSTRUMENT:** 20200747760