PARENT PARCEL: 05-00-052-000-062, 05-00-053-000-108, 05-00-069-000-001

CHILD PARCEL: 05-00-052-000-062, 05-00-053-000-109 THRU -111, 05-00-069-000-001

STARTING POINT: INTERSECTION OF C/L OF OBERLIN RD. AND C/L OF S.R.113

20-04130

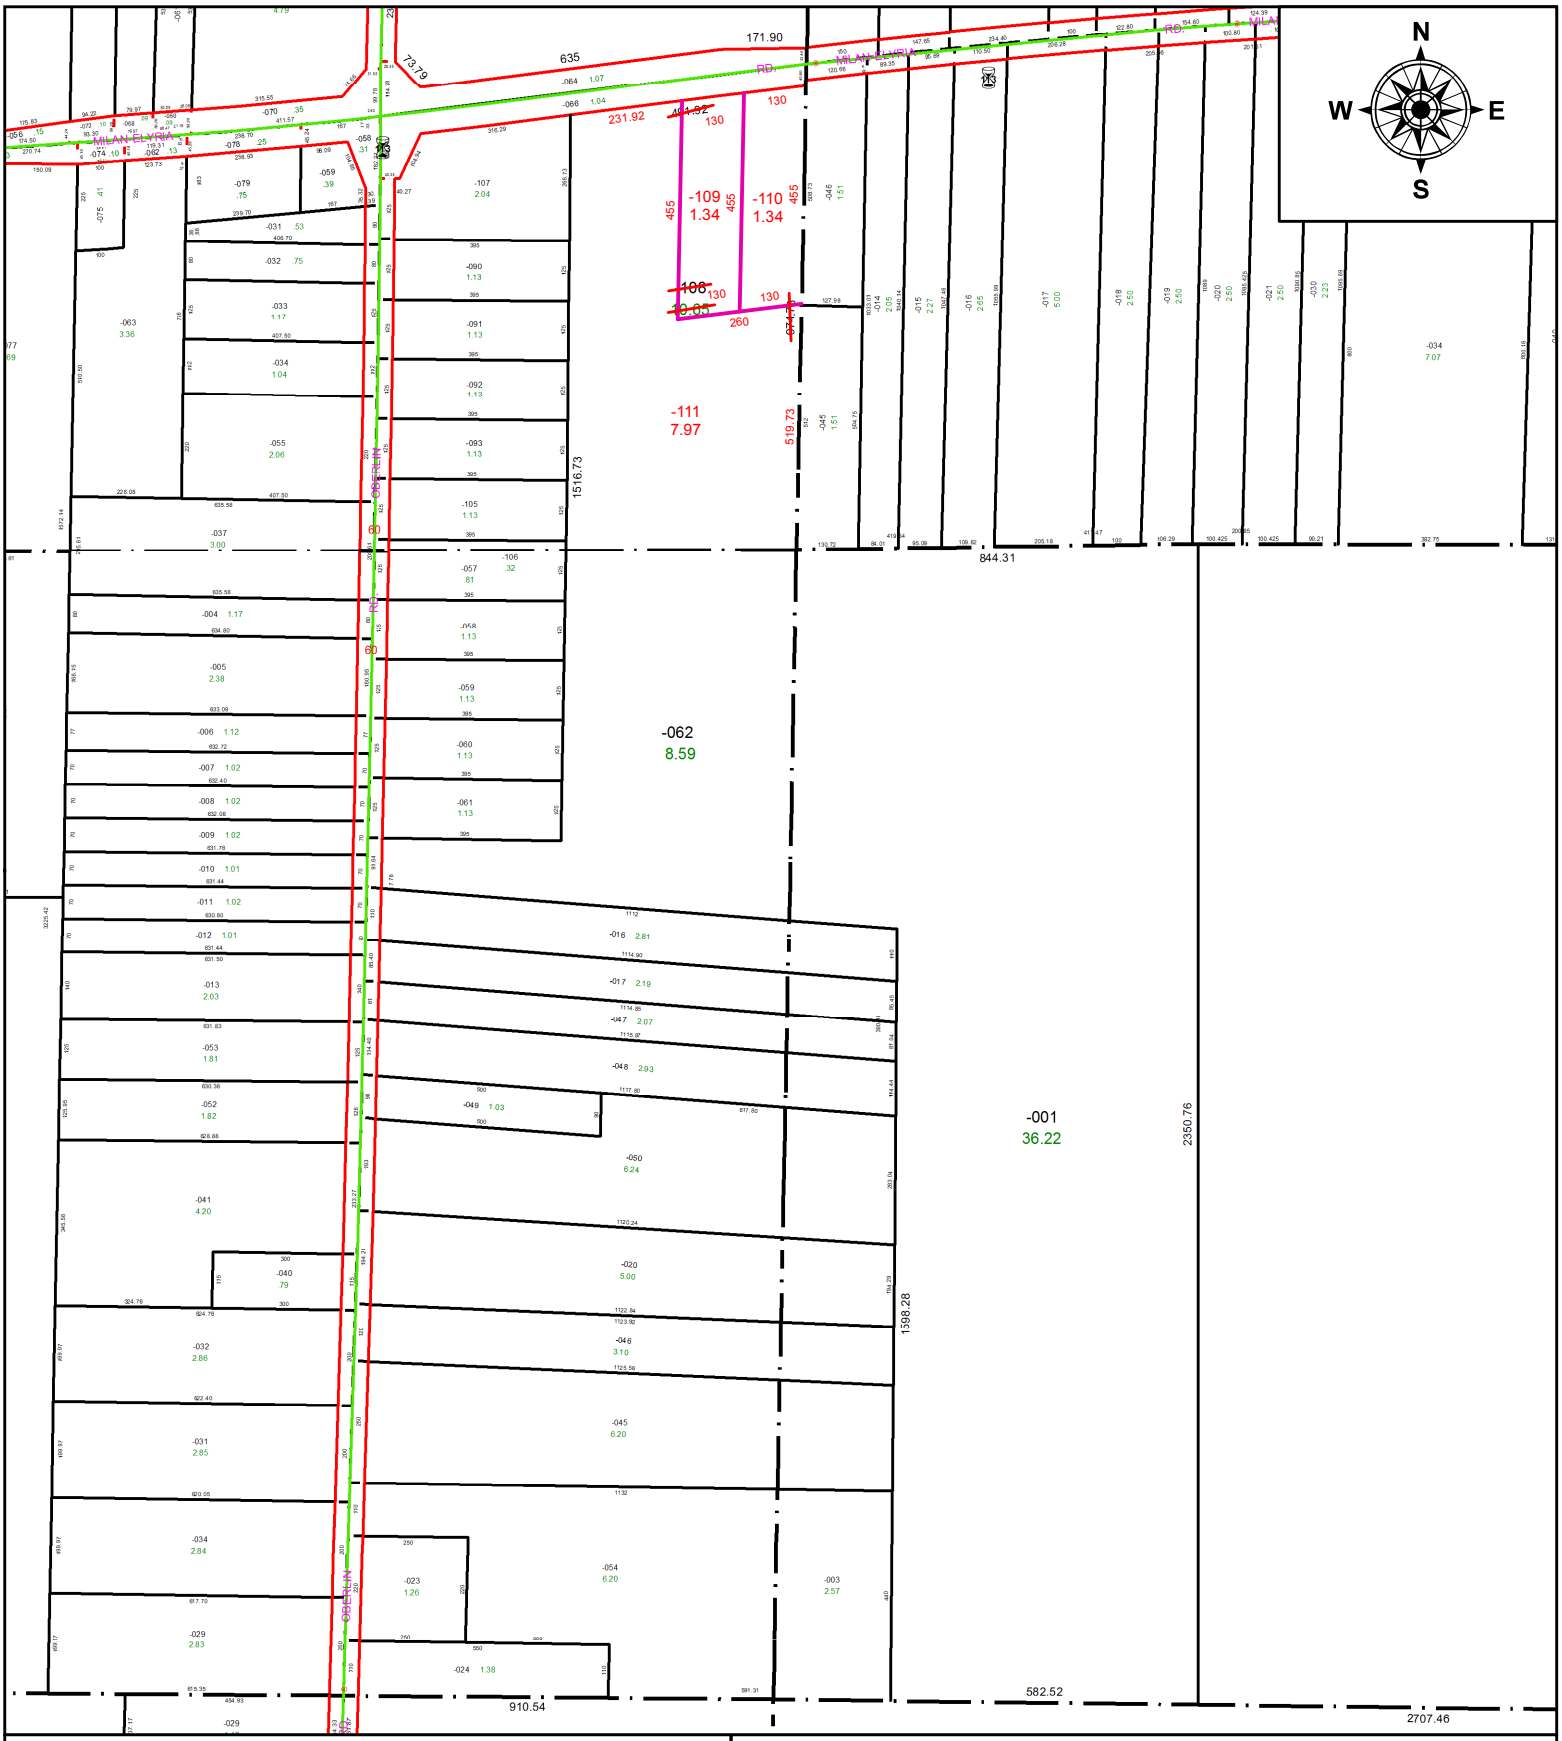

SPLITS/DEEDS PROCESSED

LORAIN COUNTY TAX MAP DEPARTMENT
226 MIDDLE AVE. ELYRIA, OH

SURVEYED BY: THOMAS A, SIMON
CLOSURE: 1:2,179,901
MAP PAGE(S): 5-00-053
APPOVED BY: RRM **DATE:** 6-3-20
SCALE: 1" = 400 **PRIOR INSTRUMENT:** 20200750484