PARENT PARCEL: 03-00-062-000-008, 03-00-063-000-075

CHILD PARCEL: 03-00-062-000-008, 03-00-063-000-076, -077

STARTING POINT: NORTHEAST CORNER OF MARCUS DR.

20-04131

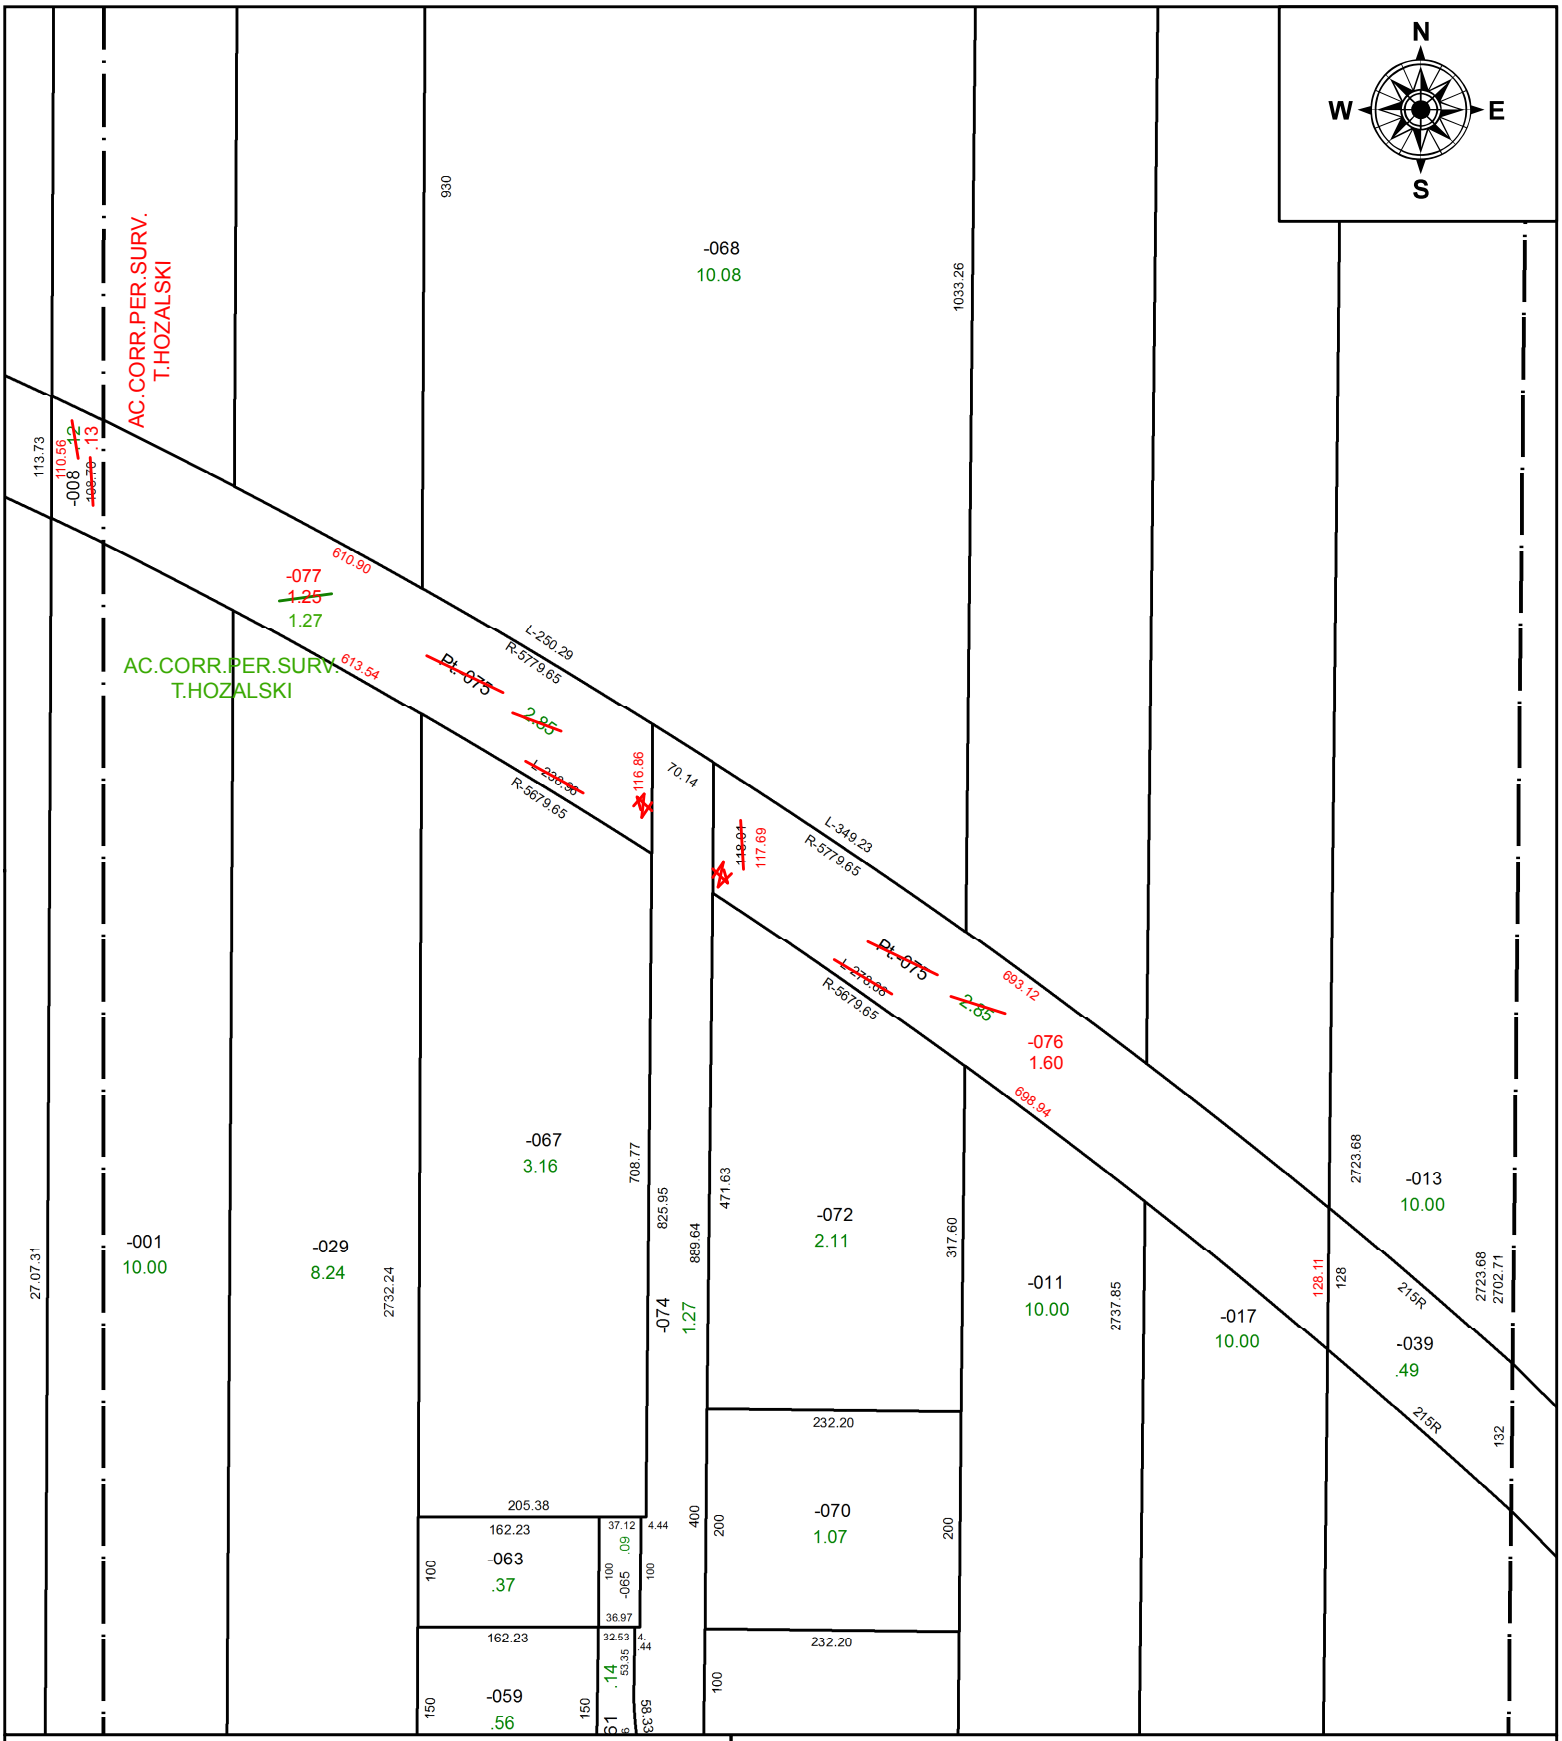

SPLITS/DEEDS PROCESSED

LORAIN COUNTY TAX MAP DEPARTMENT
226 MIDDLE AVE. ELYRIA, OH

SURVEYED BY: TIMOTHY D. HOZALSKI
CLOSURE: 1:188,437
MAP PAGE(S): 3-00-063
APPOVED BY: RRM **DATE:** 6-1-20
SCALE: 1" = 175 **PRIOR INSTRUMENT:** DV 1291/264