PARENT PARCEL: 01-00-036-000-053, -054, 01-00-045-000-039

CHILD PARCEL: 01-00-036-000--057 THRU -059, 01-00-045-000-039

STARTING POINT: INTERSECTION OF COOPER FOSTER PARK RD. AND C/L OF SUNNYSIDE RD.

20-04133

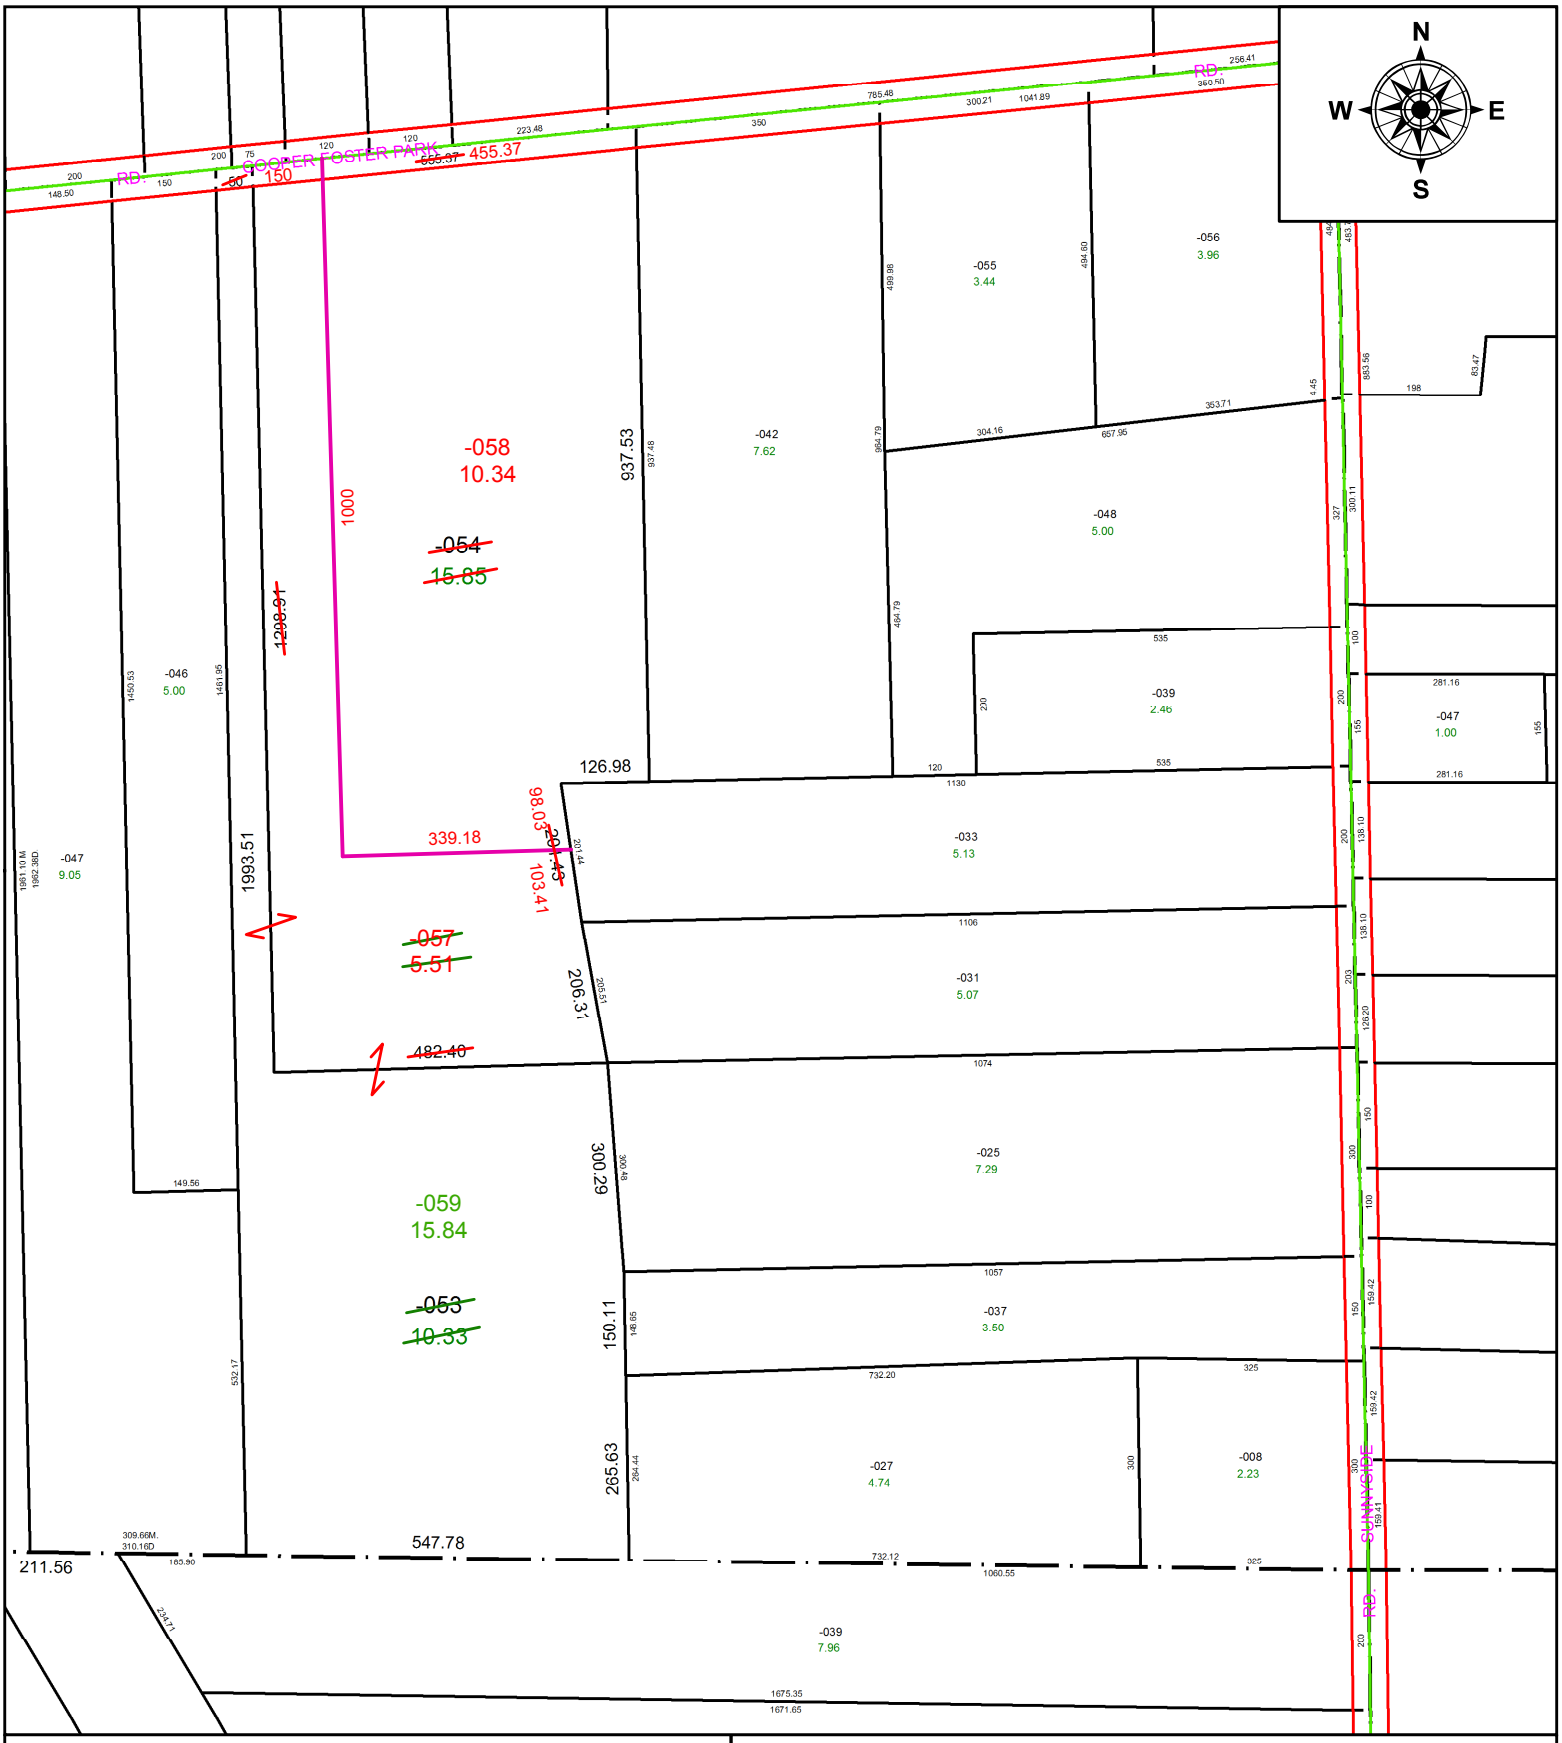

SPLITS/DEEDS PROCESSED

LORAIN COUNTY TAX MAP DEPARTMENT
226 MIDDLE AVE. ELYRIA, OH

SURVEYED BY: THOMAS A. SIMON
CLOSURE: 1:644,504
MAP PAGE(S): 1-00-036
APPOVED BY: RRM **DATE:** 6-5-20
SCALE: 1" = 275 **PRIOR INSTRUMENT:** 20160611950