PARENT PARCEL: 03-00-109-125-004, 06-22-013-101-001, -002, -003, -008, 06-22-013-800-001

CHILD PARCEL: 03-00-109-125-004, 06-22-013-101-013, -014

STARTING POINT: SOUTHWEST CORNER OF O.L. 13 BURRELL AND DAY TRACT

20-04134

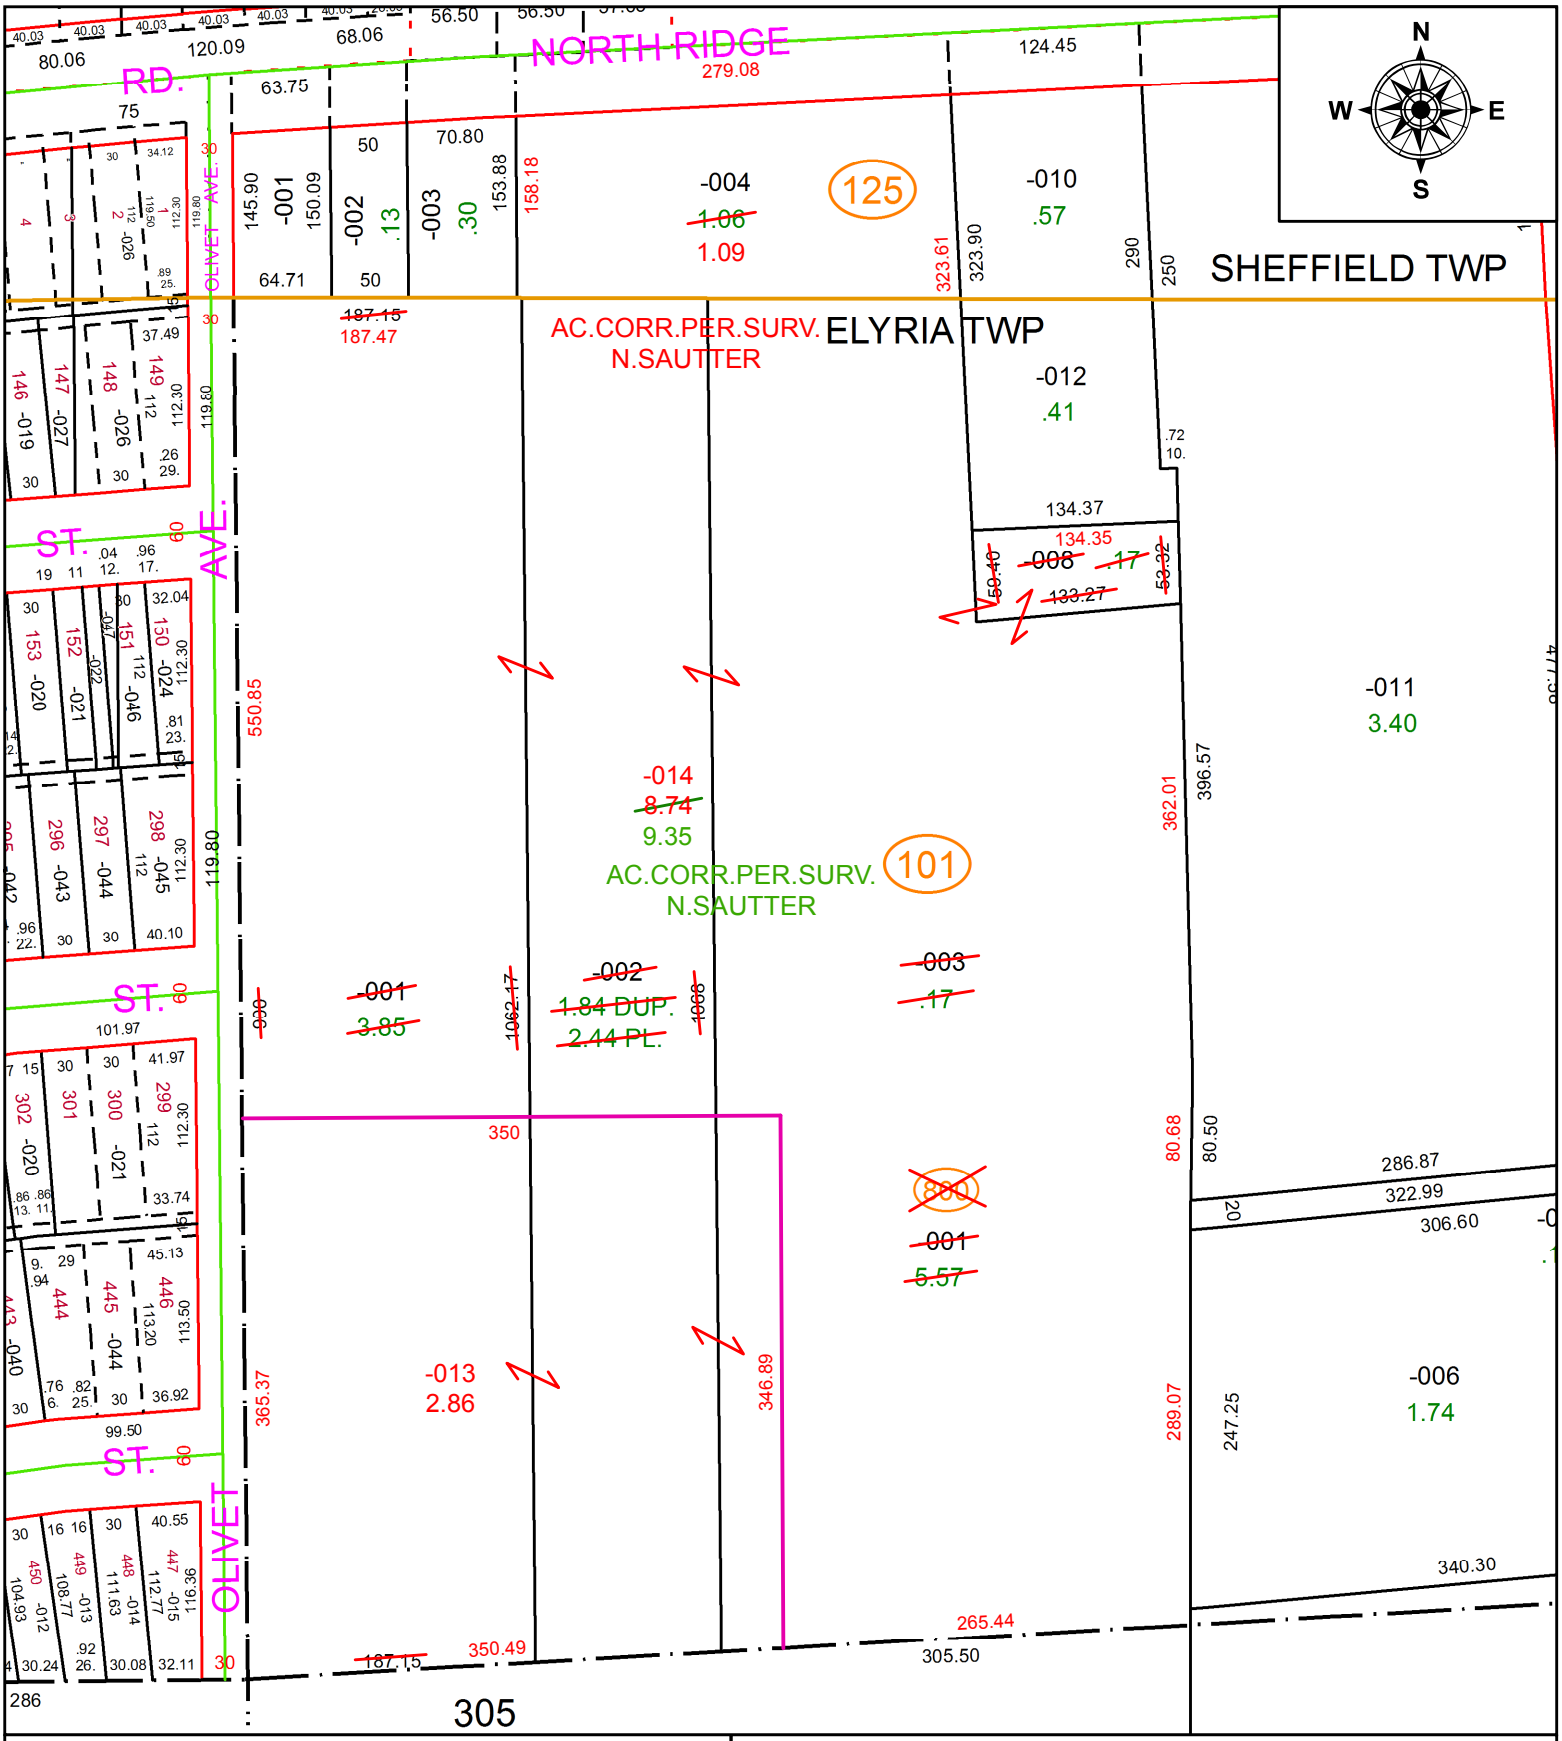

SPLITS/DEEDS PROCESSED

LORAIN COUNTY TAX MAP DEPARTMENT
226 MIDDLE AVE. ELYRIA, OH

SURVEYED BY: NATHAN W. SAUTTER
CLOSURE: 1:210,251
MAP PAGE(S): 6-22-013
APPOVED BY: RRM **DATE:** 6-9-20
SCALE: 1" = 125 **PRIOR INSTRUMENT:** DV 474/183