PARENT PARCEL: 03-00-047-103-004, -017

CHILD PARCEL:

STARTING POINT: INTERSECTION OF C/L OF E.ERIE AVE. AND C/L OF EUCLID AVE.

19-04138-D

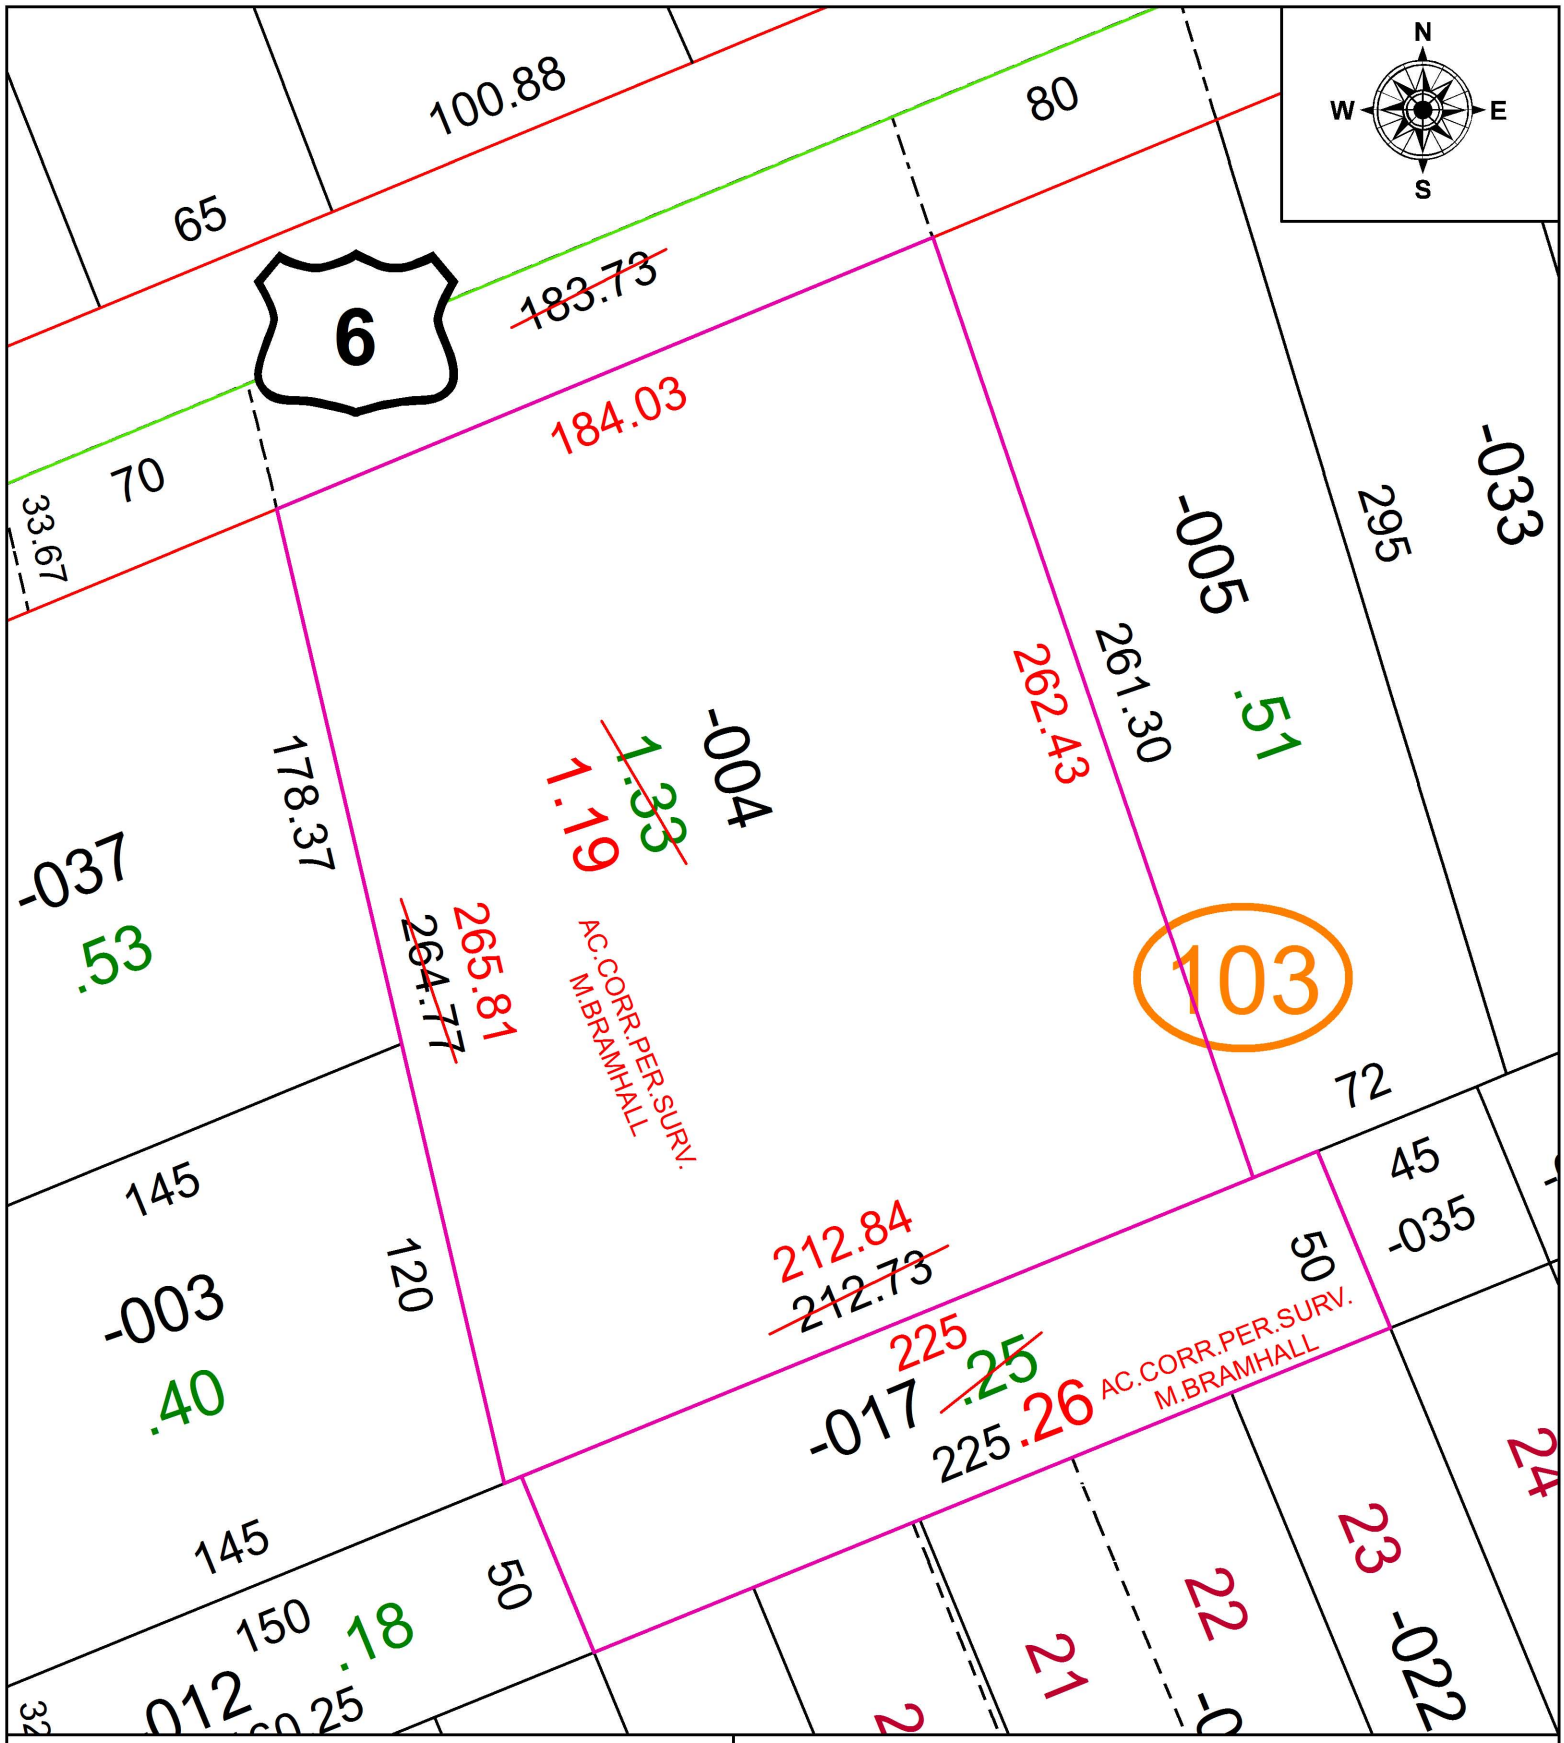

SPLITS/DEEDS PROCESSED

LORAIN COUNTY TAX MAP DEPARTMENT
226 MIDDLE AVE. ELYRIA, OH

SURVEYED BY: MICHAEL BRAMHALL
CLOSURE: 1:146,757
MAP PAGE(S): 3-00-047
APPOVED BY: RRM **DATE:** 7-12-19
SCALE: 1" = 50 **PRIOR INSTRUMENT:** 20180668618