PARENT PARCEL: 18-00-022-102-009, -010

CHILD PARCEL:

STARTING POINT: NORTHWEST CORNER OF S/L 69 IN R.A. HORRS ADDITION

19-04139-D

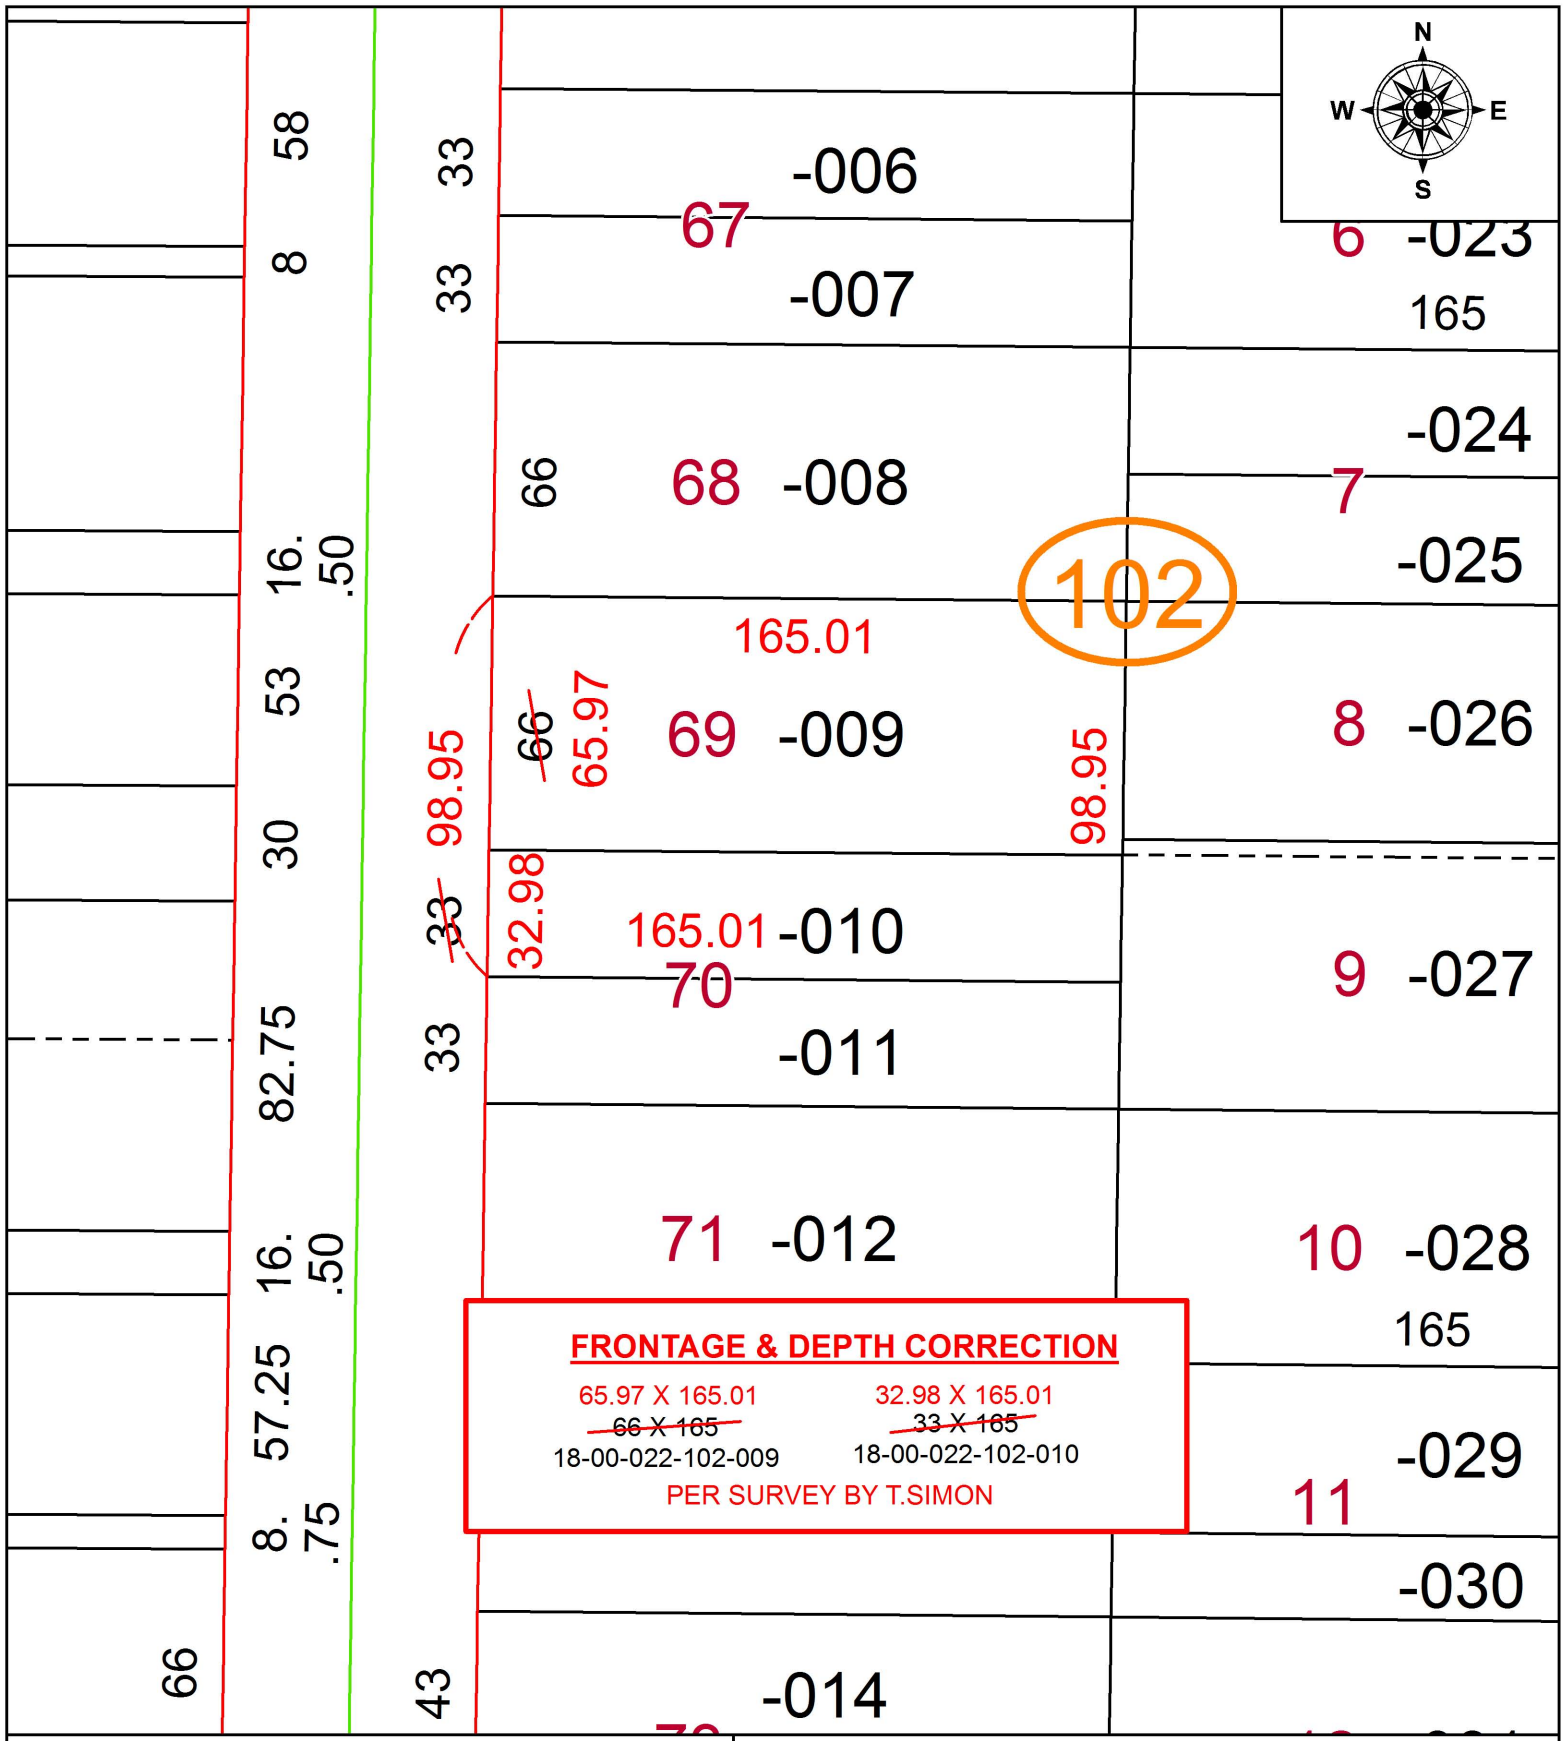

SPLITS/DEEDS PROCESSED

LORAIN COUNTY TAX MAP DEPARTMENT
226 MIDDLE AVE. ELYRIA, OH

SURVEYED BY: THOMAS A. SIMON
CLOSURE: 1:275,117
MAP PAGE(S): 18-00-022
APPOVED BY: RRM **DATE:** 8-13-19
SCALE: 1" = 50 **PRIOR INSTRUMENT:** 20120406295