PARENT PARCEL: 11-00-096-000-043

CHILD PARCEL:

STARTING POINT: INTERSECTION OF C/L OF CAPEL RD. AND C/L OF S.R. 57

19-04141-D

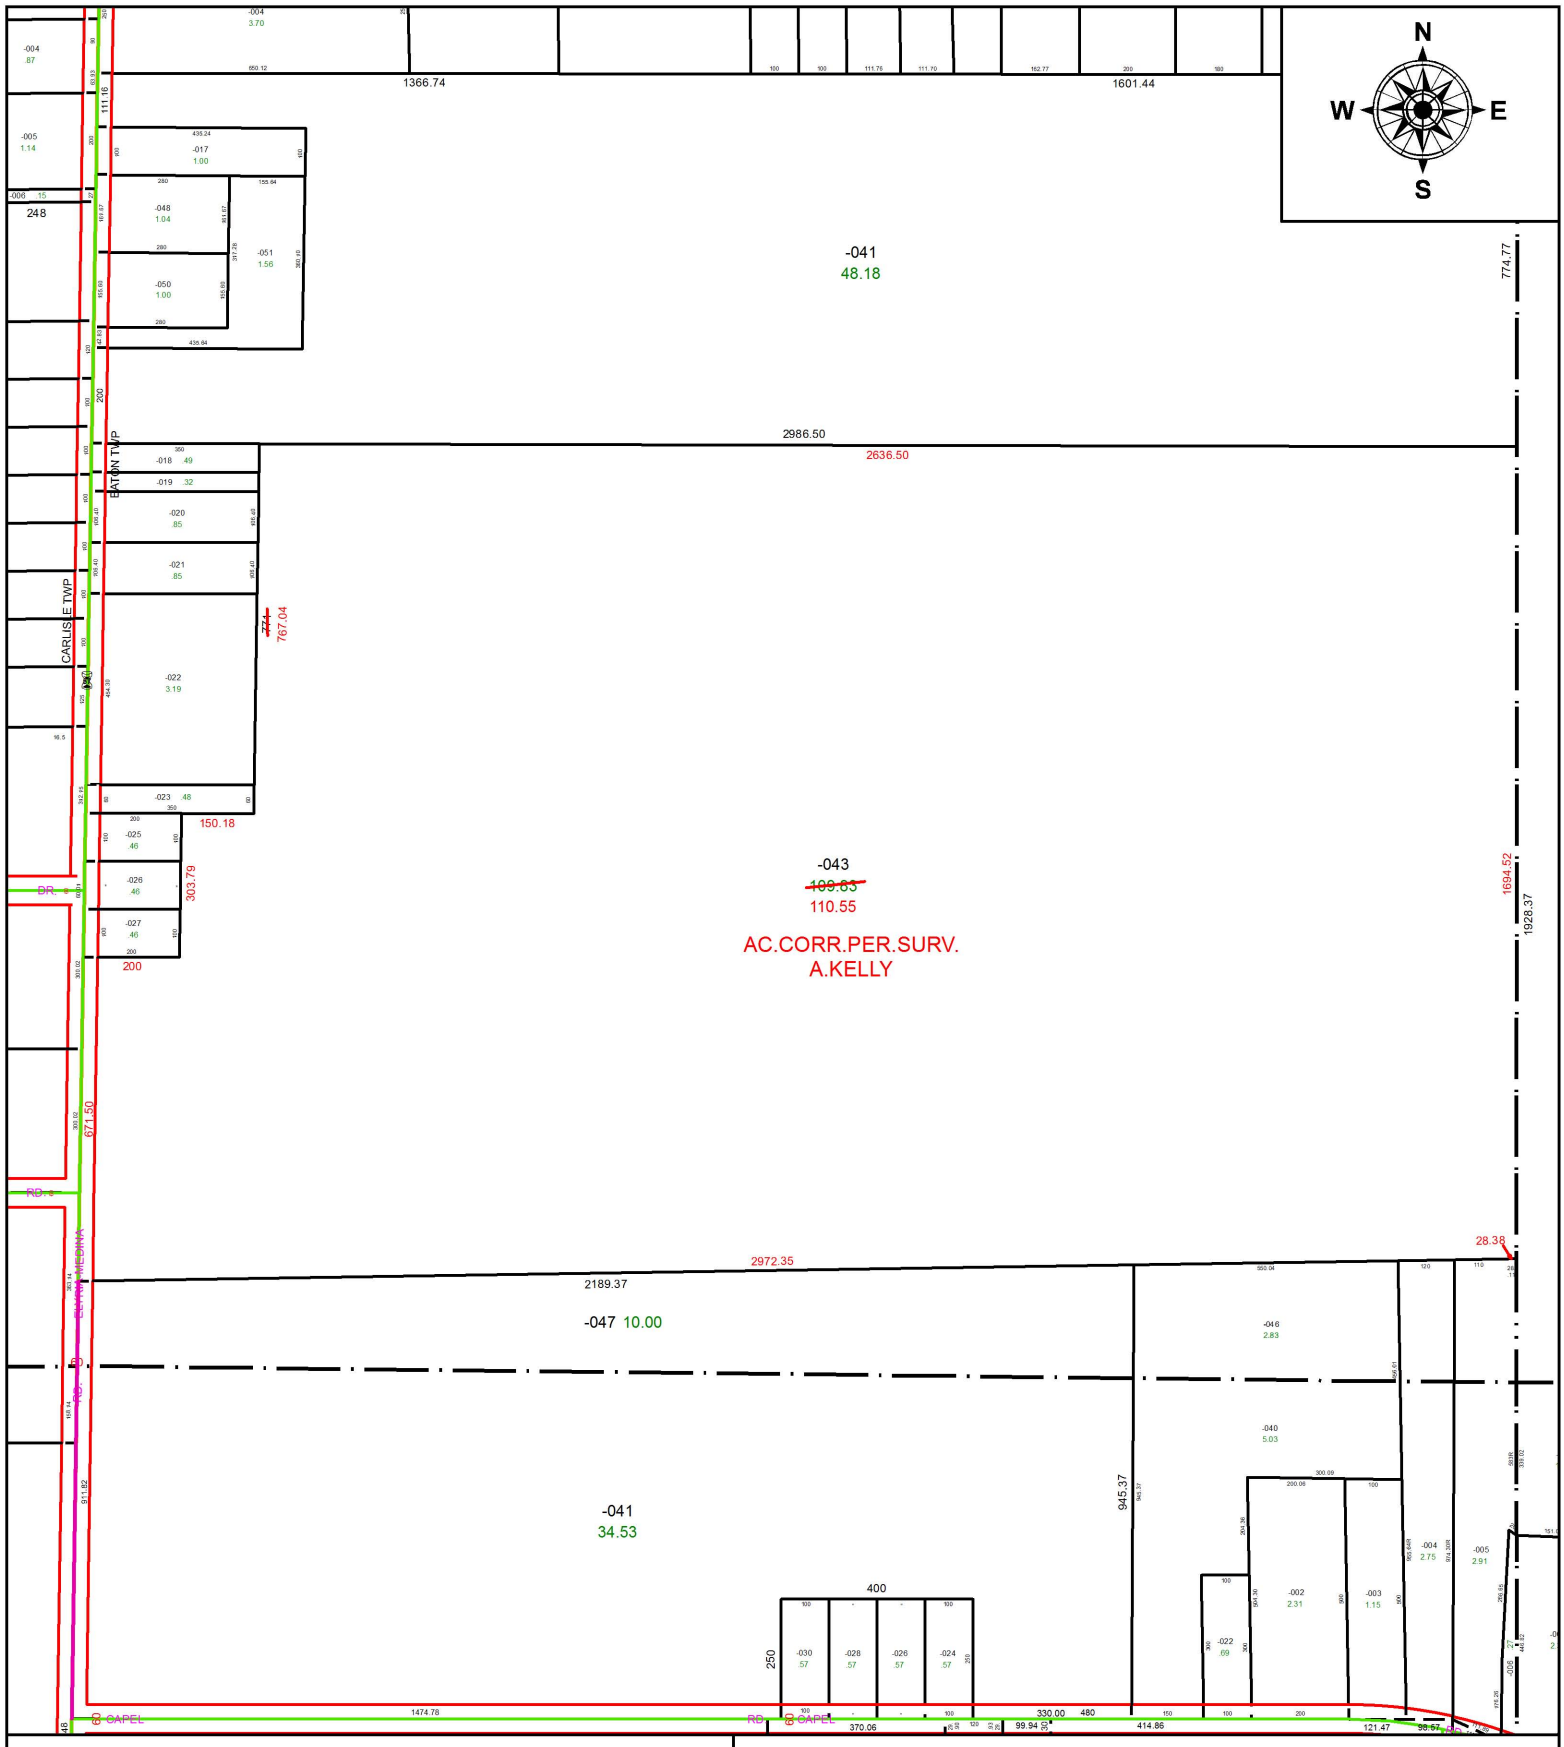

SPLITS/DEEDS PROCESSED

LORAIN COUNTY TAX MAP DEPARTMENT
226 MIDDLE AVE. ELYRIA, OH

SURVEYED BY: AMY M. KELLY
CLOSURE: 1:4,870,288
MAP PAGE(S): 11-00-096
APPOVED BY: RRM **DATE:** 7-12-19
SCALE: 1" = 400 **PRIOR INSTRUMENT:** 20130443932