PARENT PARCEL: 02-01-001-108-021, -022, -023, -024

CHILD PARCEL: 02-01-001-108-027, -028, -029

STARTING POINT: INTERSECTION OF C/L OF BASCULE DR AND C/L OF ARIZONA AVE.

20-04142

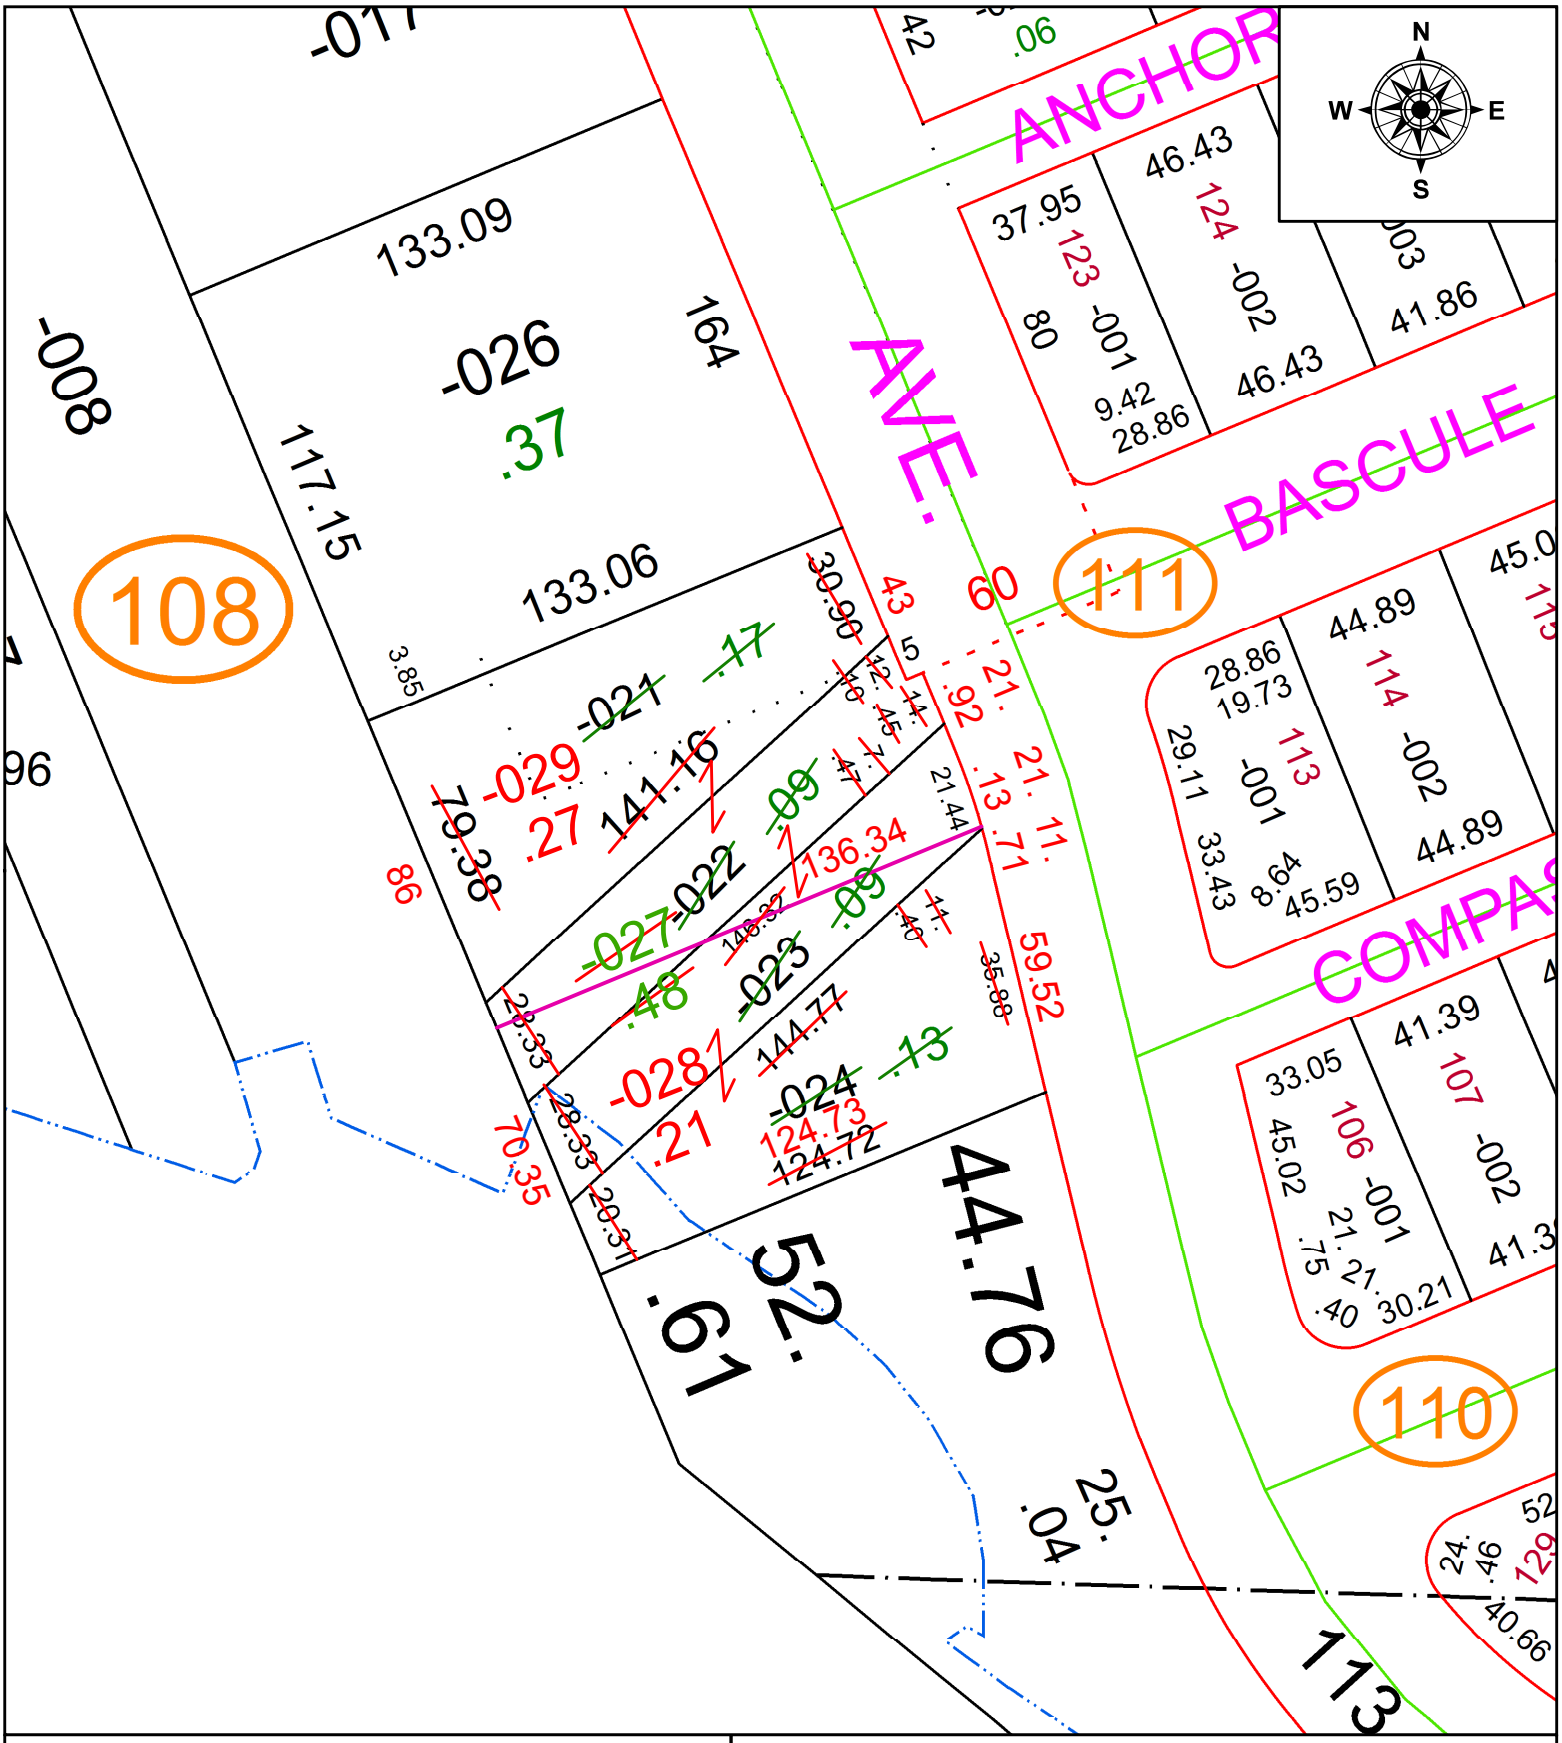

SPLITS/DEEDS PROCESSED

LORAIN COUNTY TAX MAP DEPARTMENT
226 MIDDLE AVE. ELYRIA, OH

SURVEYED BY: AMY M. KELLY
CLOSURE: 1:46,838
MAP PAGE(S): 2-01-001
APPOVED BY: RRM **DATE:** 7-1-20
SCALE: 1" = 50 **PRIOR INSTRUMENT:** 20190709246