PARENT PARCEL: 11-00-071-000-010, -072

CHILD PARCEL: 11-00-071-000-126

STARTING POINT: INTERSECTION OF C/L OF CHESTNUT RIDGE RD, AND C/L OF DURKEE RD.

20-04148

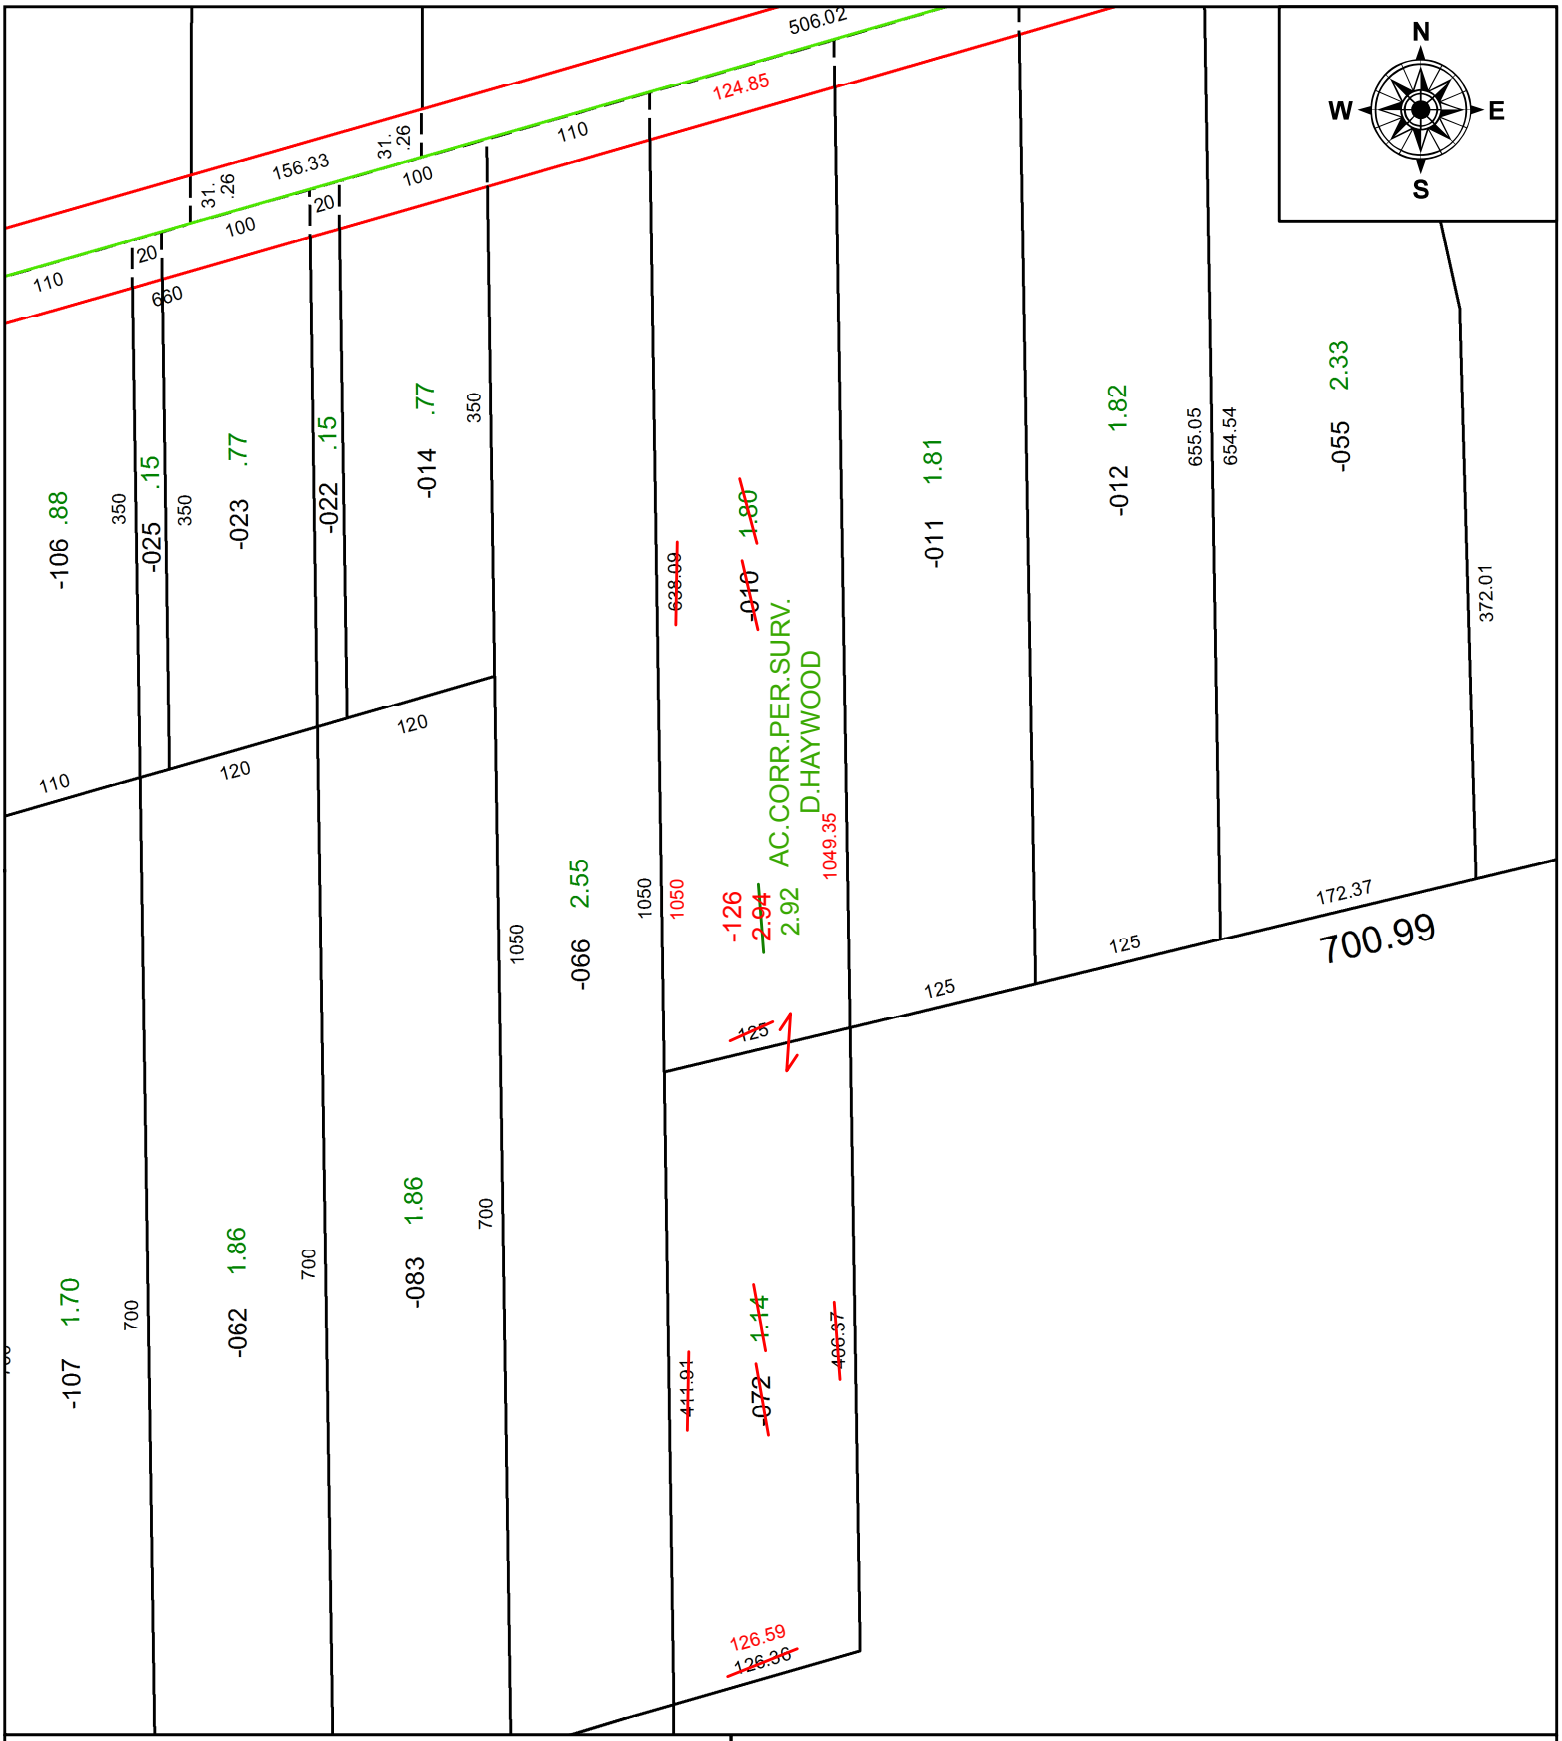

SPLITS/DEEDS PROCESSED

LORAIN COUNTY TAX MAP DEPARTMENT
226 MIDDLE AVE. ELYRIA, OH

SURVEYED BY: DALE R. HAYWOOD
CLOSURE: 1:1,055,921
MAP PAGE(S): 11-00-071
APPOVED BY: RRM **DATE:** 7-13-20
SCALE: 1" = 125 **PRIOR INSTRUMENT:** 20160611814