PARENT PARCEL: 07-00-020-101-041

CHILD PARCEL: 07-00-020-101-131, -132

STARTING POINT: NORTHWEST CORNER OF S/L 141 IN SANDELWOOD ACRES SUB. NO.5

20-04151

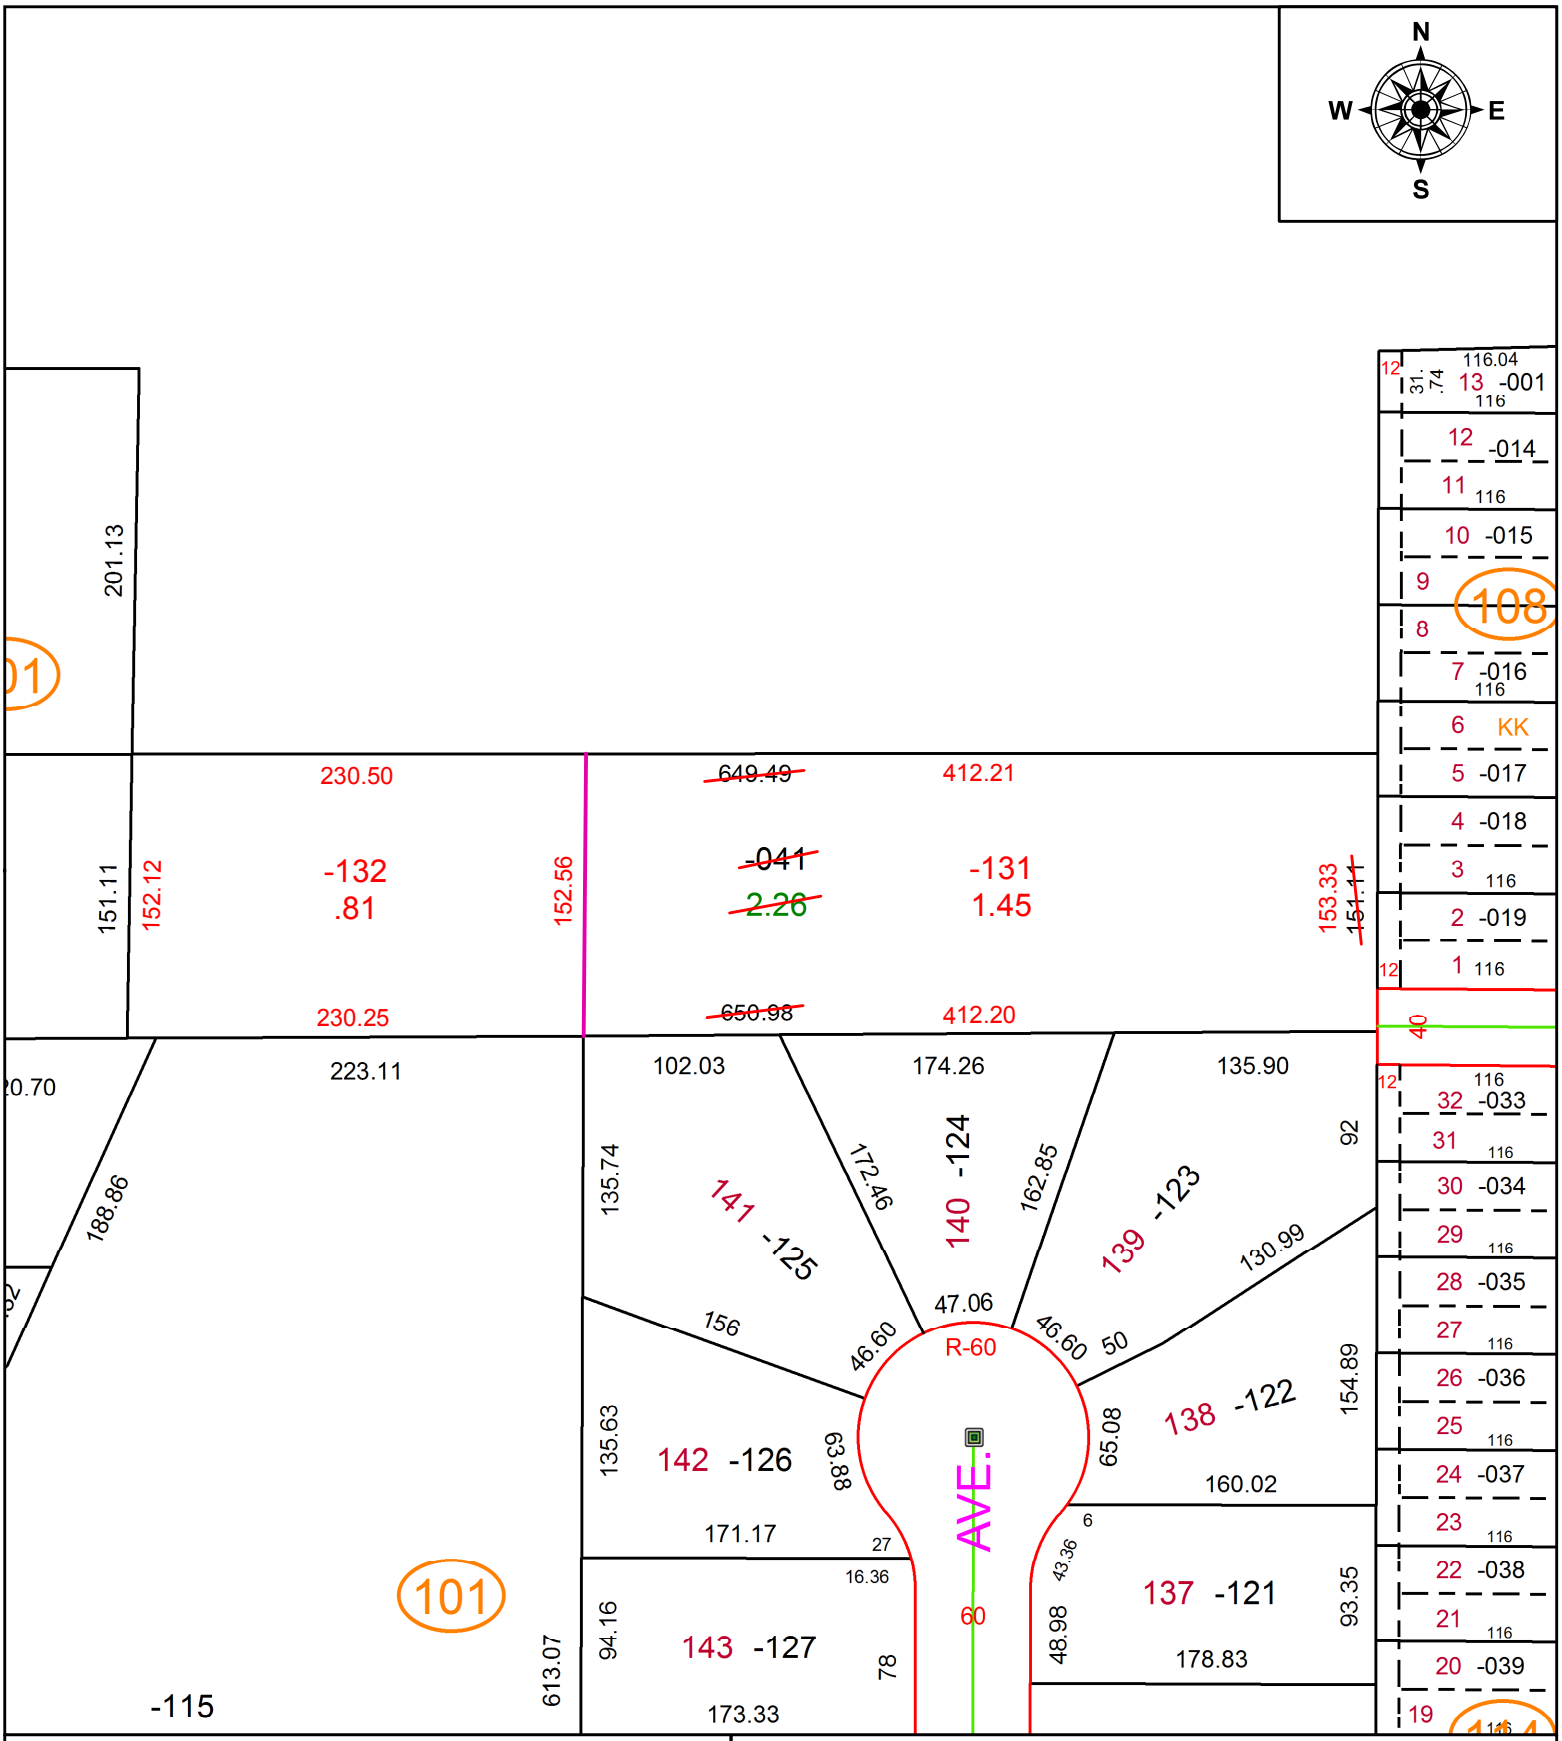

SPLITS/DEEDS PROCESSED

LORAIN COUNTY TAX MAP DEPARTMENT
226 MIDDLE AVE. ELYRIA, OH

SURVEYED BY: WILFREDO BARBOSA
CLOSURE: 1:93,265
MAP PAGE(S): 7-00-020
APPOVED BY: RRM **DATE:** 7-17-20
SCALE: 1" = 100 **PRIOR INSTRUMENT:** 20190704717