PARENT PARCEL: 07-00-008-116-038, -040

CHILD PARCEL: 07-00-008-116-041, -042

STARTING POINT: INTERSECTION OF C/L OF LEAR NAGLE RD. AND C/L OF CENTER RIDGE RD,

20-04153

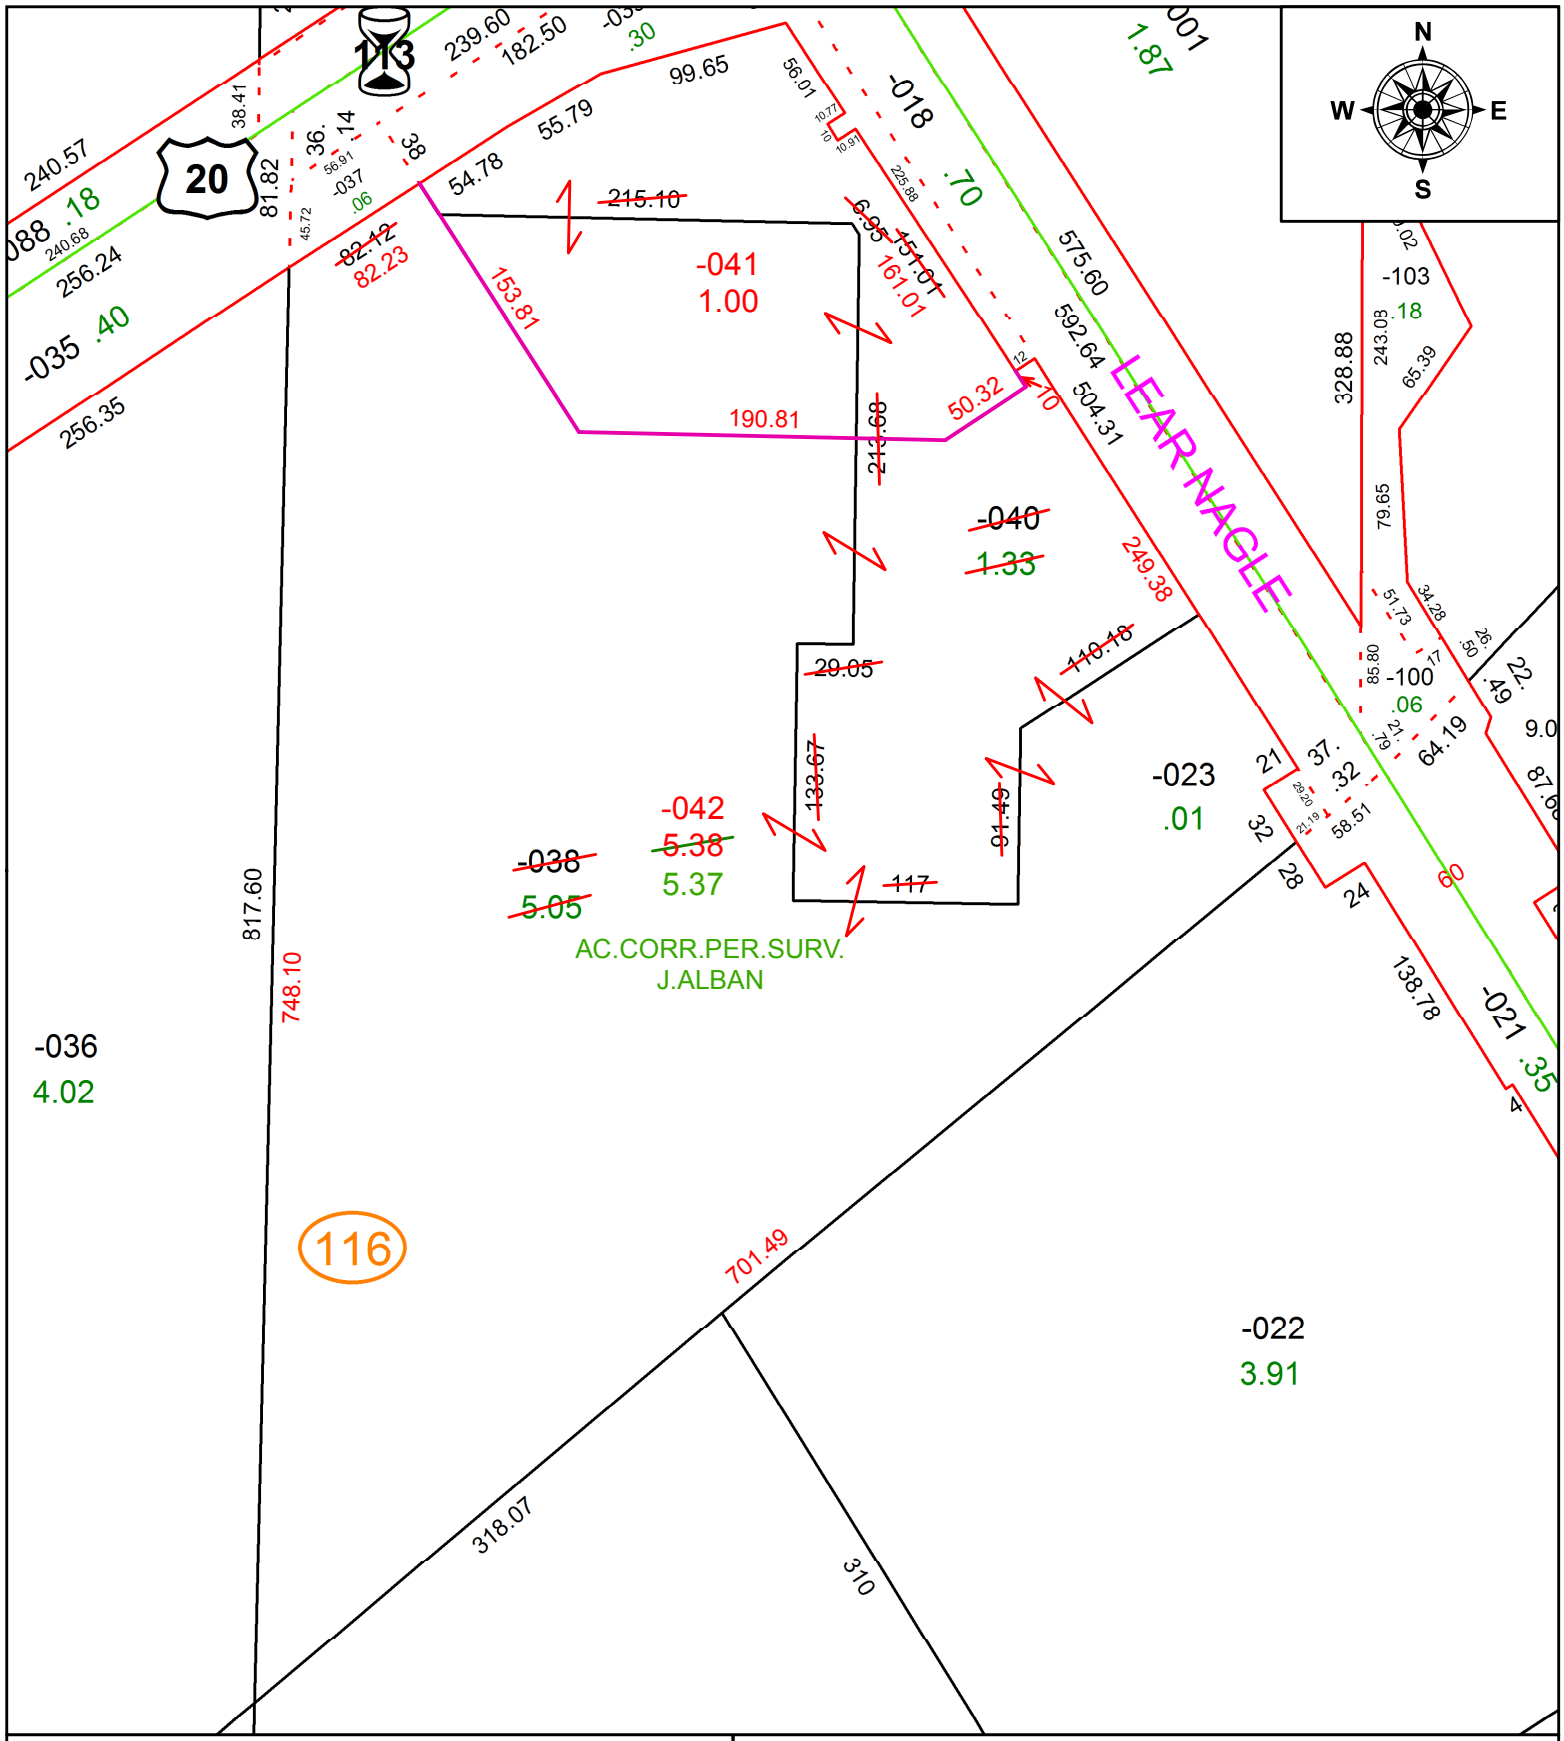

SPLITS/DEEDS PROCESSED

LORAIN COUNTY TAX MAP DEPARTMENT
226 MIDDLE AVE. ELYRIA, OH

SURVEYED BY: JOHN R. ALBAN
CLOSURE: 1:90,913
MAP PAGE(S): 7-00-008
APPOVED BY: RRM **DATE:** 7-27-20
SCALE: 1" = 100 **PRIOR INSTRUMENT:** 20180679643