PARENT PARCEL: 03-00-024-000-072, -073, -079

CHILD PARCEL: 03-00-024-000-083 THRU -088

STARTING POINT: INTERSECTION OF C/L OF OSTER RD. AND C/L OF HARRIS RD.

20-04154

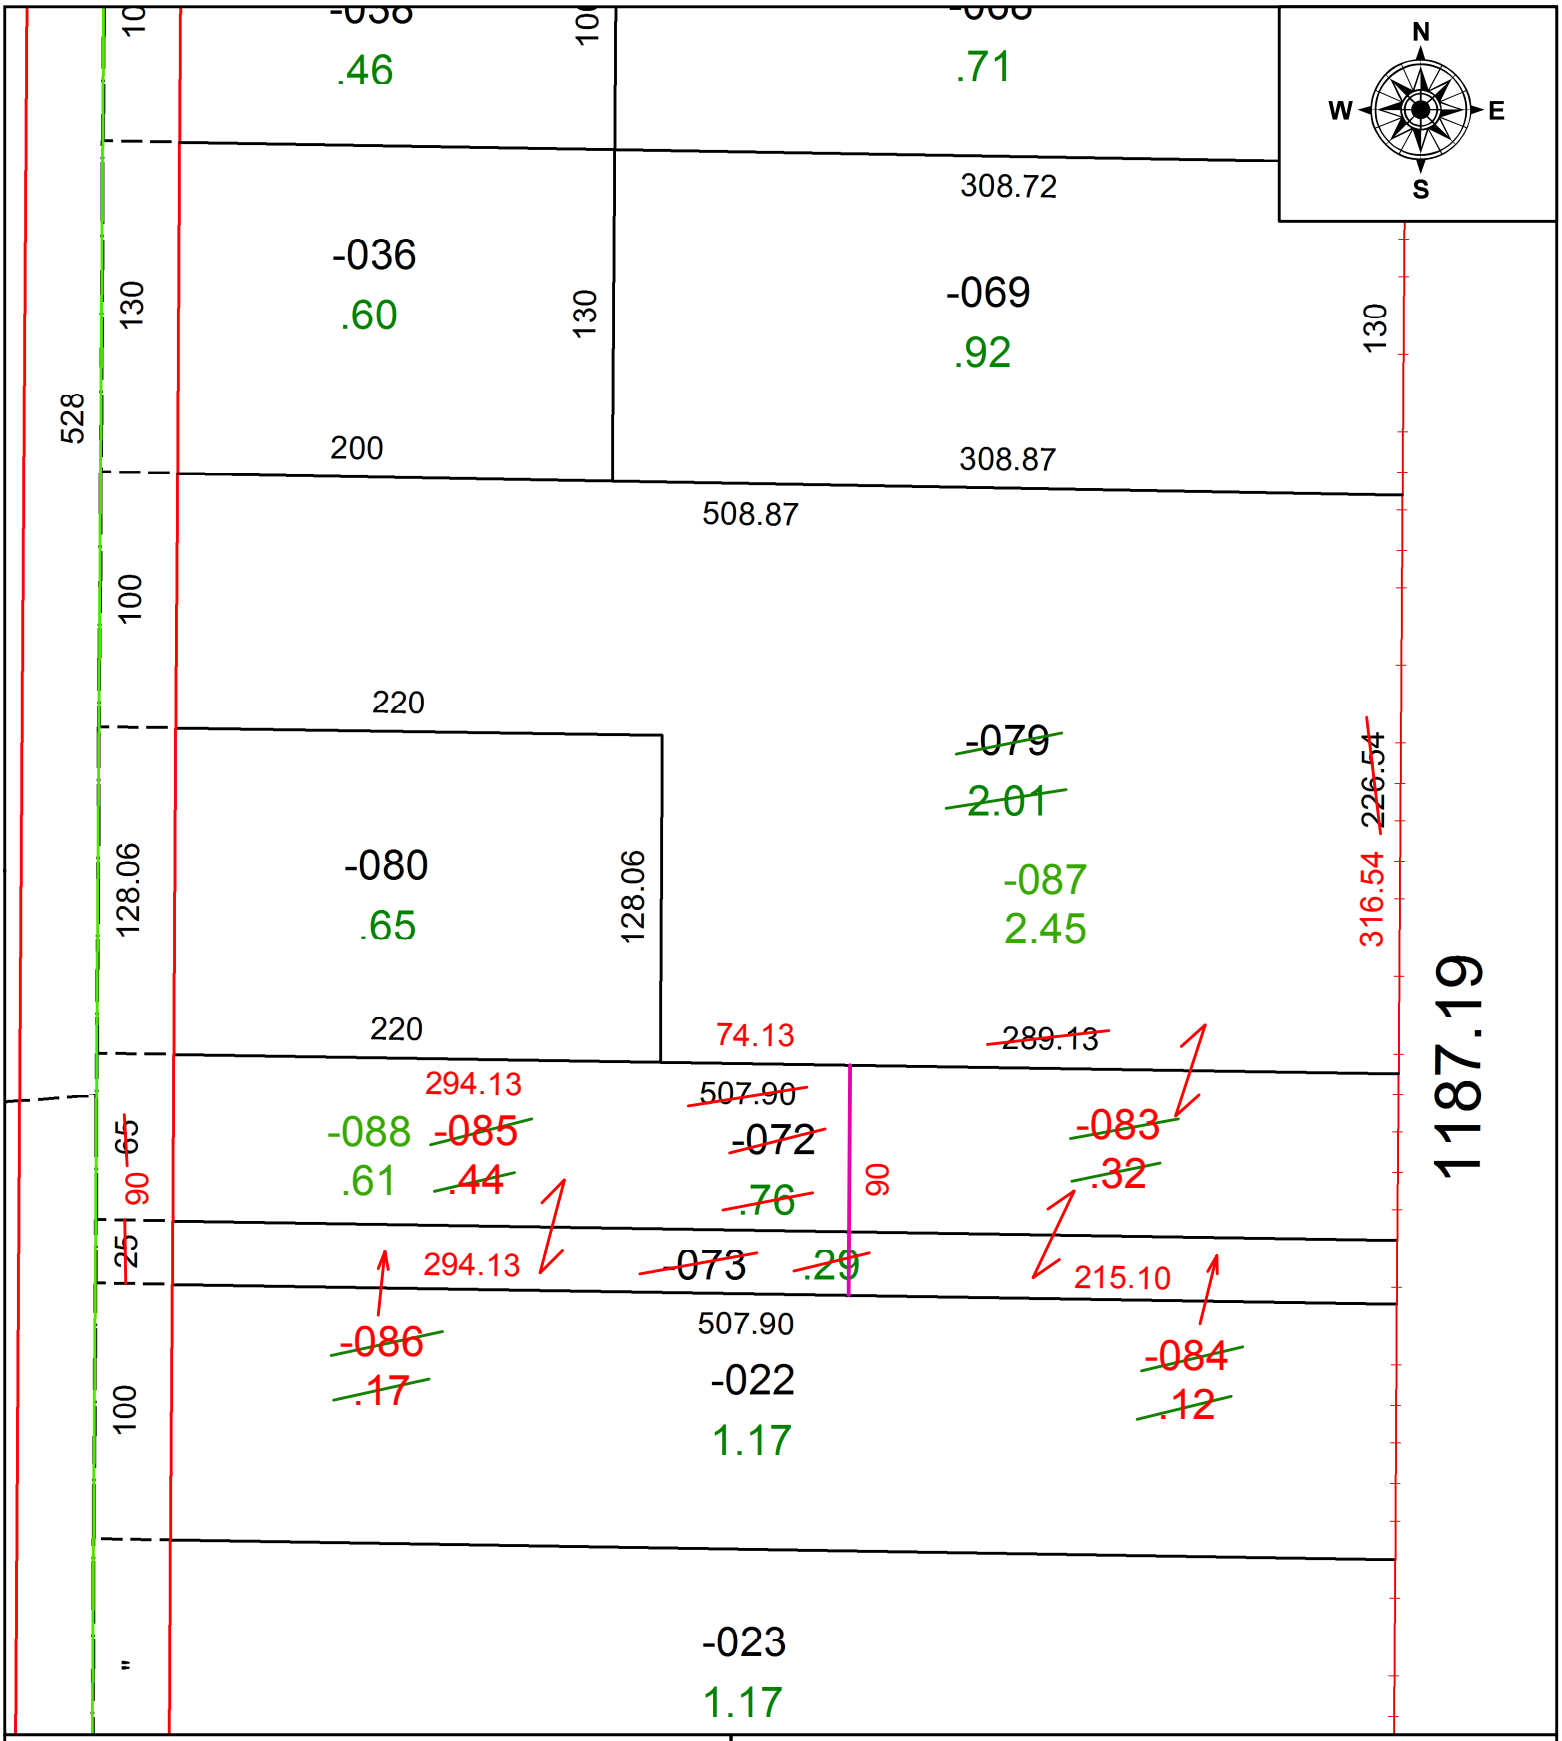

SPLITS/DEEDS PROCESSED

LORAIN COUNTY TAX MAP DEPARTMENT
226 MIDDLE AVE. ELYRIA, OH

SURVEYED BY: MICHAEL BRAMHALL
CLOSURE: 1:128,113
MAP PAGE(S): 3-00-024
APPOVED BY: RRM **DATE:** 7-31-20
SCALE: 1" = 75 **PRIOR INSTRUMENT:** 20190742240