PARENT PARCEL: 06-25-016-106-001
CHILD PARCEL: 06-25-016-106-001, -027
STARTING POINT: INTERSECTION OF SOUTH LINE OF TAYLOR ST. AND EAST LINE OF WINCKLES ST.

19-04160-C

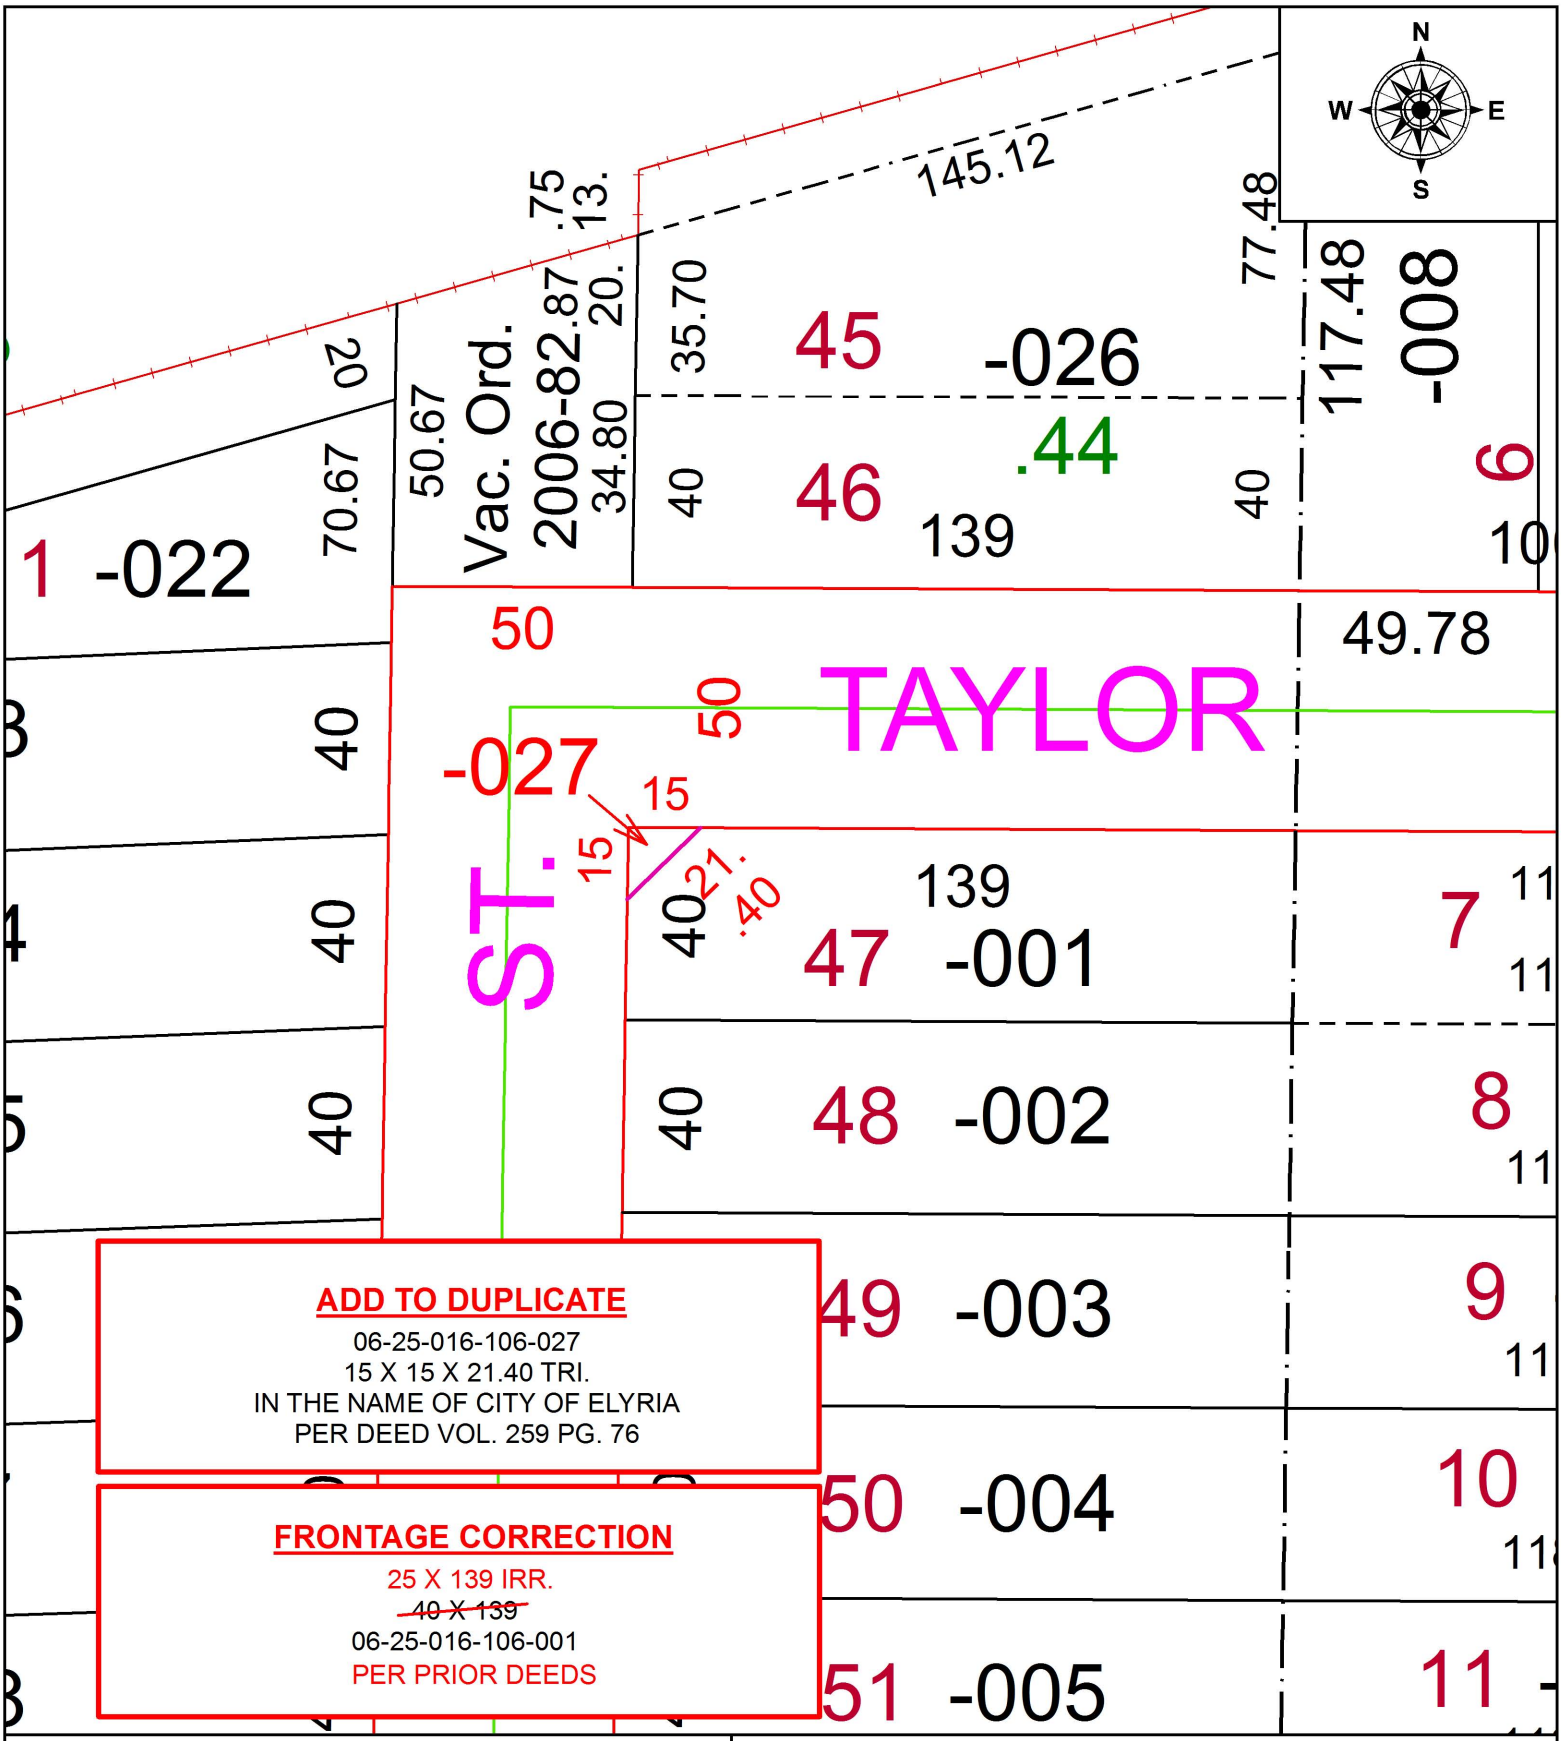

ADD TO DUPLICATE
06-25-016-106-027
15 X 15 X 21.40 TRI.
IN THE NAME OF CITY OF ELYRIA
PER DEED VOL. 259 PG. 76

FRONTAGE CORRECTION
25 X 139 IRR.
~~40 X 139~~
06-25-016-106-001
PER PRIOR DEEDS

SPLITS/DEEDS PROCESSED
LORAIN COUNTY TAX MAP DEPARTMENT
226 MIDDLE AVE. ELYRIA, OH

SURVEYED BY: N/A
CLOSURE: N/A
MAP PAGE(S): 6-25-016
APPOVED BY: RRM **DATE:** 7-24-19
SCALE: 1" = 40 **PRIOR INSTRUMENT:** DV 259/76