PARENT PARCEL: 06-25-038-108-003, -006, -007, -042

CHILD PARCEL: 06-25-038-108-007, -046

STARTING POINT: NORTHWEST CORNER OF S/L 49 IN EAST LAWN ALLOT.

20-04163

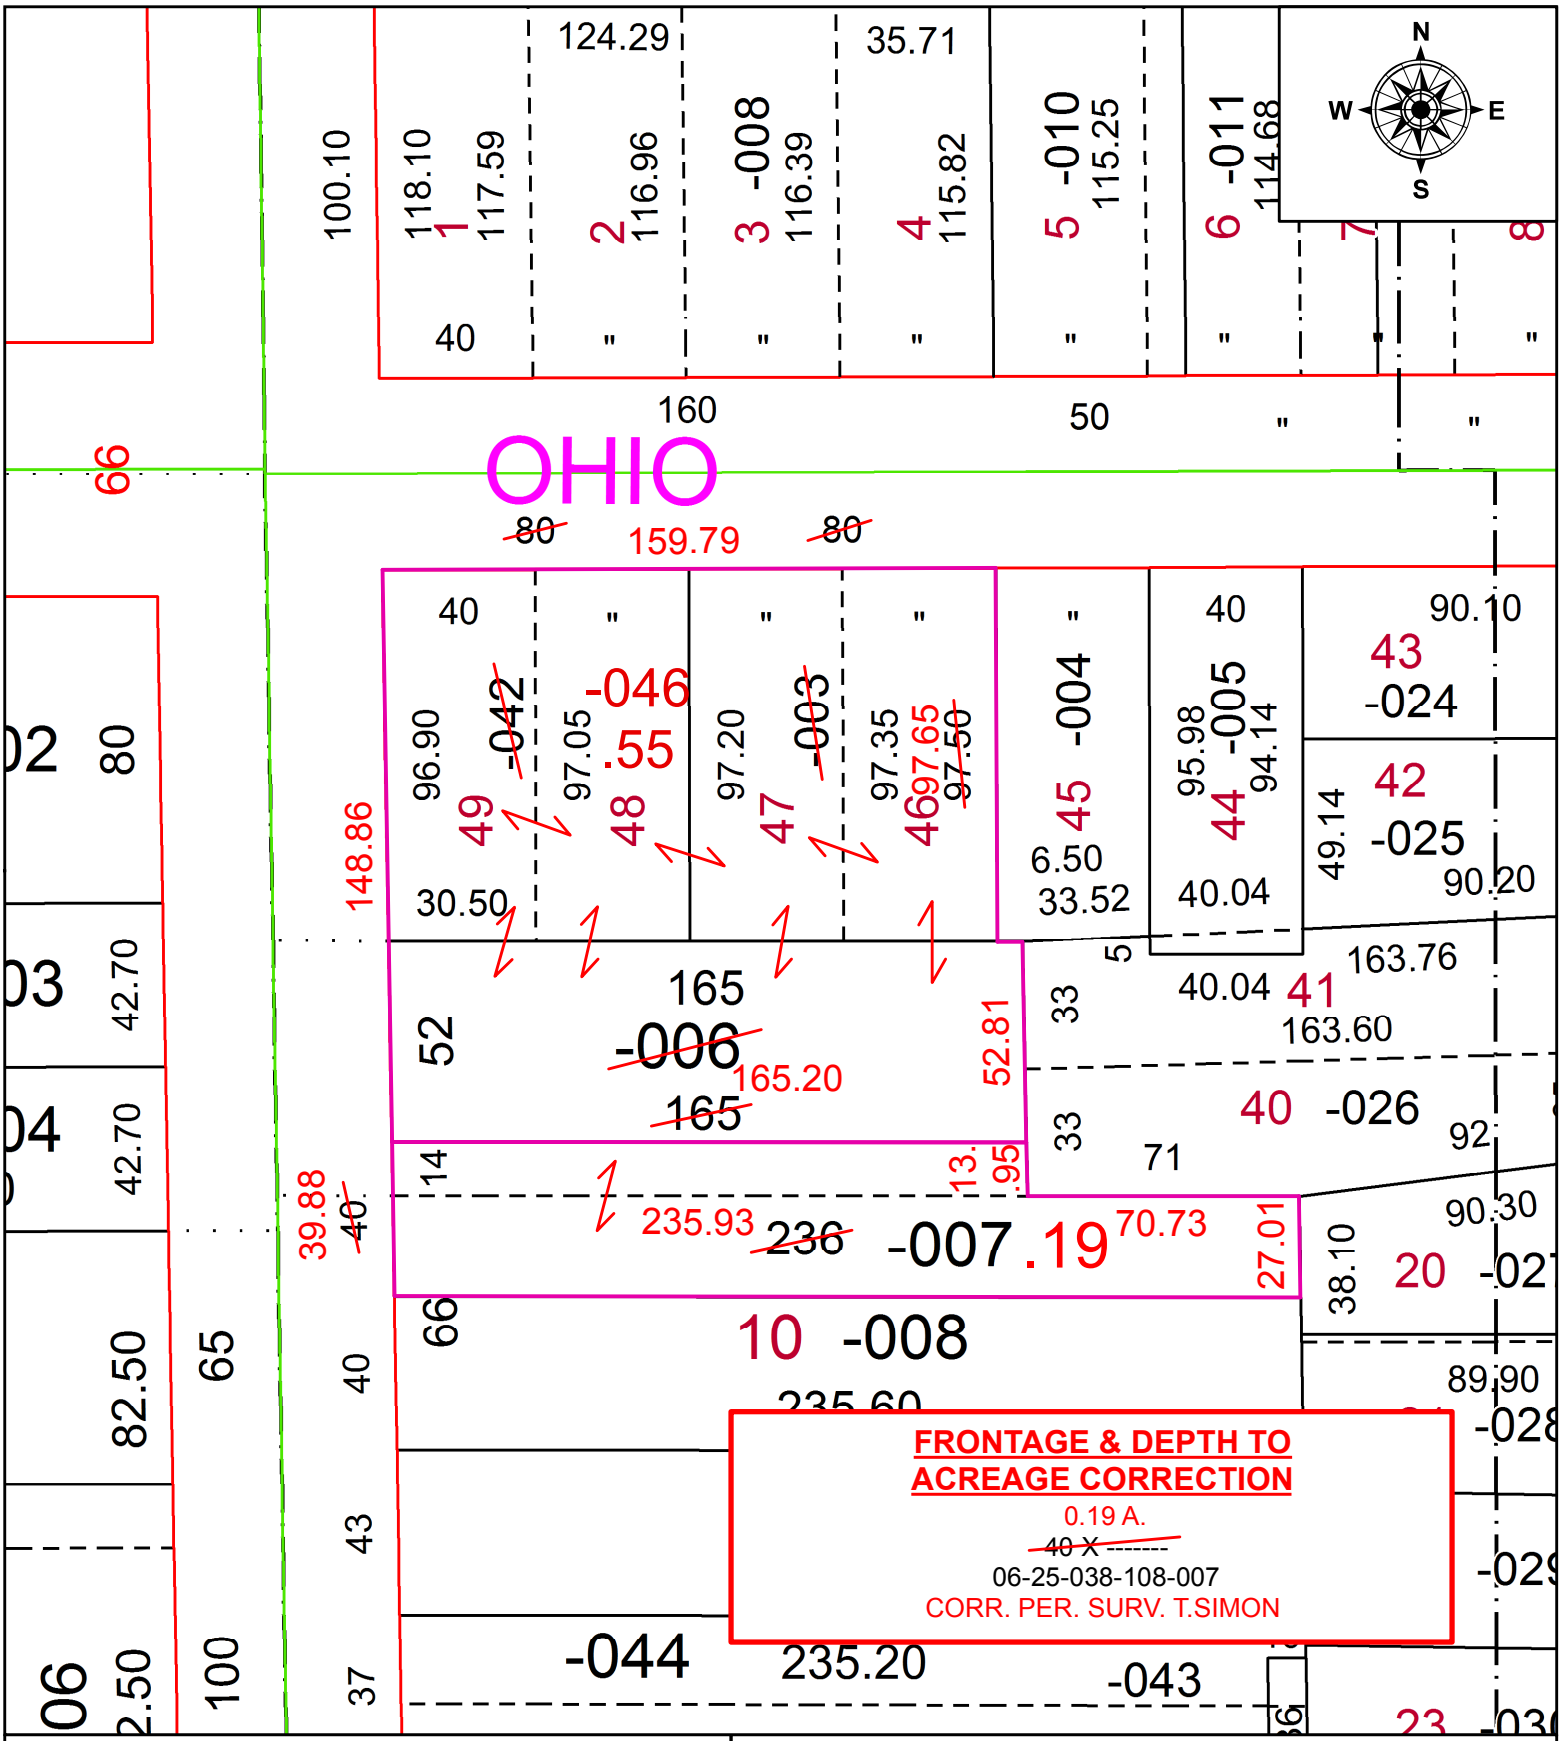

SPLITS/DEEDS PROCESSED

LORAIN COUNTY TAX MAP DEPARTMENT
226 MIDDLE AVE. ELYRIA, OH

SURVEYED BY: THOMAS A. SIMON
CLOSURE: 1:164,201
MAP PAGE(S): 6-25-038
APPOVED BY: RRM **DATE:** 8-21-20
SCALE: 1" = 50 **PRIOR INSTRUMENT:** OR 962/941