PARENT PARCEL: 04-00-017-101-045, -094, -095

CHILD PARCEL: 04-00-017-101-222, -223

STARTING POINT: INTERSECTION OF C/L OF WEBBER RD. AND C/L OF S.R. 83

20-04164

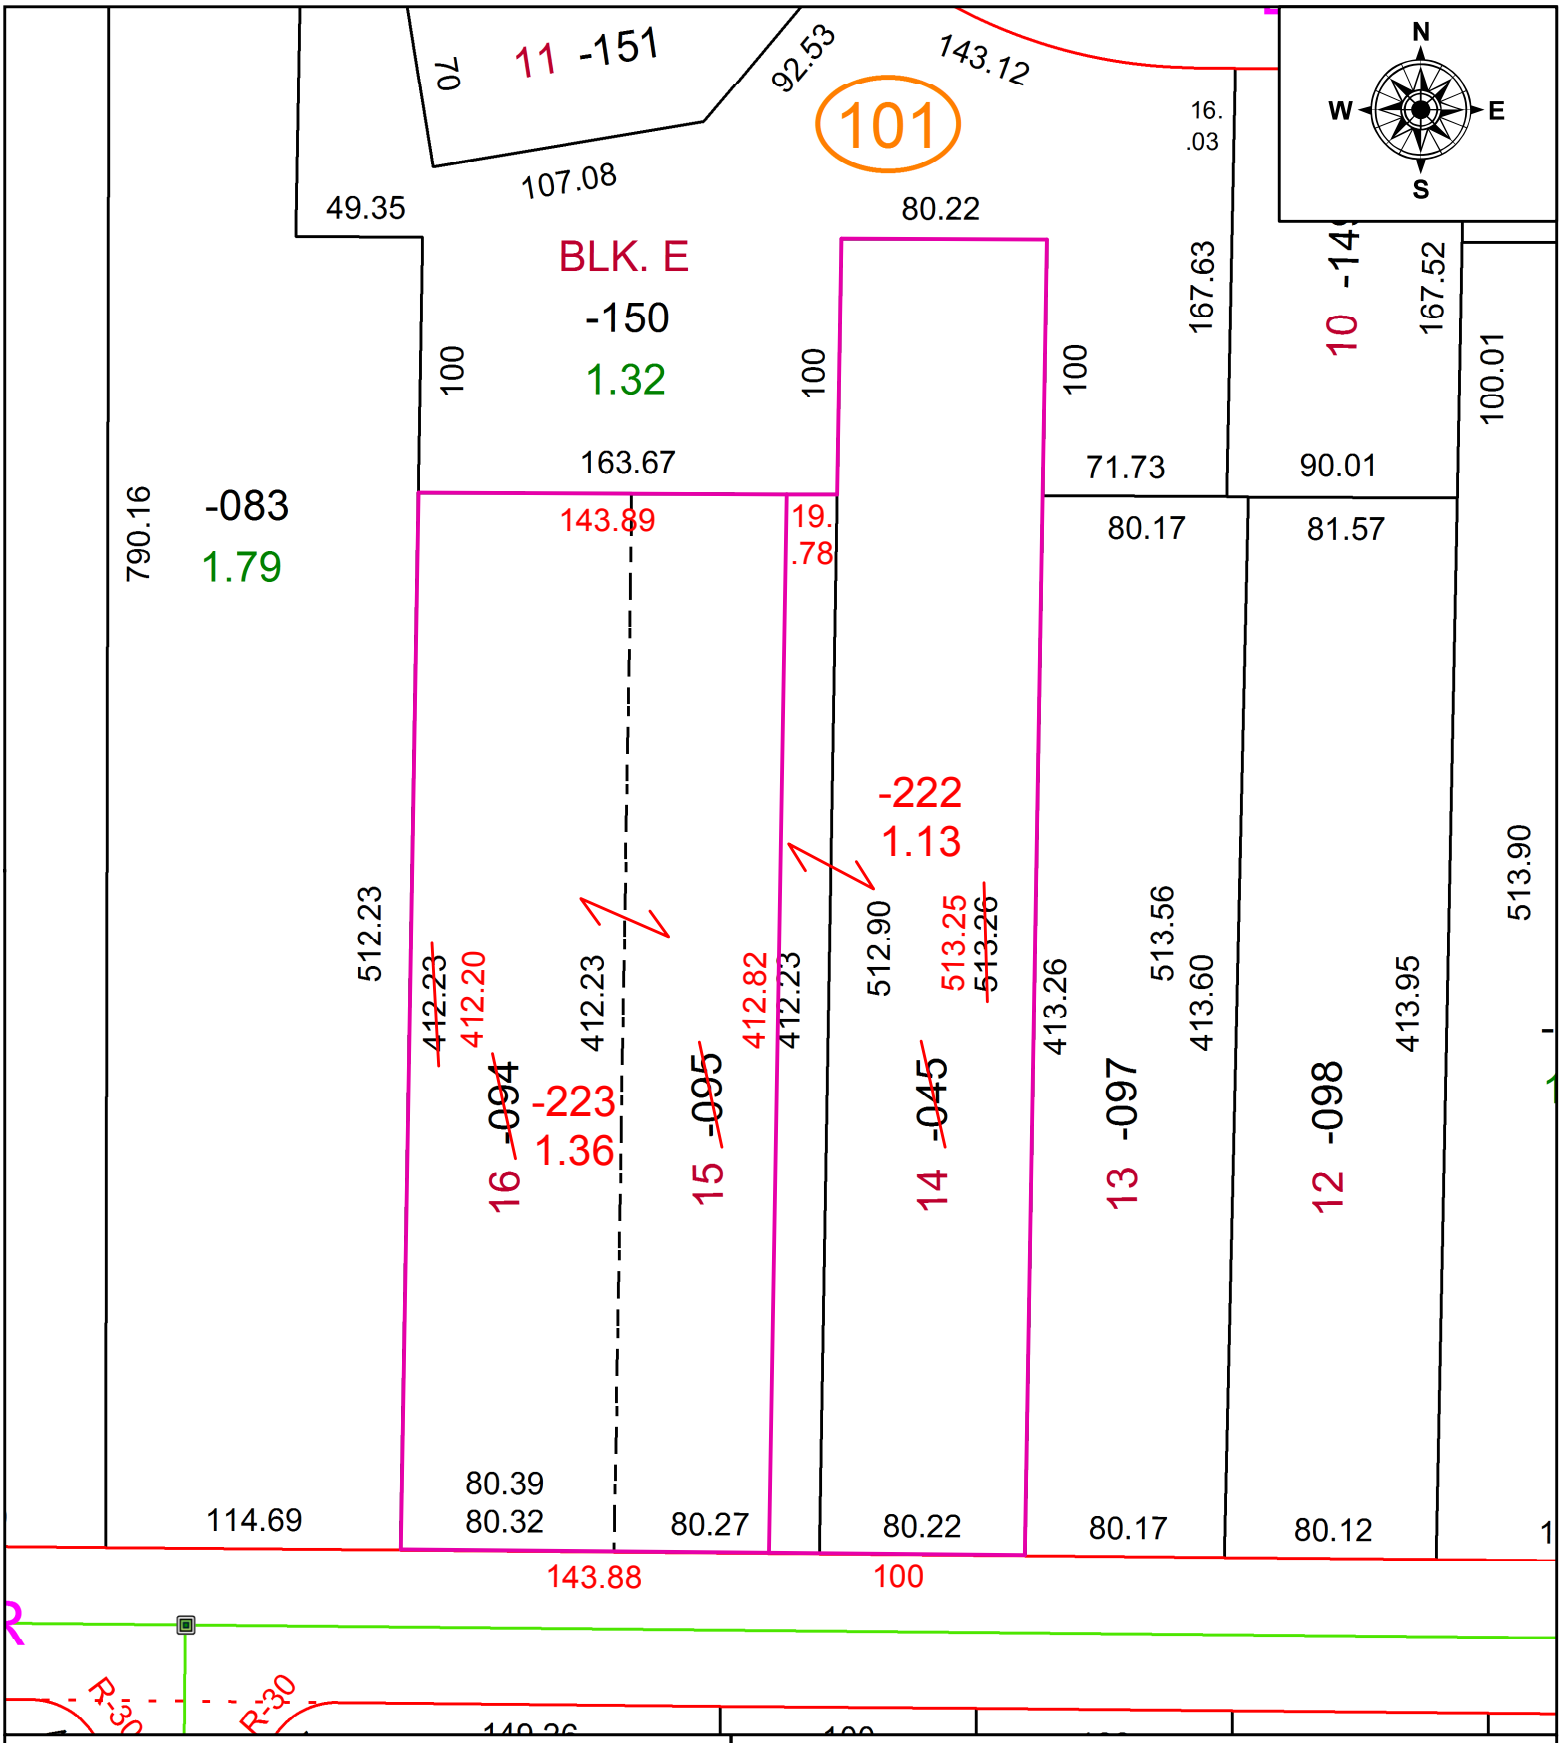

SPLITS/DEEDS PROCESSED

LORAIN COUNTY TAX MAP DEPARTMENT
226 MIDDLE AVE. ELYRIA, OH

SURVEYED BY: BRENT D. ANDERSON
CLOSURE: 1:236,429
MAP PAGE(S): 4-00-017
APPOVED BY: RRM **DATE:** 8-13-20
SCALE: 1" = 75 **PRIOR INSTRUMENT:** 20180686352