PARENT PARCEL: 04-00-022-103-152

CHILD PARCEL: 04-00-022-103-153 THRU -156

STARTING POINT: INTERSECTION OF C/L OF S.R. 254 AND C/L OF PALMER LN.

20-04165

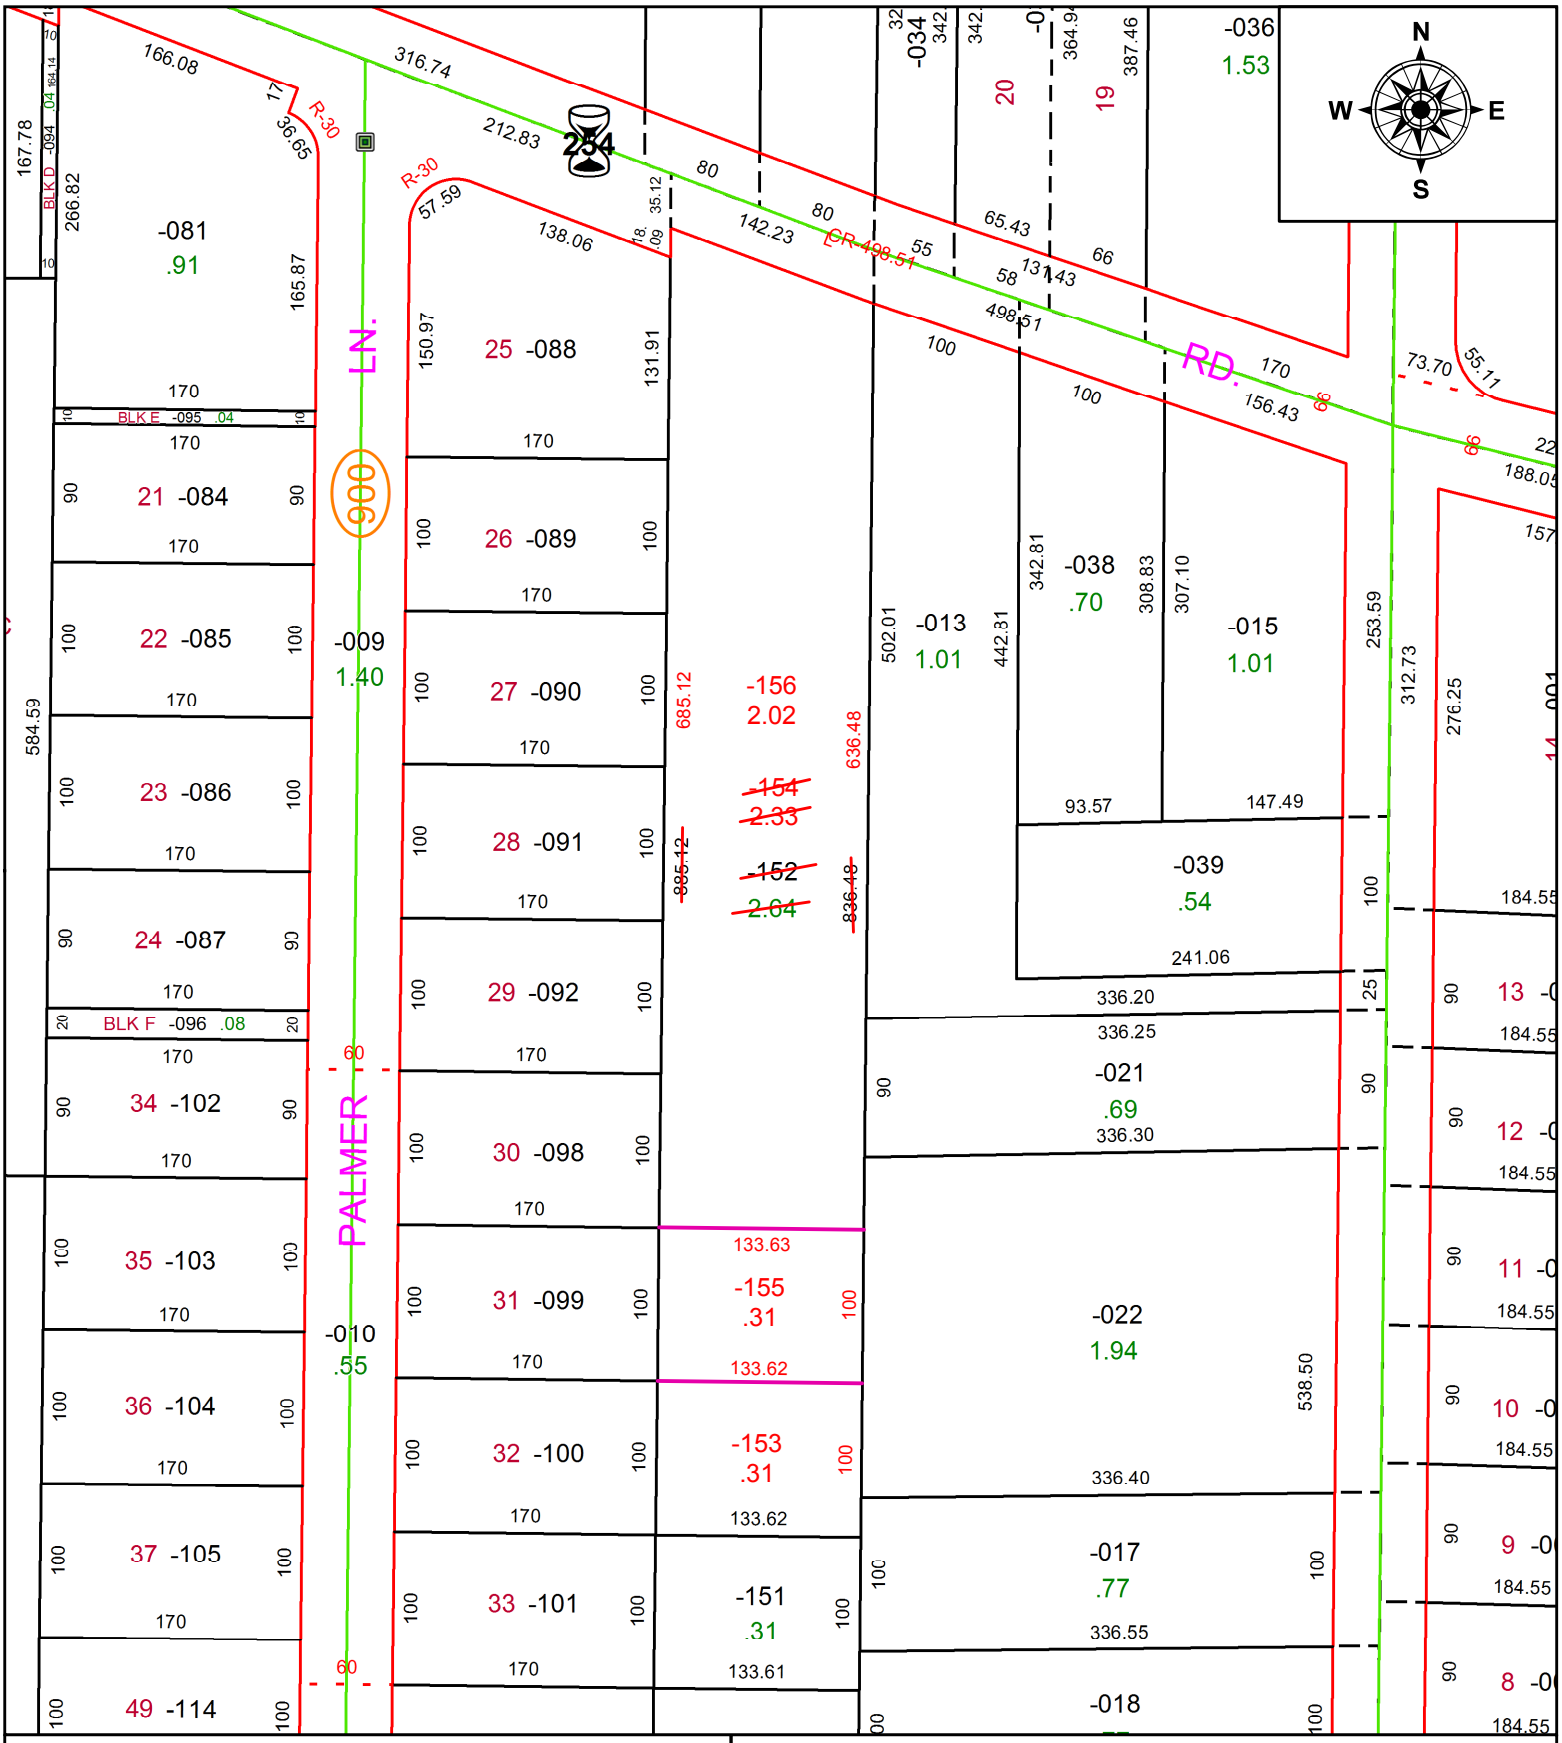

SPLITS/DEEDS PROCESSED

LORAIN COUNTY TAX MAP DEPARTMENT
226 MIDDLE AVE. ELYRIA, OH

SURVEYED BY: RICHARD A. THOMPSON JR.
CLOSURE: 1:107,083
MAP PAGE(S): 4-00-022
APPOVED BY: RRM **DATE:** 8-14-20
SCALE: 1" = 125 **PRIOR INSTRUMENT:** 20190728598