PARENT PARCEL: 04-00-030-141-268

CHILD PARCEL: 04-00-030-141-280, -281

STARTING POINT: INTERSECTION OF C/L OF WALKER RD. AND C/L OF LEAR RD.

20-04171

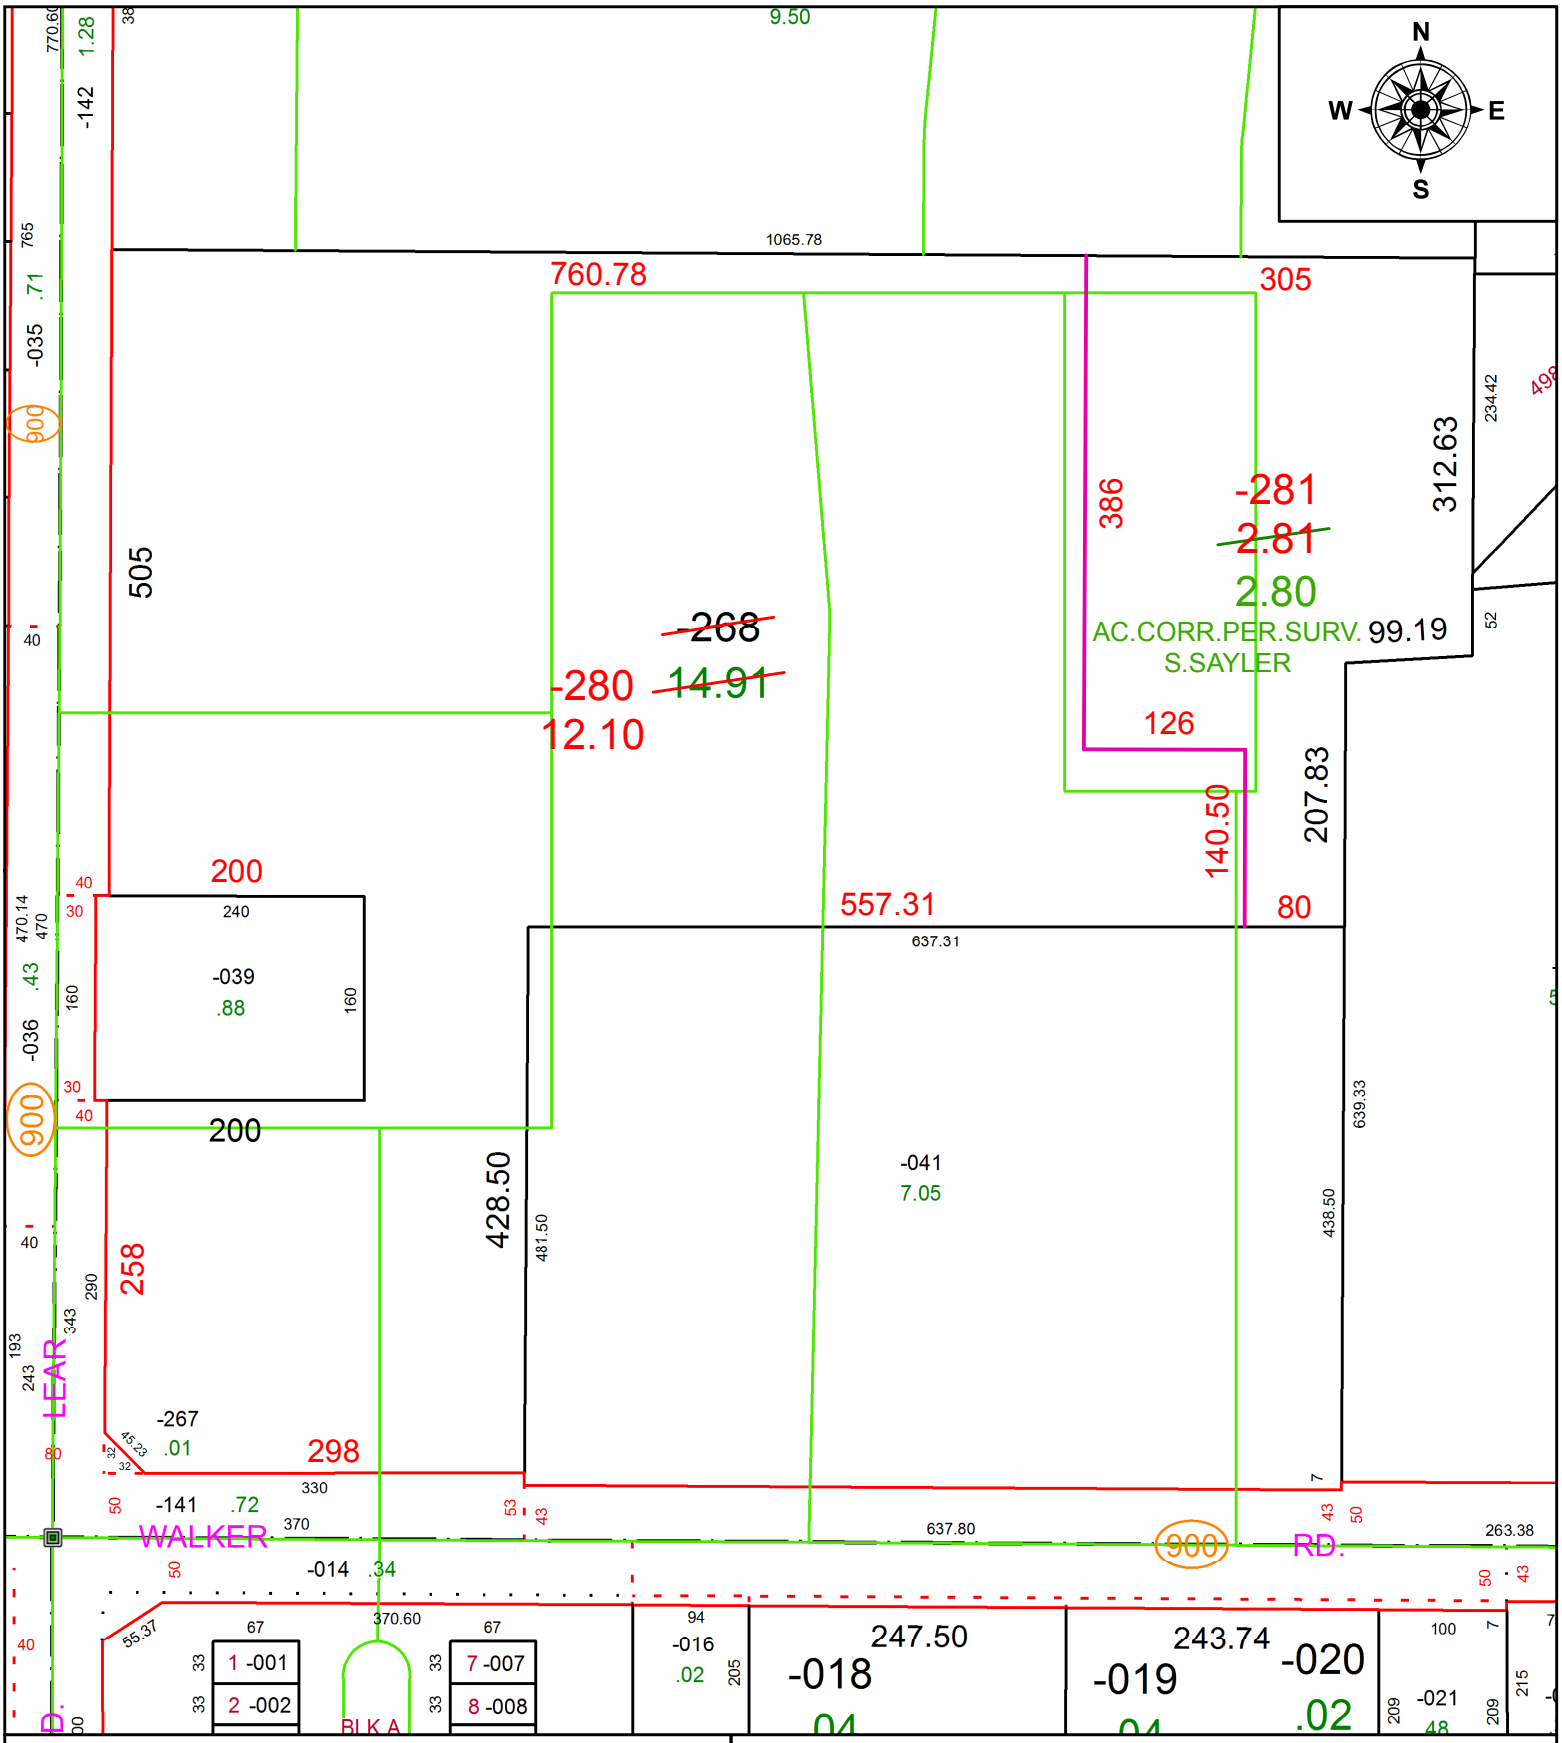

SPLITS/DEEDS PROCESSED

LORAIN COUNTY TAX MAP DEPARTMENT
226 MIDDLE AVE. ELYRIA, OH

SURVEYED BY: STUART W. SAYLER
CLOSURE: 1:1,023,229
MAP PAGE(S): 4-00-030
APPOVED BY: RRM **DATE:** 9-4-20
SCALE: 1" = 150 **PRIOR INSTRUMENT:** 19970496692