PARENT PARCEL: 10-00-006-110-006, -007

CHILD PARCEL: 10-00-006-110-039

STARTING POINT: INTERSECTION OF C/L OF JERROL CT. AND C/L OF GRAFTON RD.

20-04172

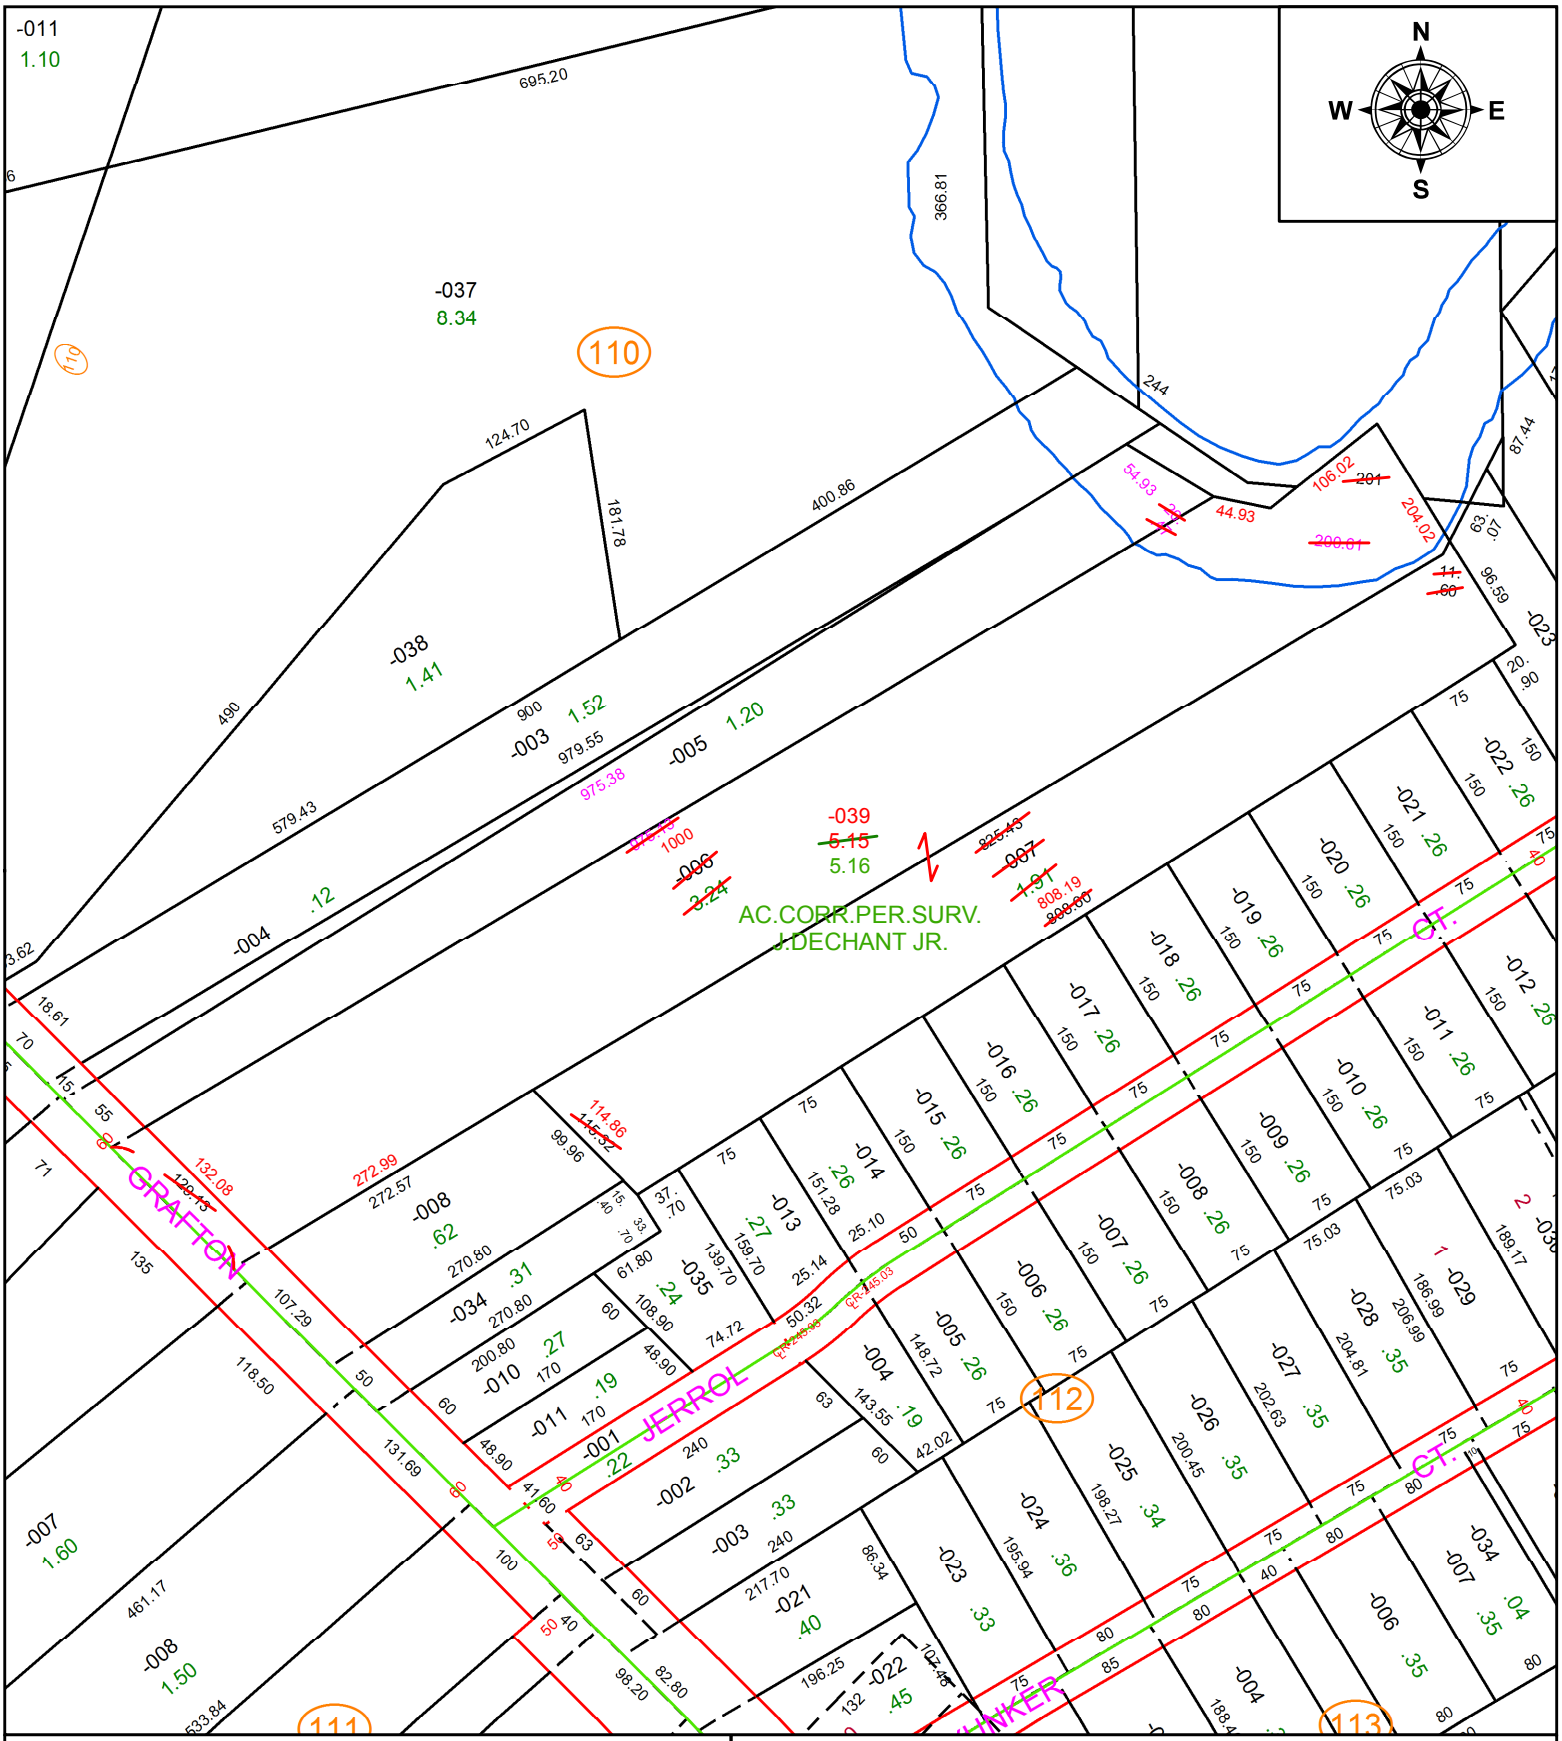

SPLITS/DEEDS PROCESSED

LORAIN COUNTY TAX MAP DEPARTMENT
226 MIDDLE AVE. ELYRIA, OH

SURVEYED BY: JOHN A. DECHANT JR.

CLOSURE: 1:240,948

MAP PAGE(S): 10-00-006

APPOVED BY: RRM **DATE:** 8-25-20

SCALE: 1" = 150 **PRIOR INSTRUMENT:** 20100332293