PARENT PARCEL: 05-00-095-000-013

CHILD PARCEL:

STARTING POINT: INTERSECTION OF C/L OF RICE RD. AND C/L OF QUARRY RD.

19-04177-C

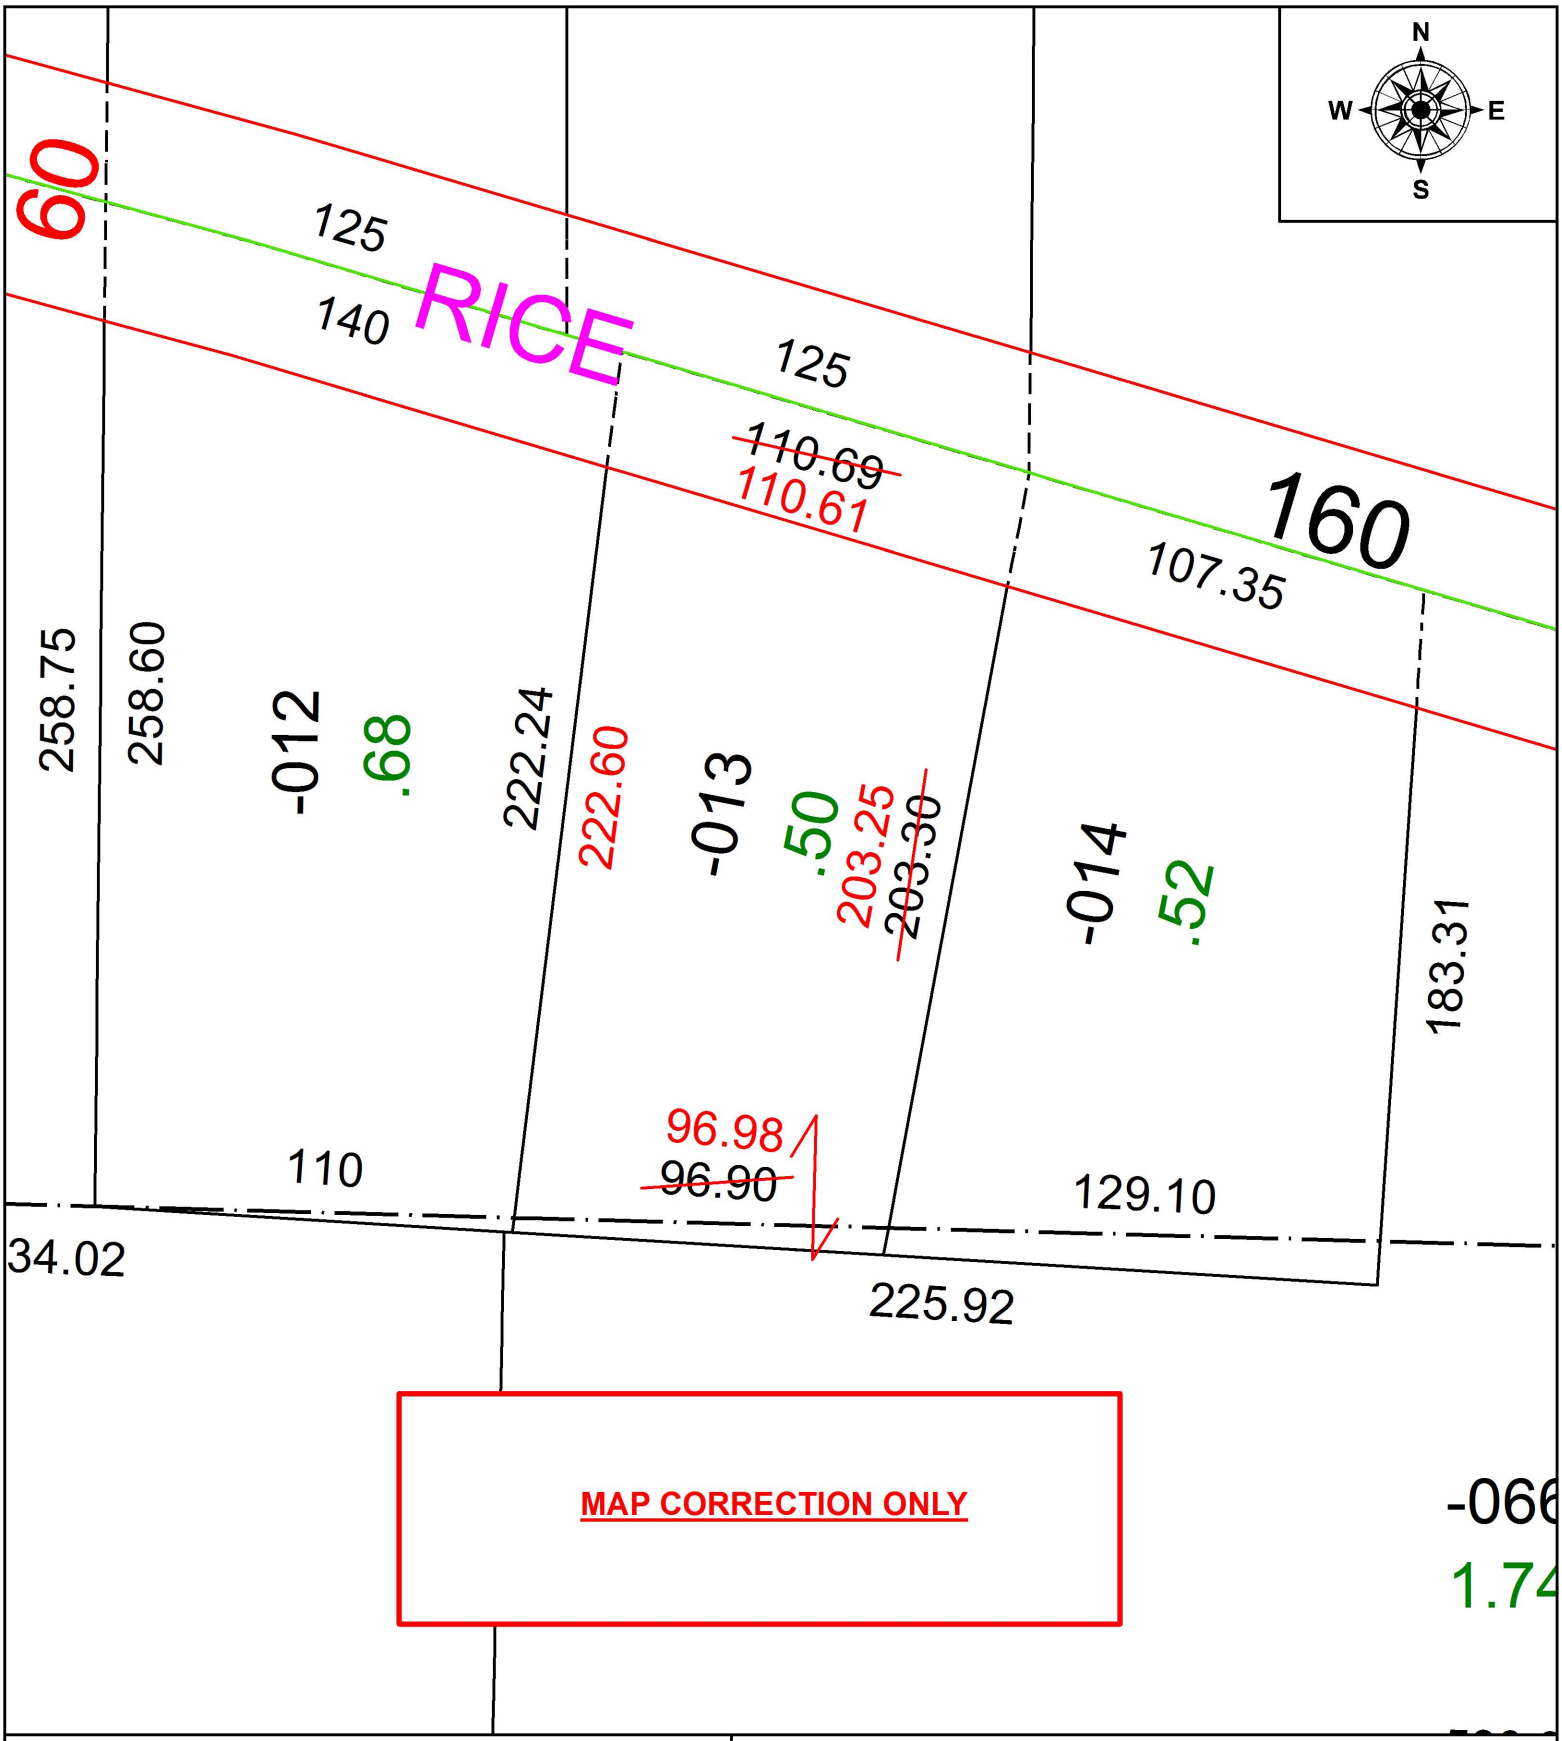

SPLITS/DEEDS PROCESSED

LORAIN COUNTY TAX MAP DEPARTMENT
226 MIDDLE AVE. ELYRIA, OH

SURVEYED BY: SCOTT J. CASEY
CLOSURE: 1:62,188
MAP PAGE(S): 5-00-095
APPOVED BY: RRM **DATE:** 8-27-19
SCALE: 1" = 50 **PRIOR INSTRUMENT:** 20180686256