PARENT PARCEL: 07-00-016-112-045, -050, -051, 07-00-017-130-012, -024, -026

CHILD PARCEL: 07-00-016-112-051, -061 THRU -063, 07-00-017-130-012, -024, -026

STARTING POINT: INTERSECTION OF C/L OF EMERALD ST. AND C/L OF CENTER RIDGE RD.

20-04178

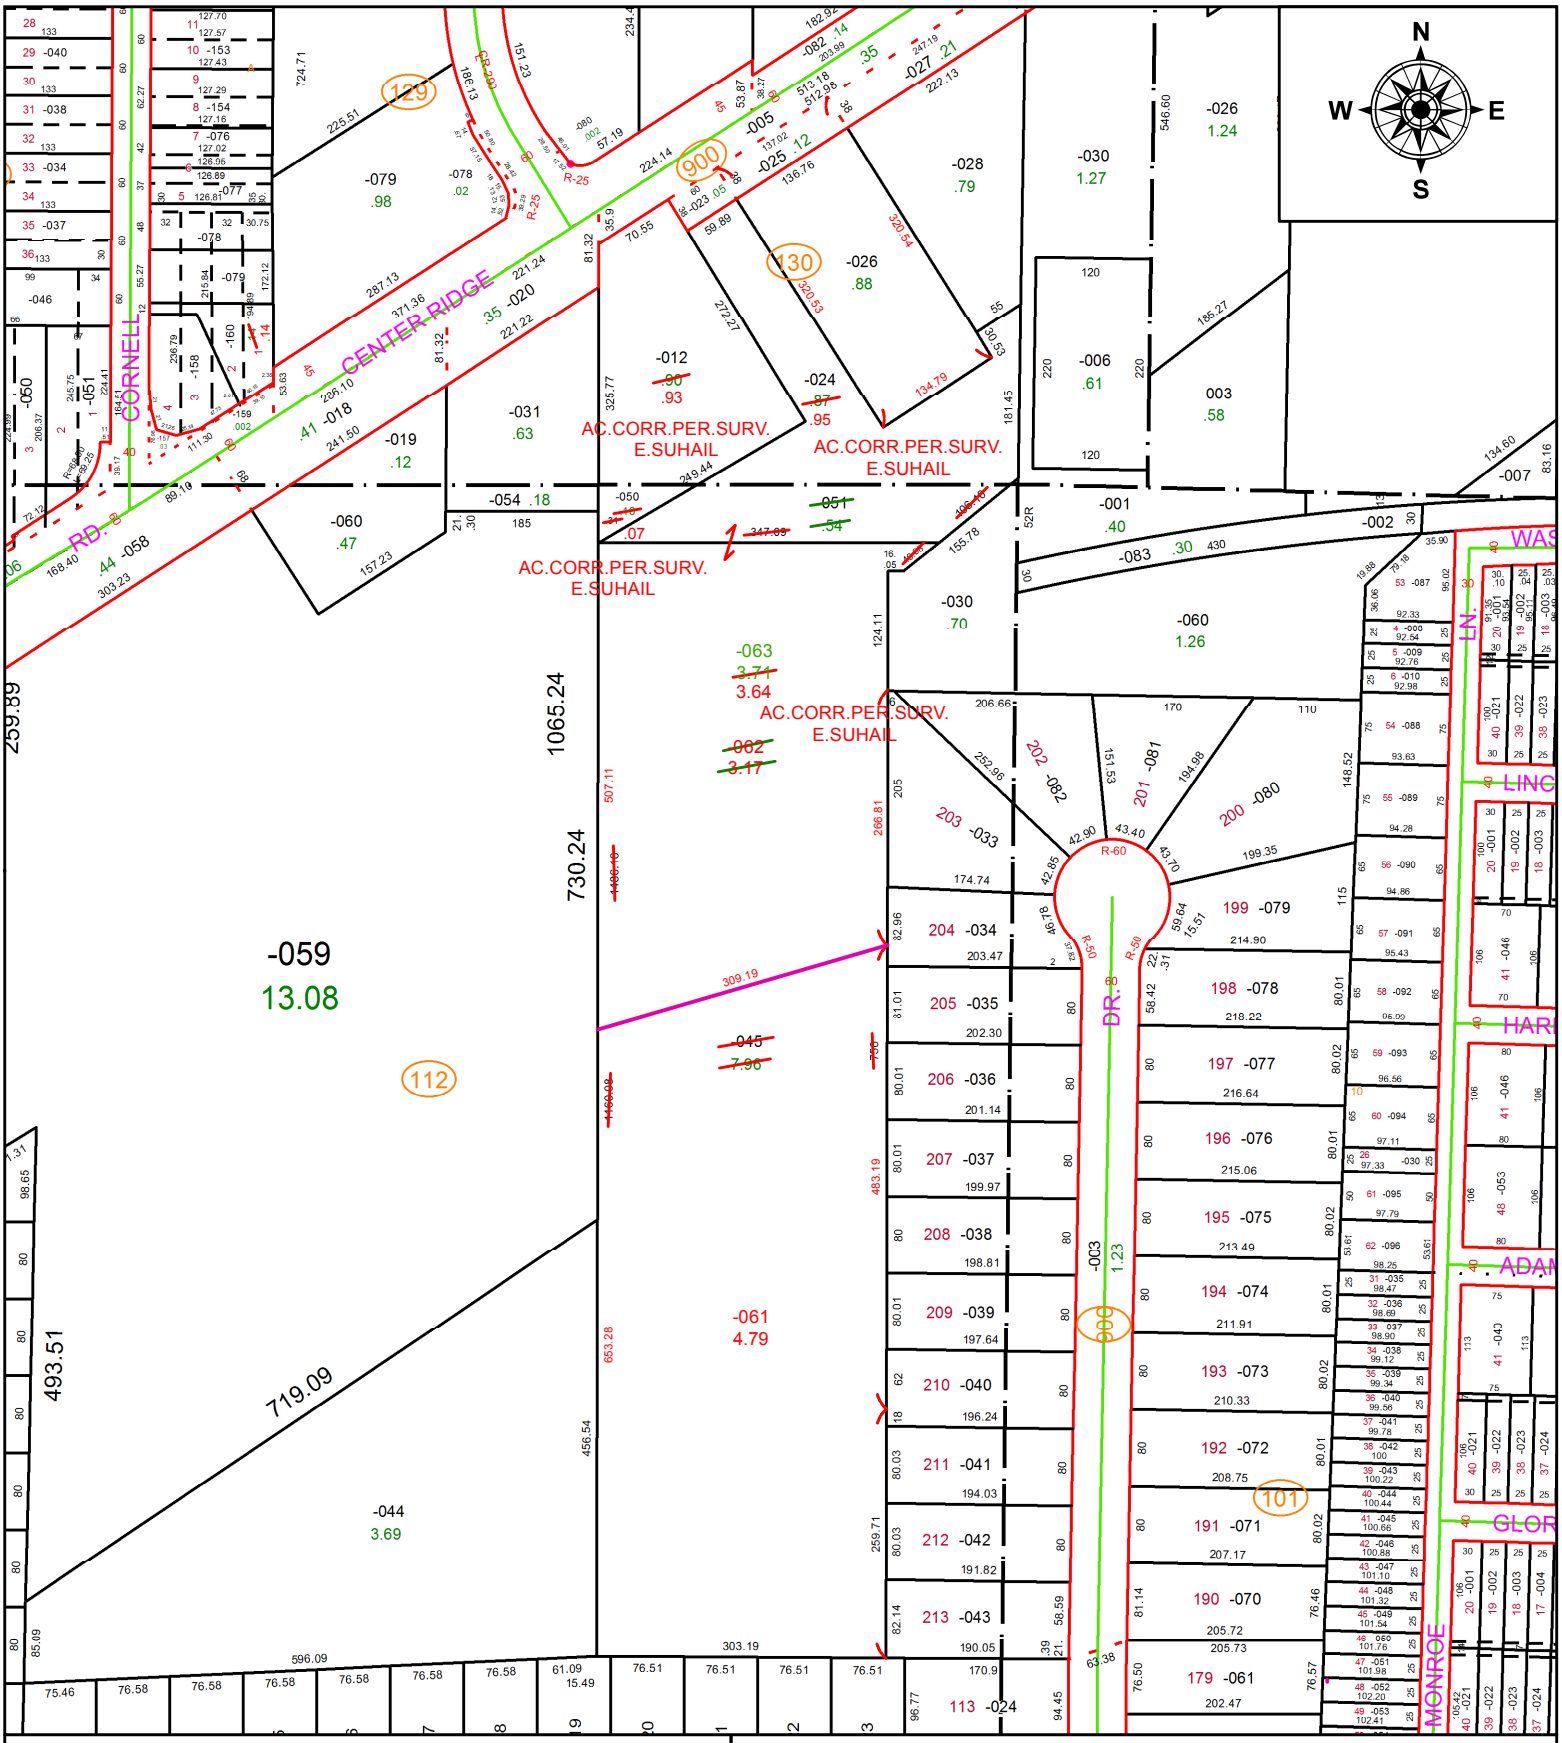

SPLITS/DEEDS PROCESSED

LORAIN COUNTY TAX MAP DEPARTMENT
226 MIDDLE AVE. ELYRIA, OH

SURVEYED BY: EHTESHAM M. SUHAIL
CLOSURE: 1:3,525,840
MAP PAGE(S): 7-00-016
APPOVED BY: RRM **DATE:** 10-7-20
SCALE: 1" = 200 **PRIOR INSTRUMENT:** 20130454442