PARENT PARCEL: 10-00-017-000-071

CHILD PARCEL: 10-00-017-000-072 THRU -074

STARTING POINT: INTERSECTION OF C/L OF SLIFE RD. AND WEST LINE OF SEC. 17

20-04181

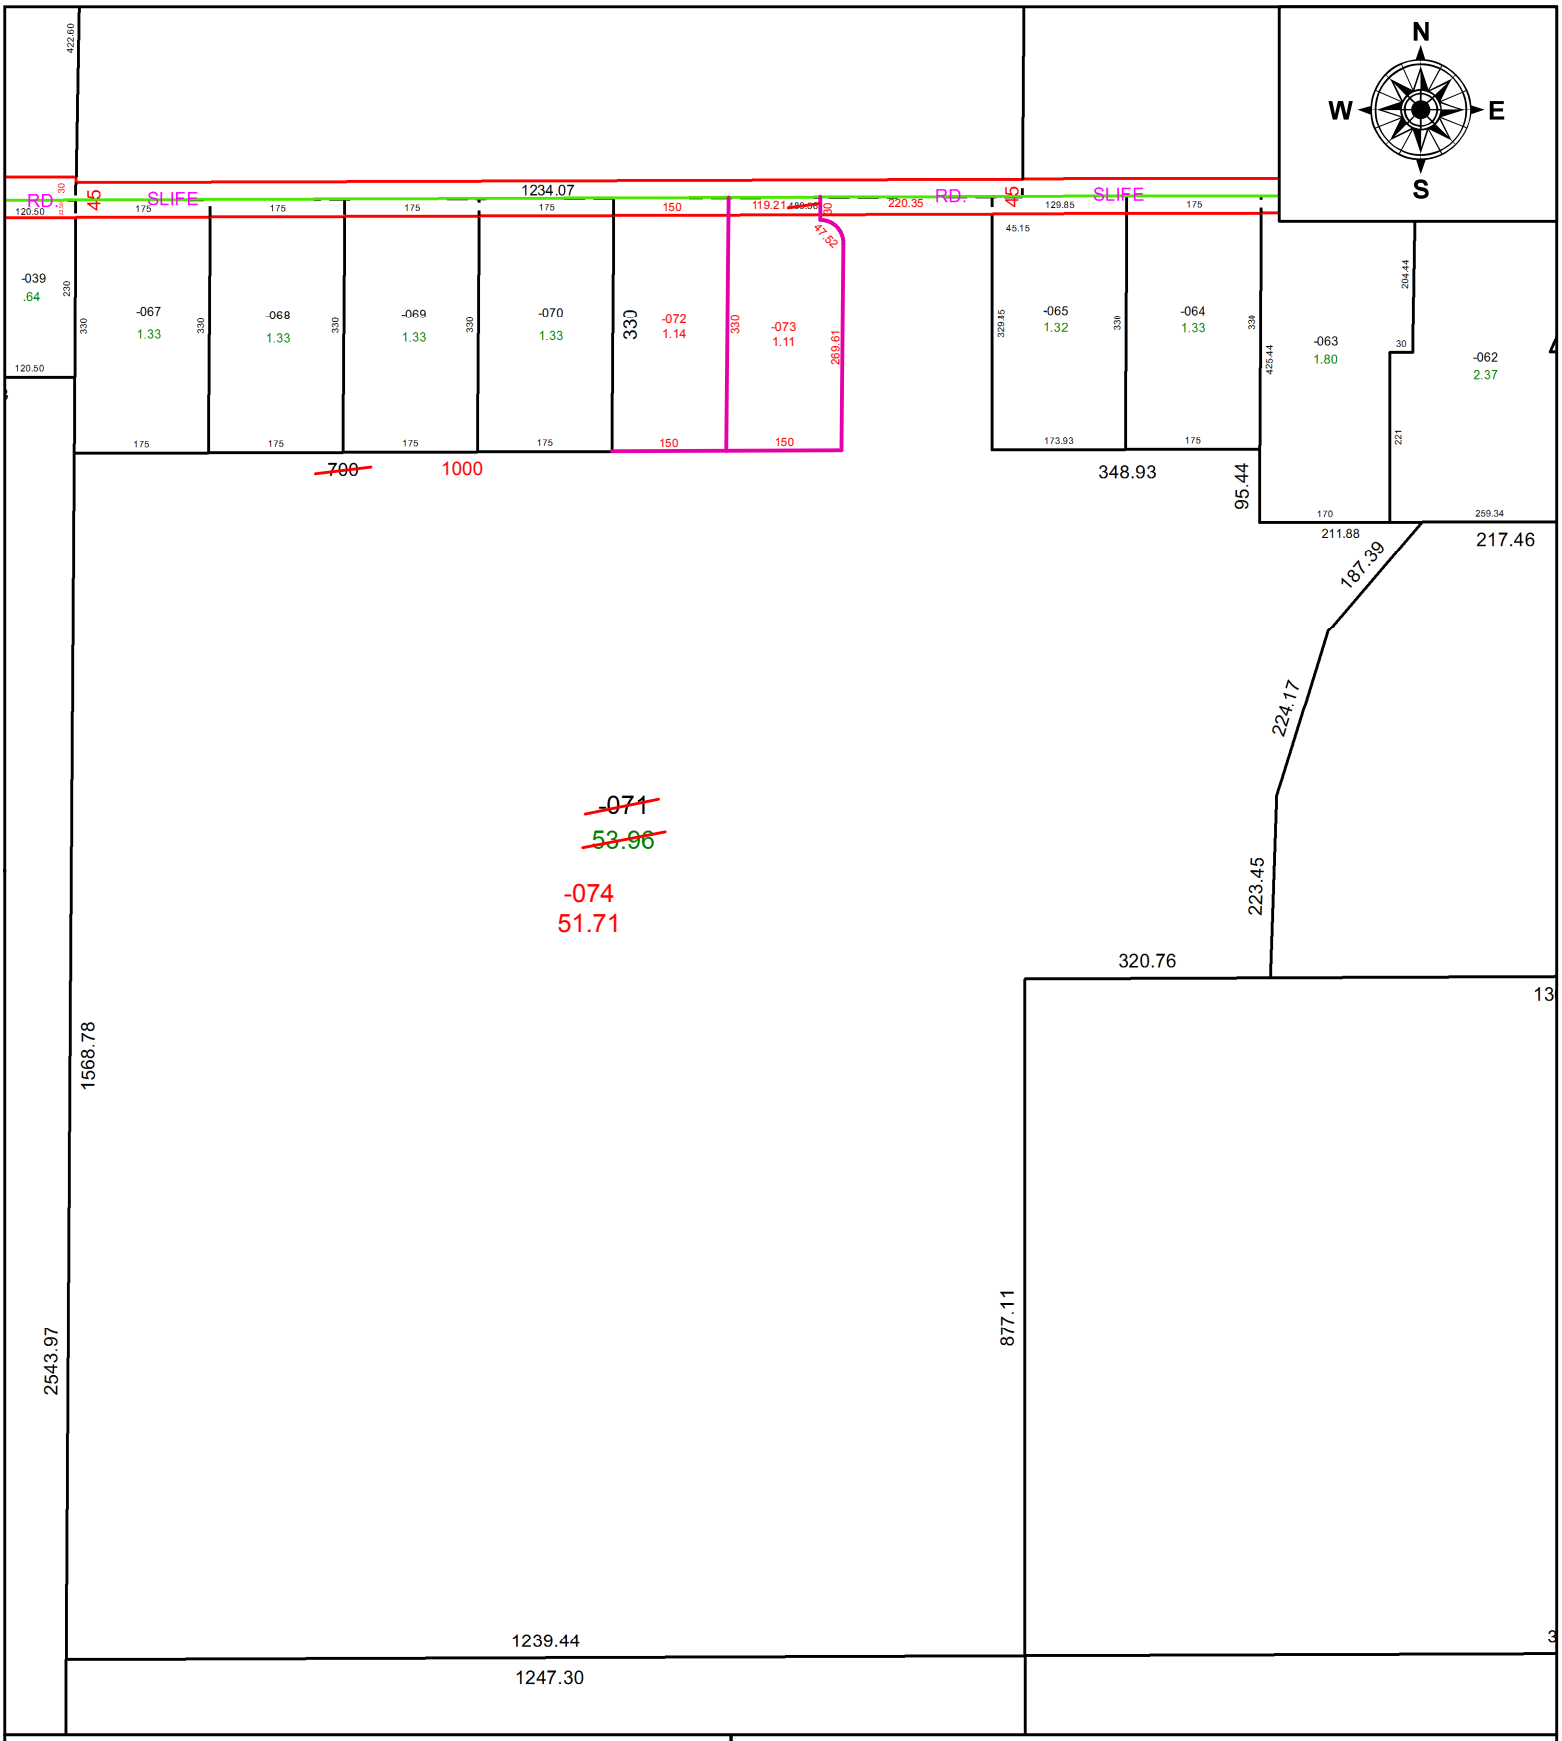

SPLITS/DEEDS PROCESSED

LORAIN COUNTY TAX MAP DEPARTMENT
226 MIDDLE AVE. ELYRIA, OH

SURVEYED BY: THOMAS A. SIMON
CLOSURE: 1:116,676
MAP PAGE(S): 10-00-017
APPOVED BY: RRM **DATE:** 9-21-20
SCALE: 1" = 250 **PRIOR INSTRUMENT:** 20200762358